


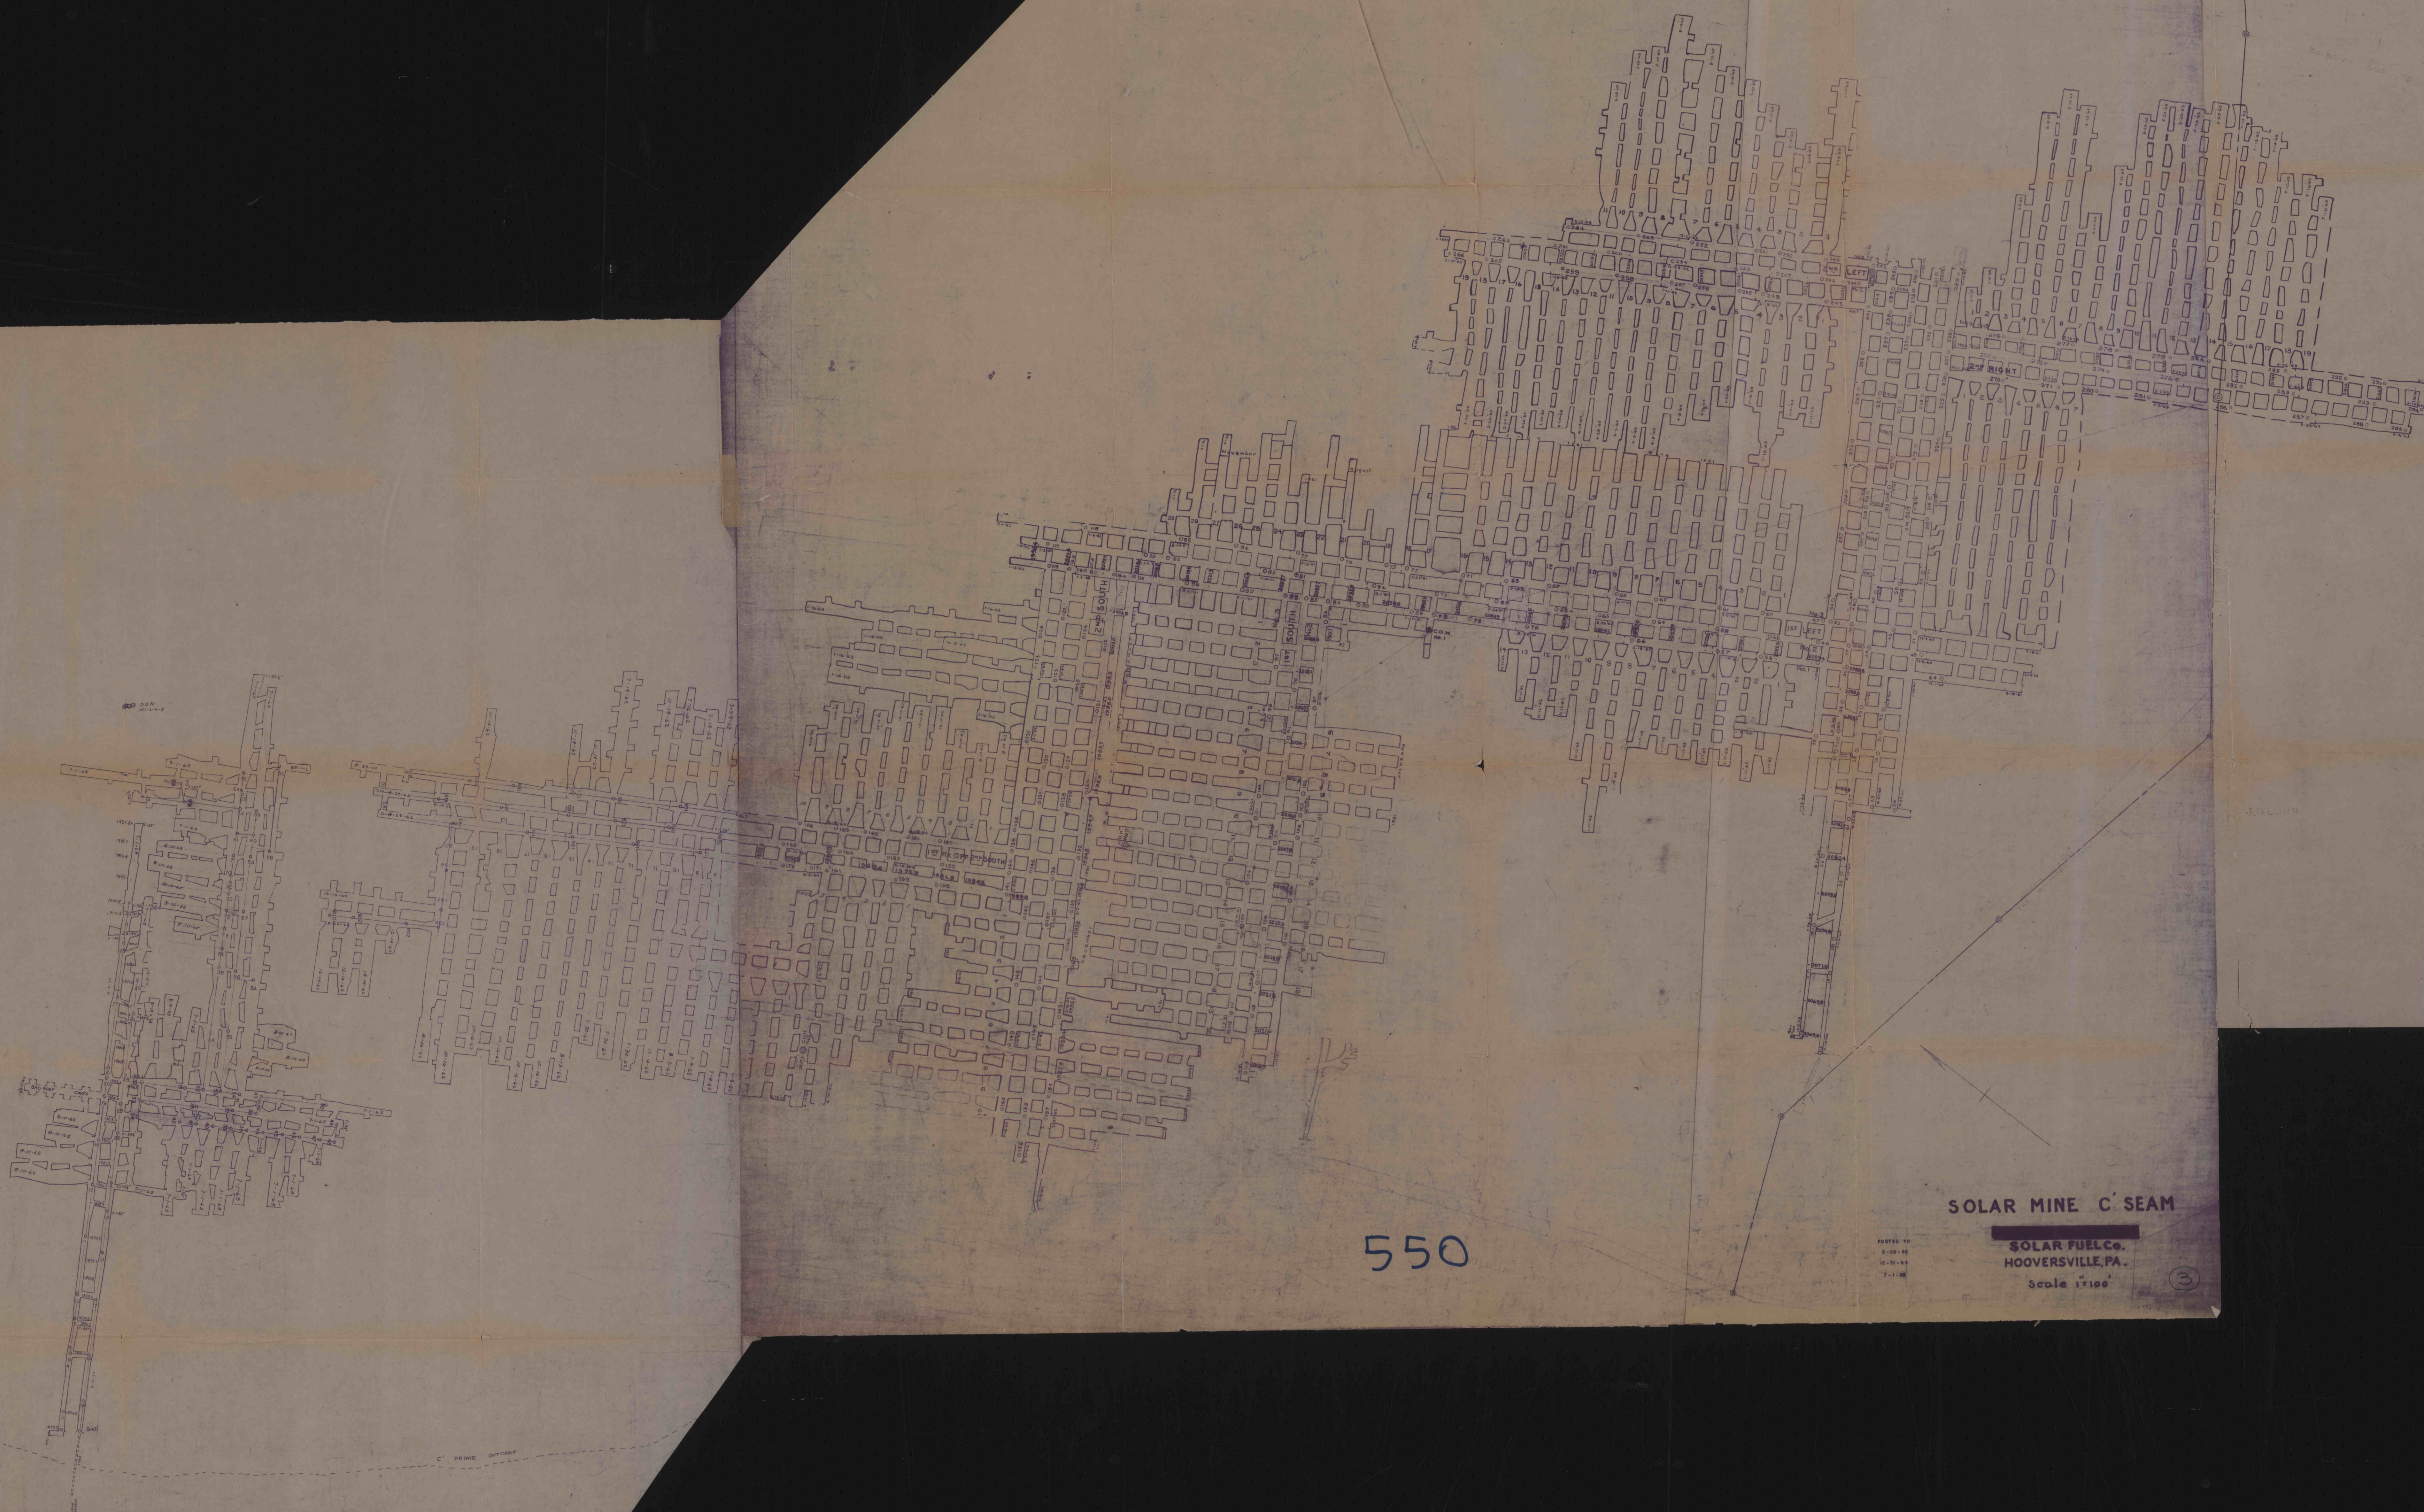

550

SOLAR MINE C' SEAM

SOLAR FUEL Co.
HOOVERVILLE, PA.

Scale 1"=100'

3