


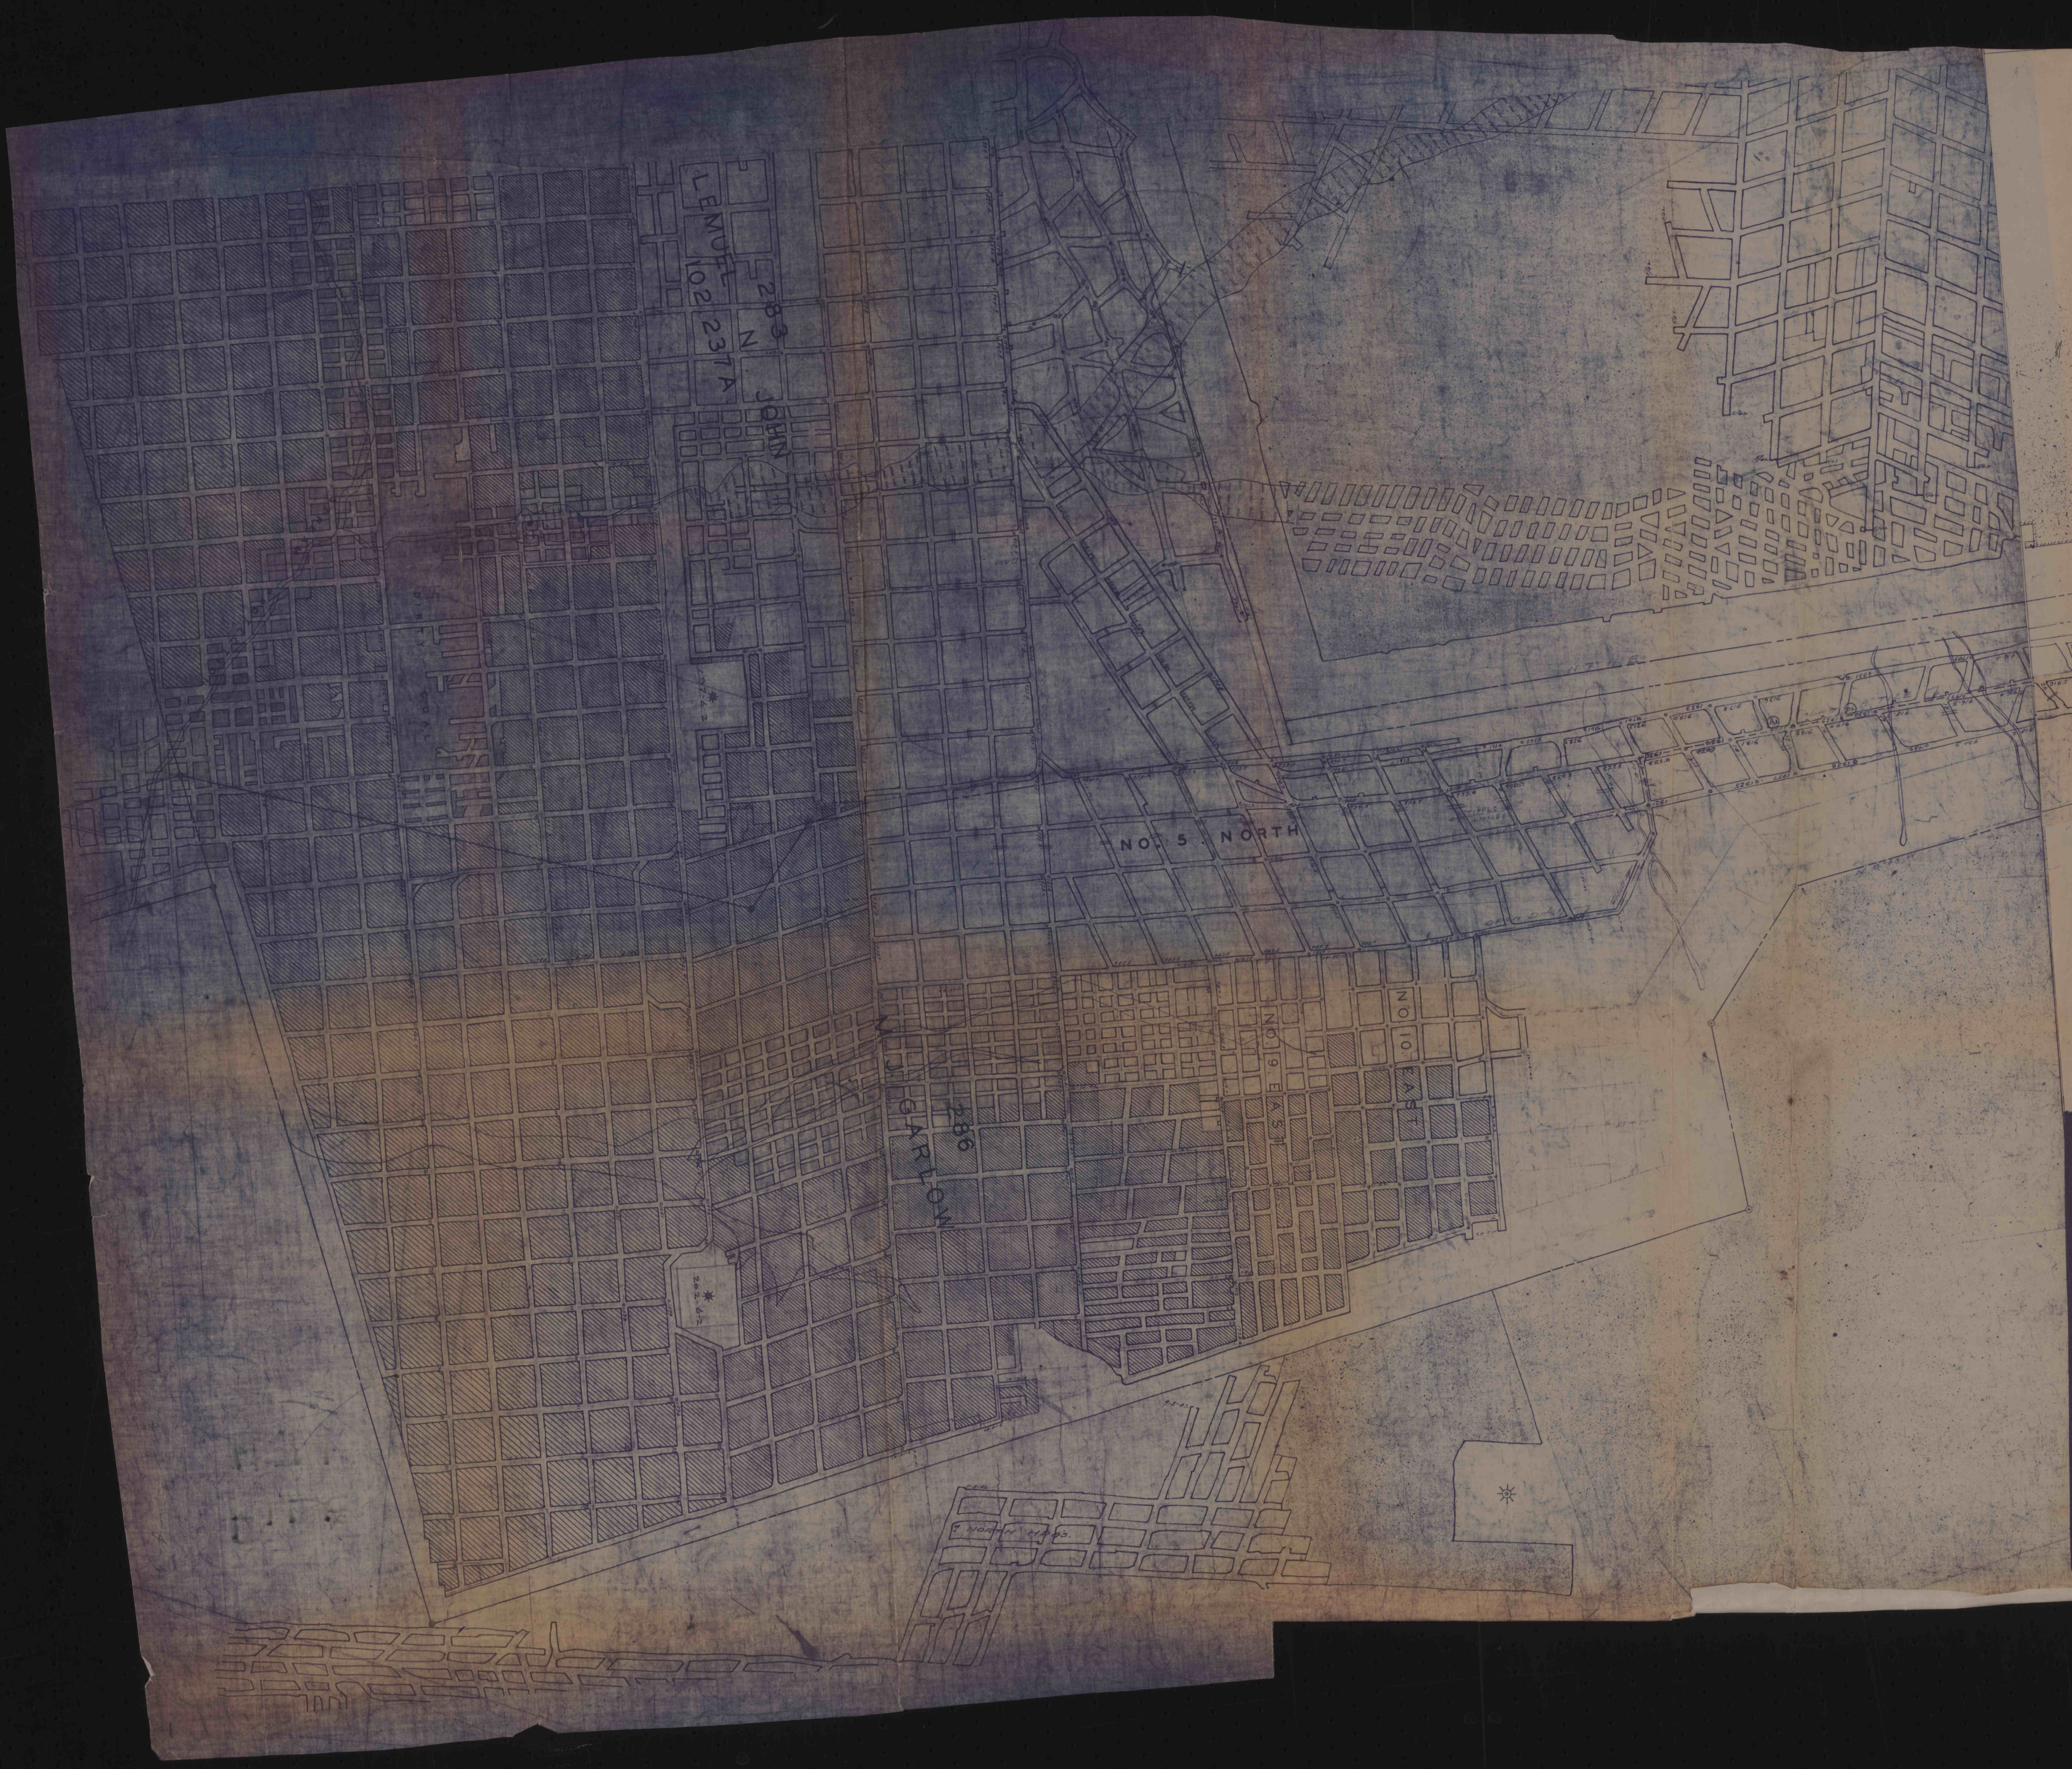

FILE 471