


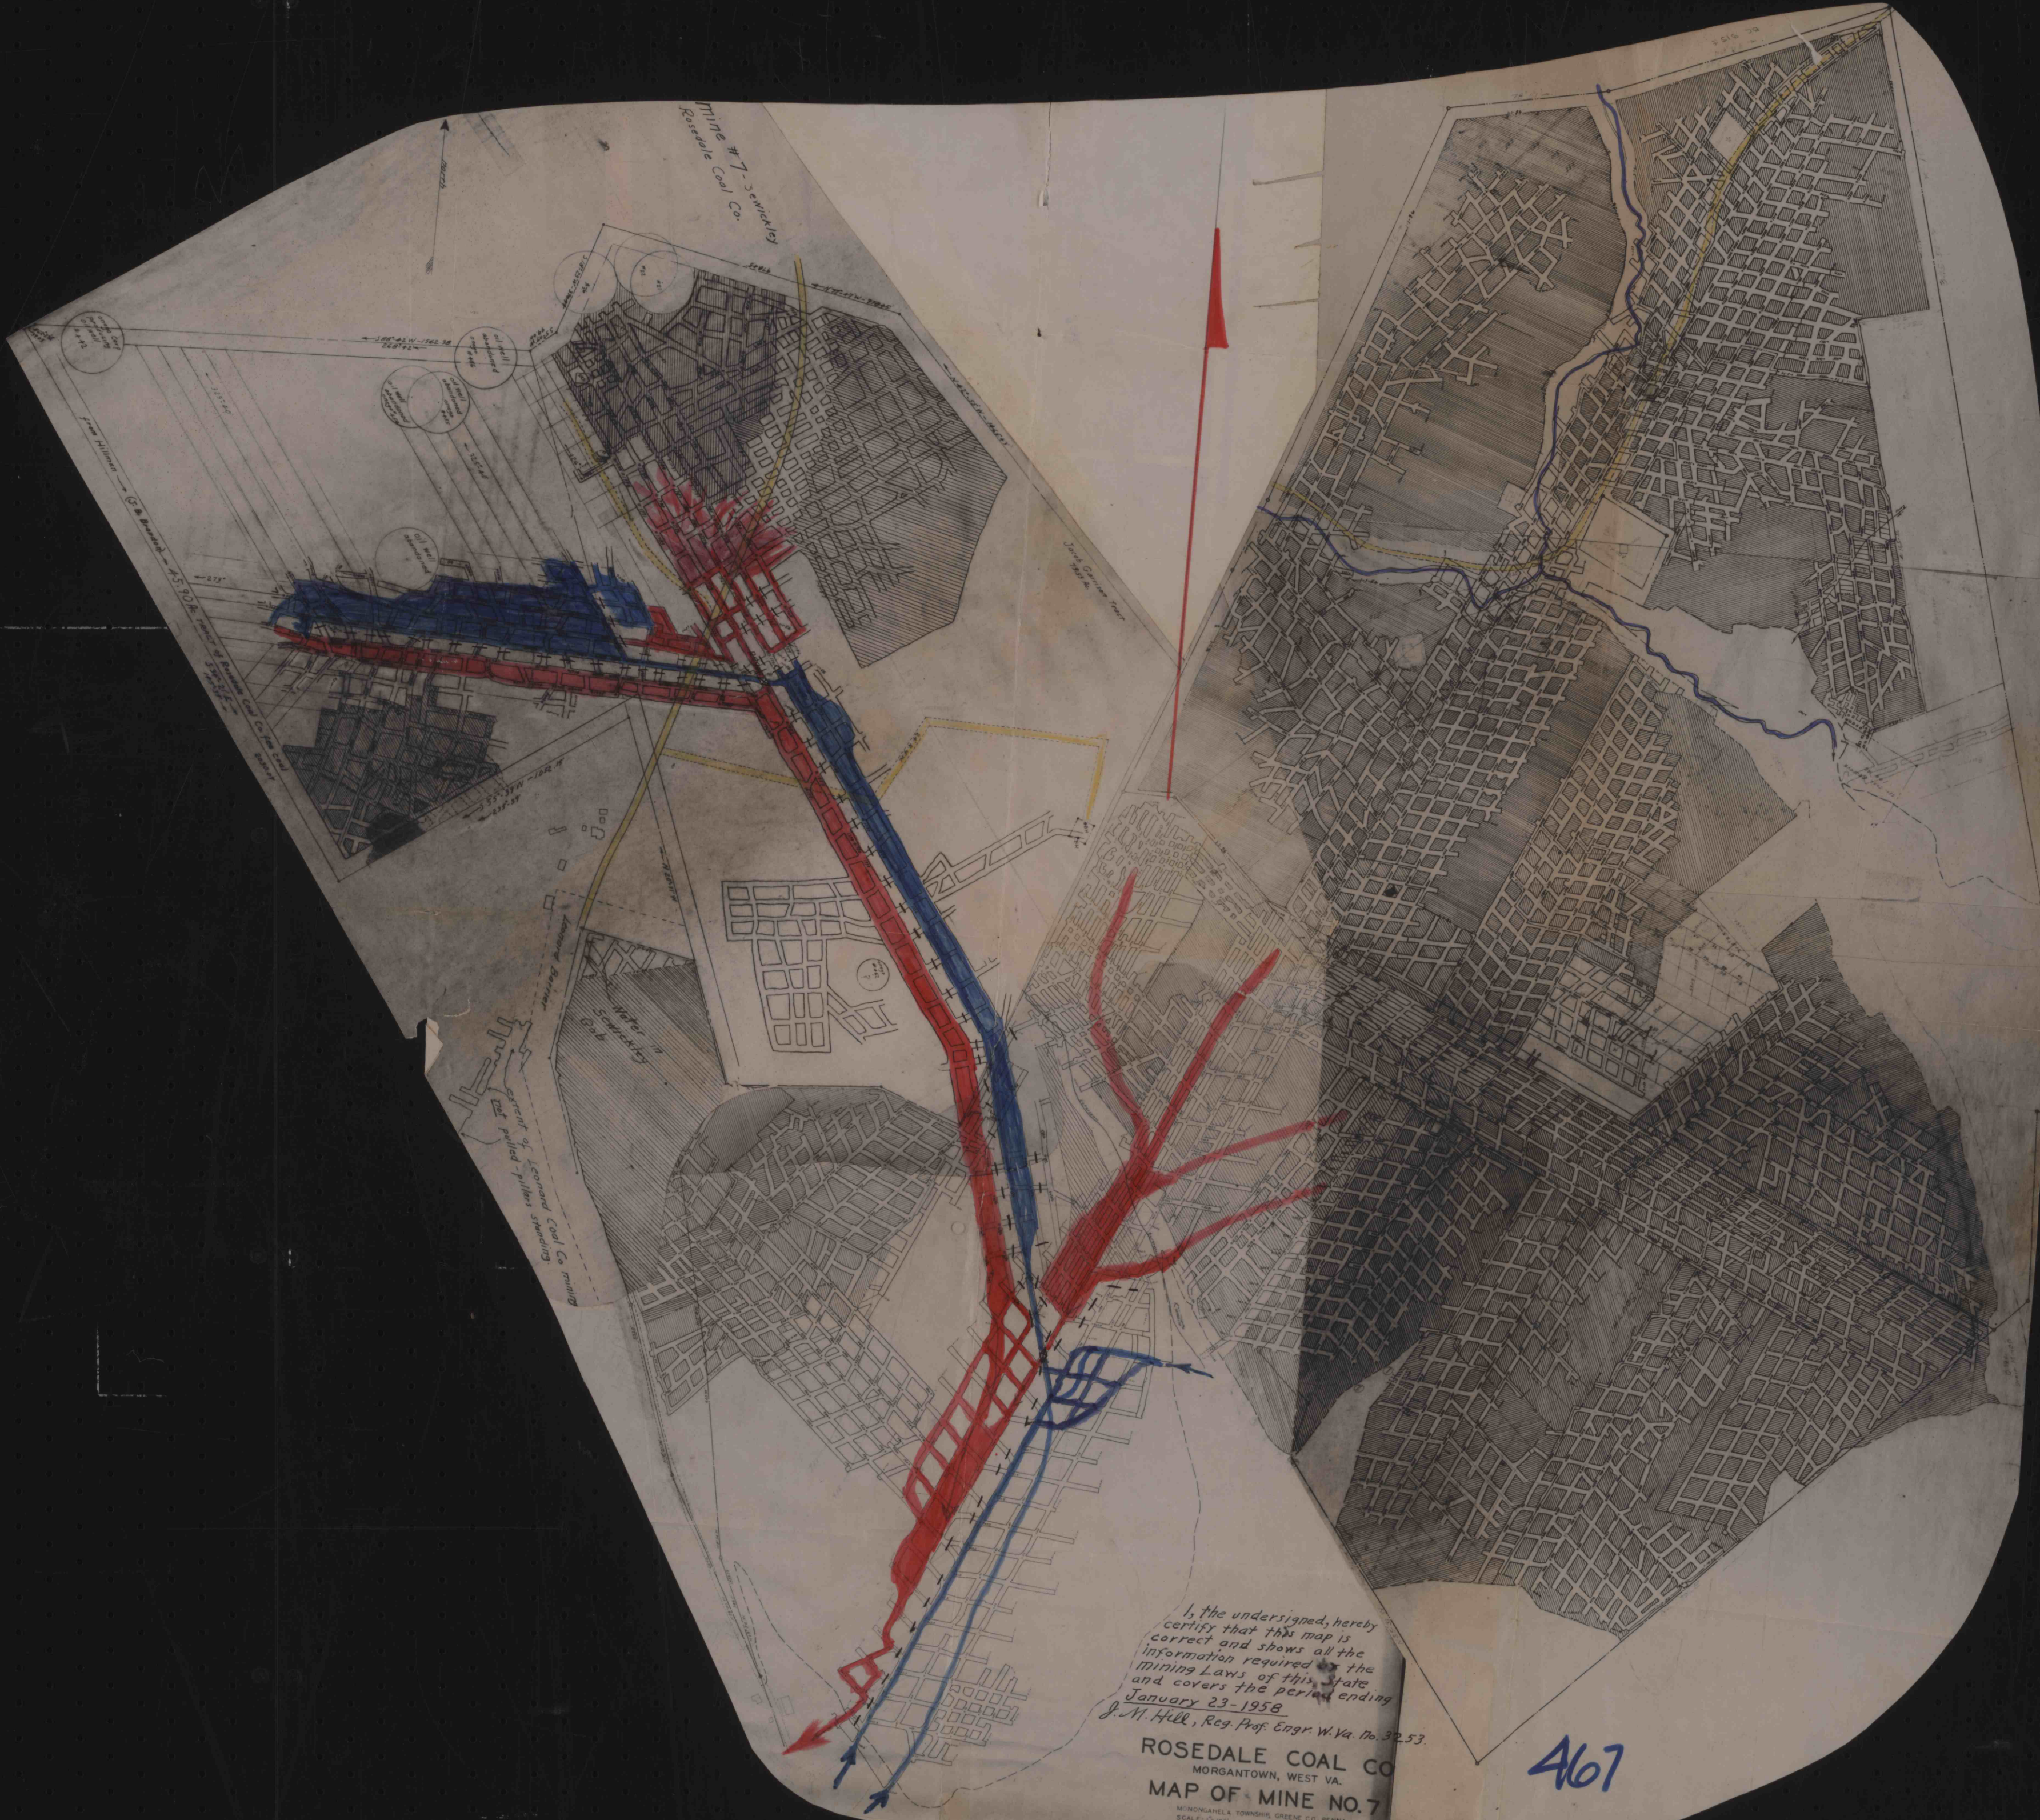

I, the undersigned, hereby
certify that this map is
correct and shows all the
information required by the
Mining Laws of this State
and covers the period ending
January 23-1958
J. M. Hill, Reg. Prof. Engr. W. Va. No. 3253.

ROSEDALE COAL CO
MORGANTOWN, WEST VA.
MAP OF MINE NO. 7
MINONGAHELA TOWNSHIP, GREENE CO., PENNA.
SCALE: 1" = 100'
EXTENSION OF MINE

467