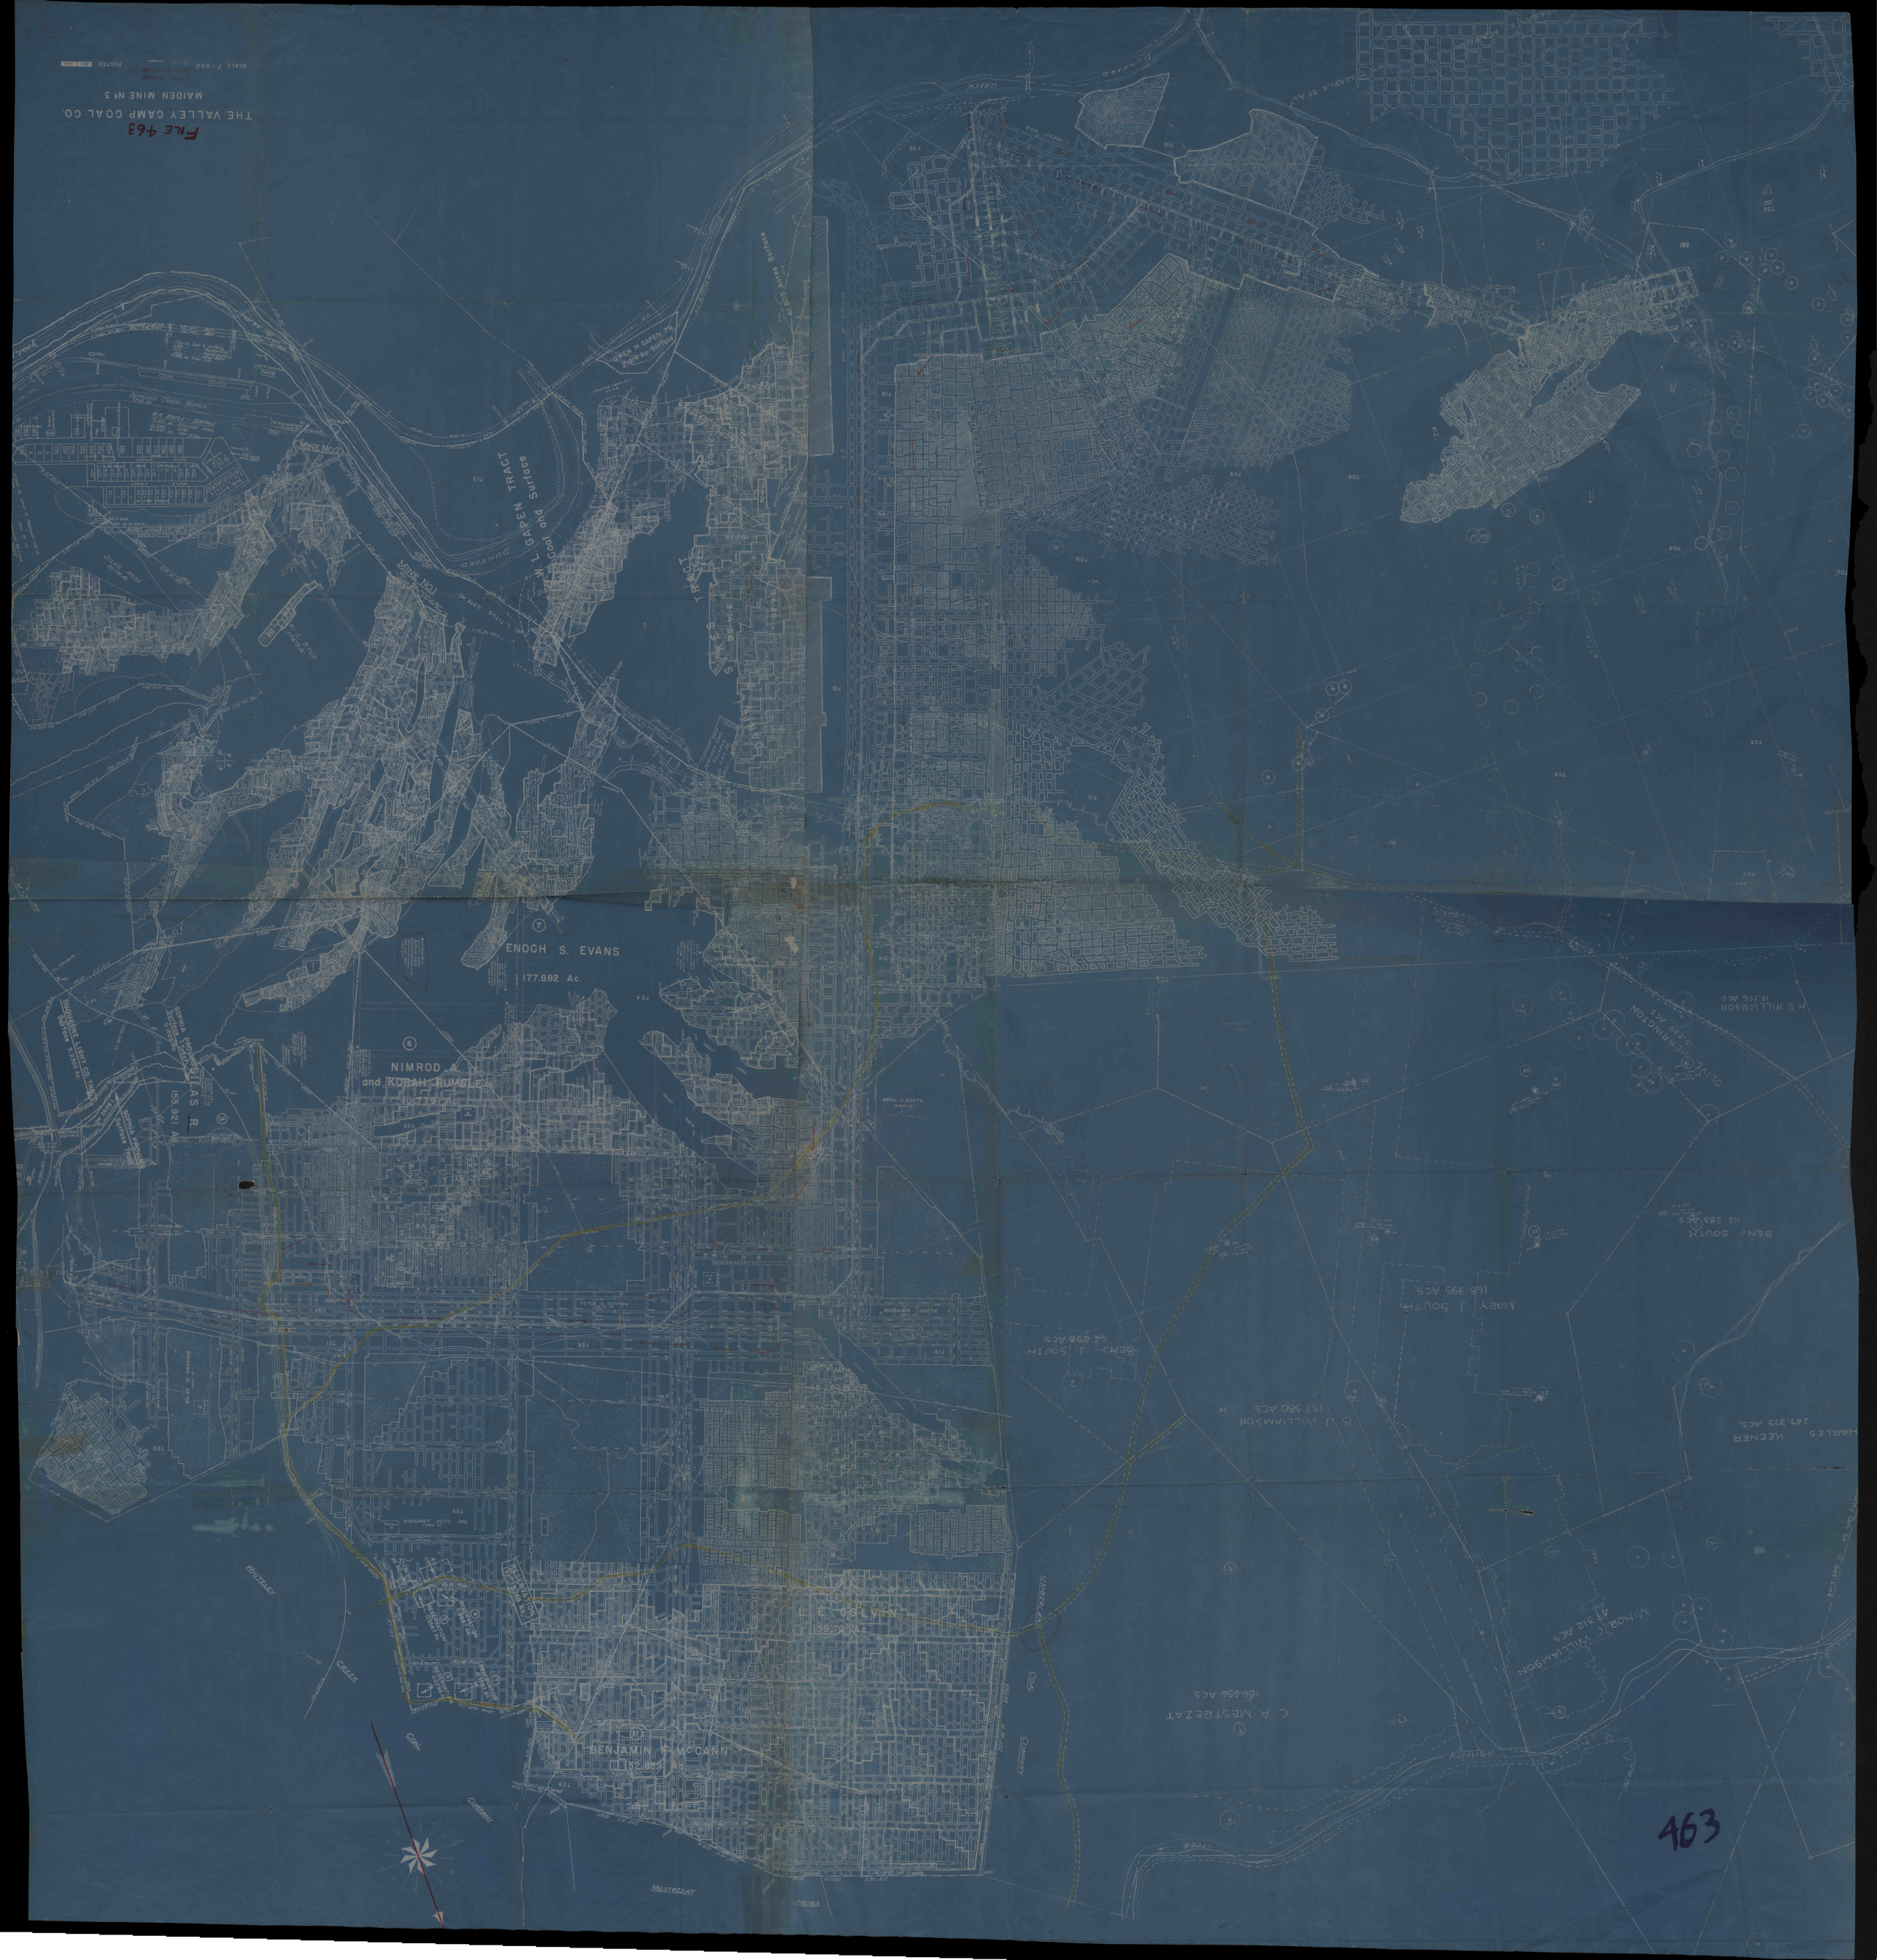
File 463
THE VALLEY CAMP COAL CO.
MAIDEN MINE No 3
SCALE 1" = 200'
POSTED
MINE No 2
MINE No 1
W. L. GAPEN TRACT
Surface
Coal Pillar
QUEEN M. GAPEN TR.
Surface
ENOCH S. EVANS
177.882 Ac.
NIMROD A.
and KORAH RUMBLE
SOPHIA PROVINCE
DUQUESNE LIGHT CO. TRACT
Surface 3.4203 Ac.
SILAS R.
155.921 Ac.
PETER E. DONHAM
BENJAMIN SOUTH
MARGARET REITZ HRS.
BENJAMIN F. McCANN
152.369
E. C. SELVIN
159.7 Ac.
DUNKARD
CREEK
COAL
COMPANY
WHITELEY
MELSTEZAT
HEIRS
BENJ. SOUTH
112 283 ACS
H S WILLIAMSON
18.356 ACS
OLIVE WEARINGTON
15.220 ACS
MAEY J SOUTH
168 395 ACS
BENJ. J SOUTH
64.298 ACS
B U WILLIAMSON
137 300 ACS
C. A. MESTREZAT
186 656 ACS
MINOR C WILLIAMSON
47 312 ACS
HARLES KEENER
247.313 ACS.