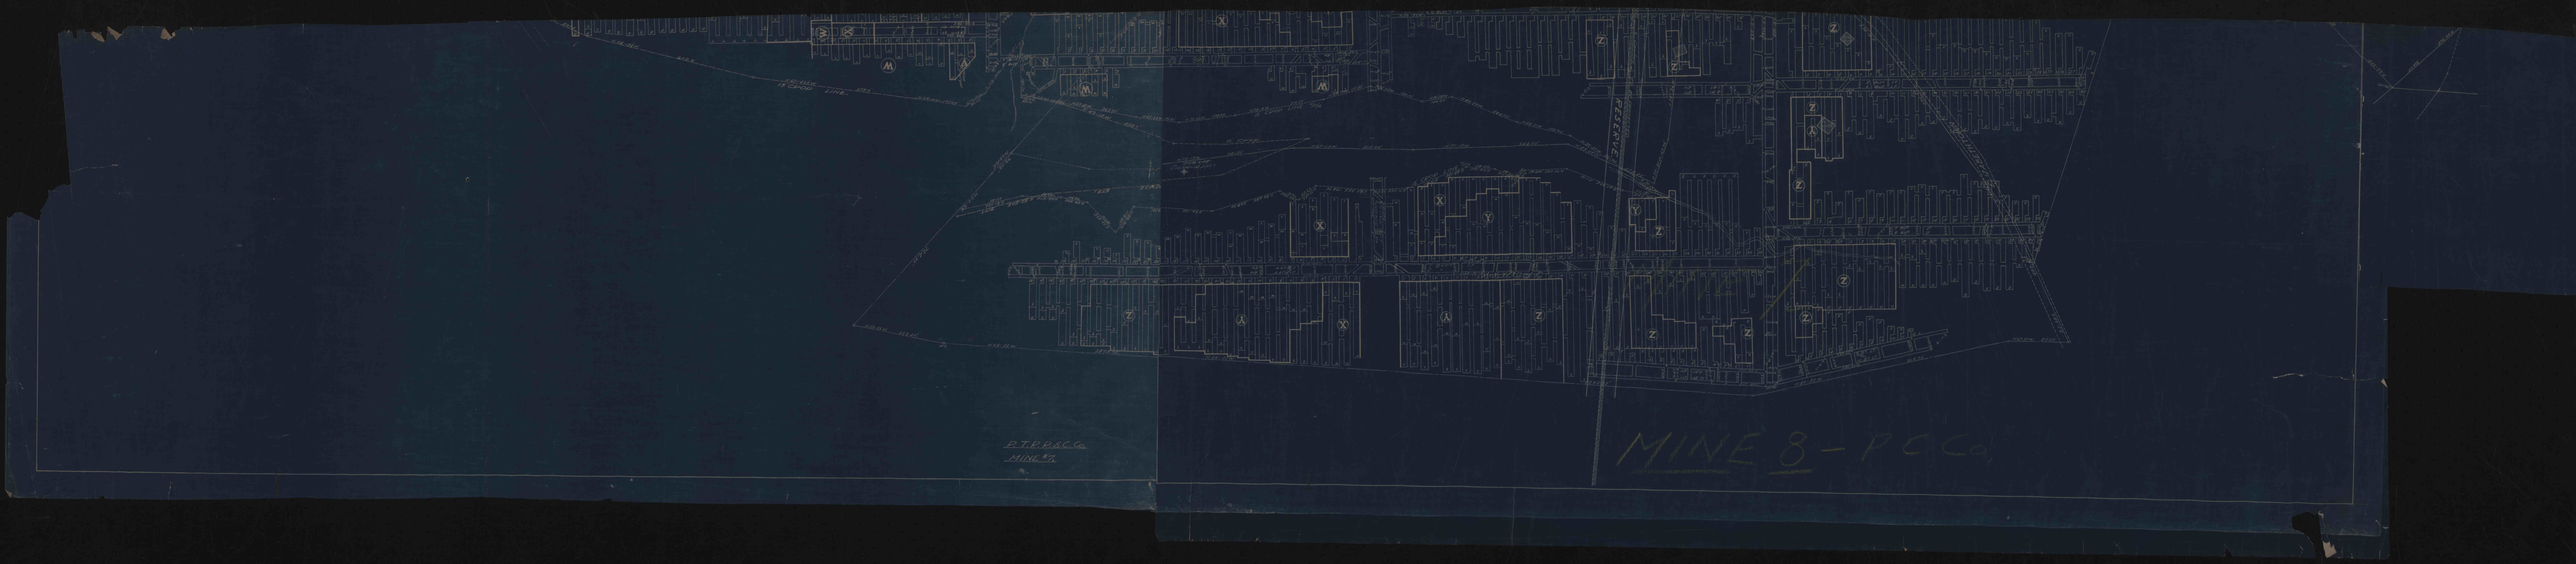
MINE 8 - P.C.C.
P.T.R.R.&C.Co
MINE No 7