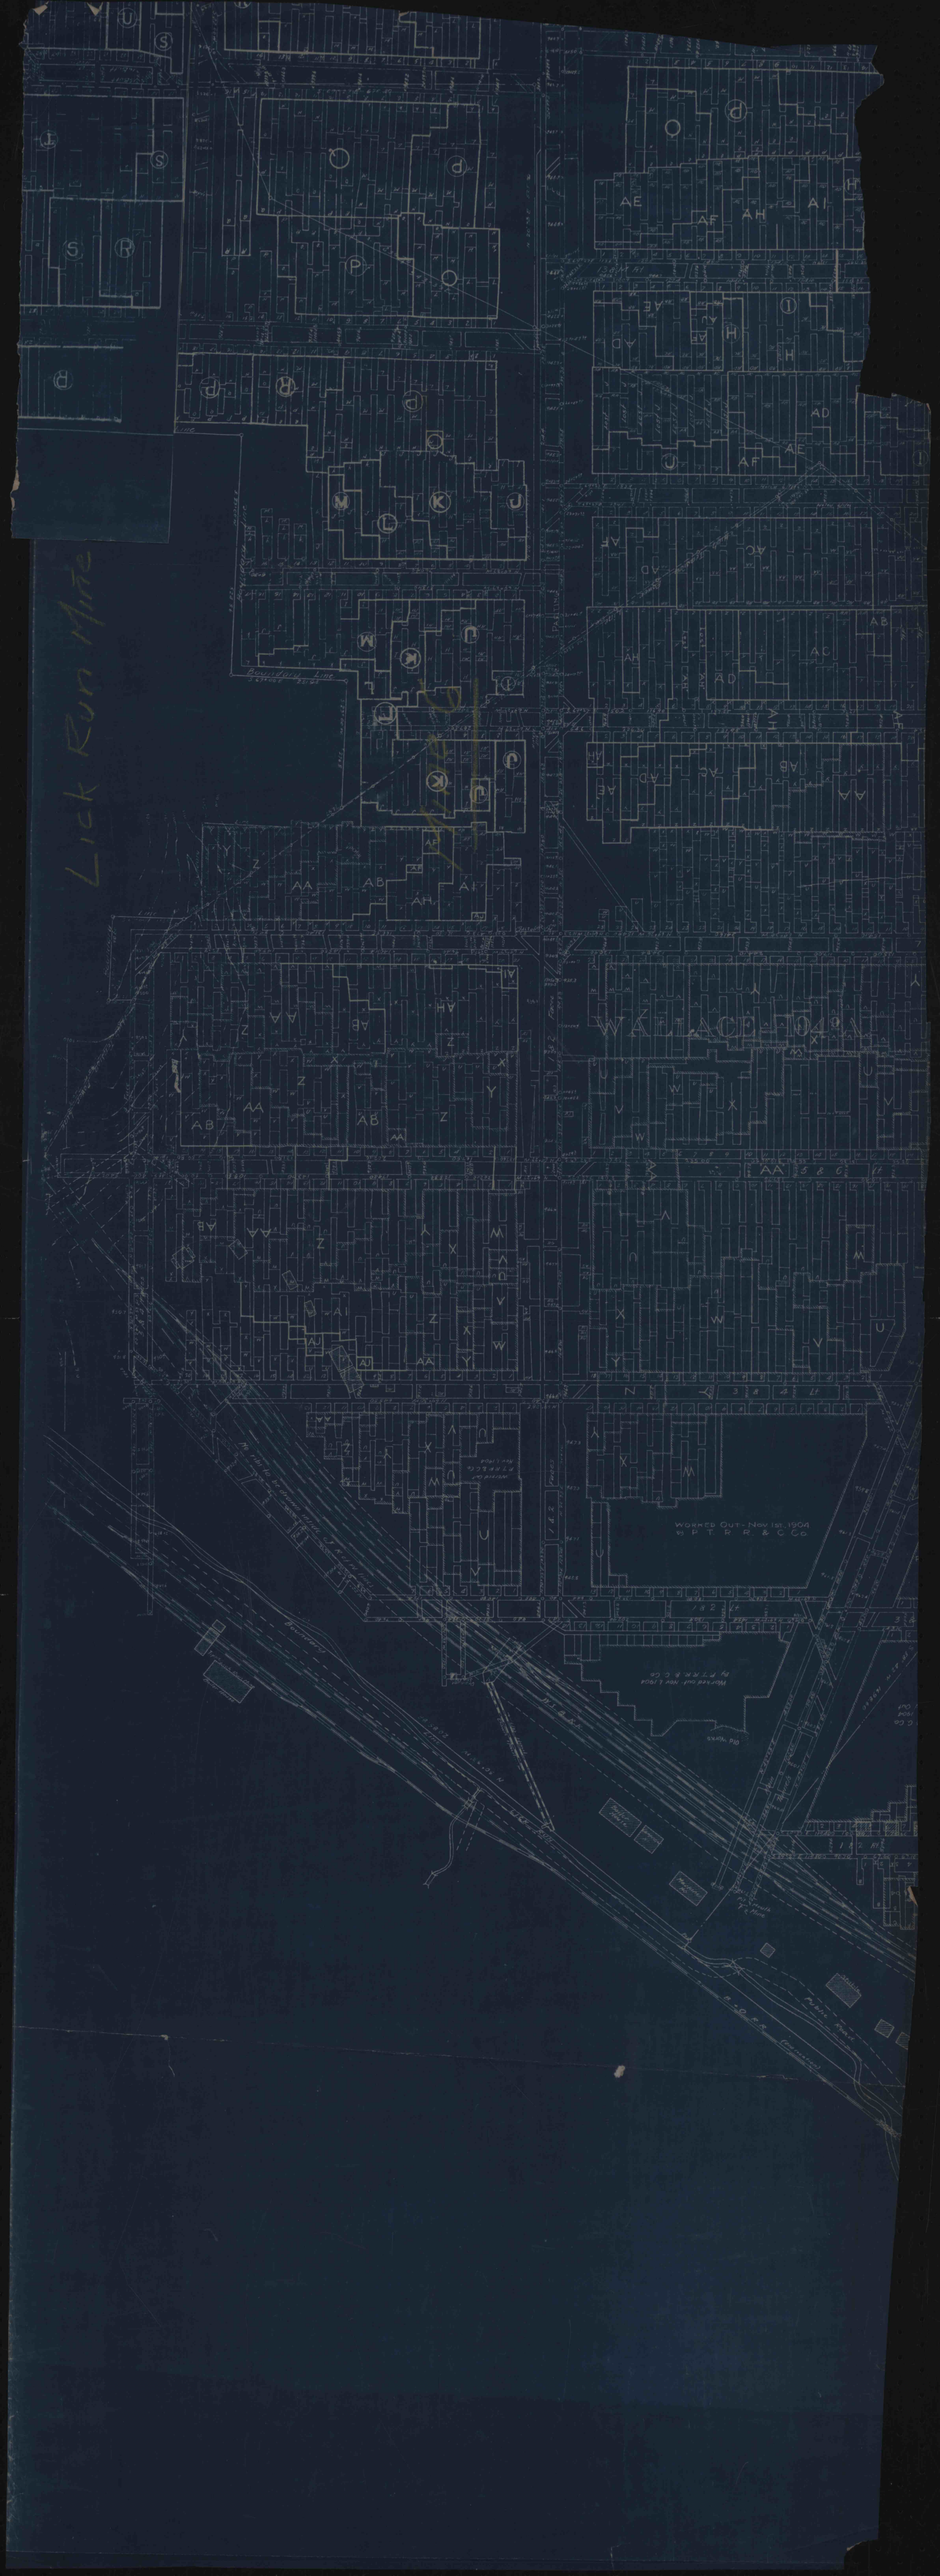
Lick Run Mine
WALLACETOWN
Worked Out - Nov 10, 1904
by P. T. R. R. & C. Co.