


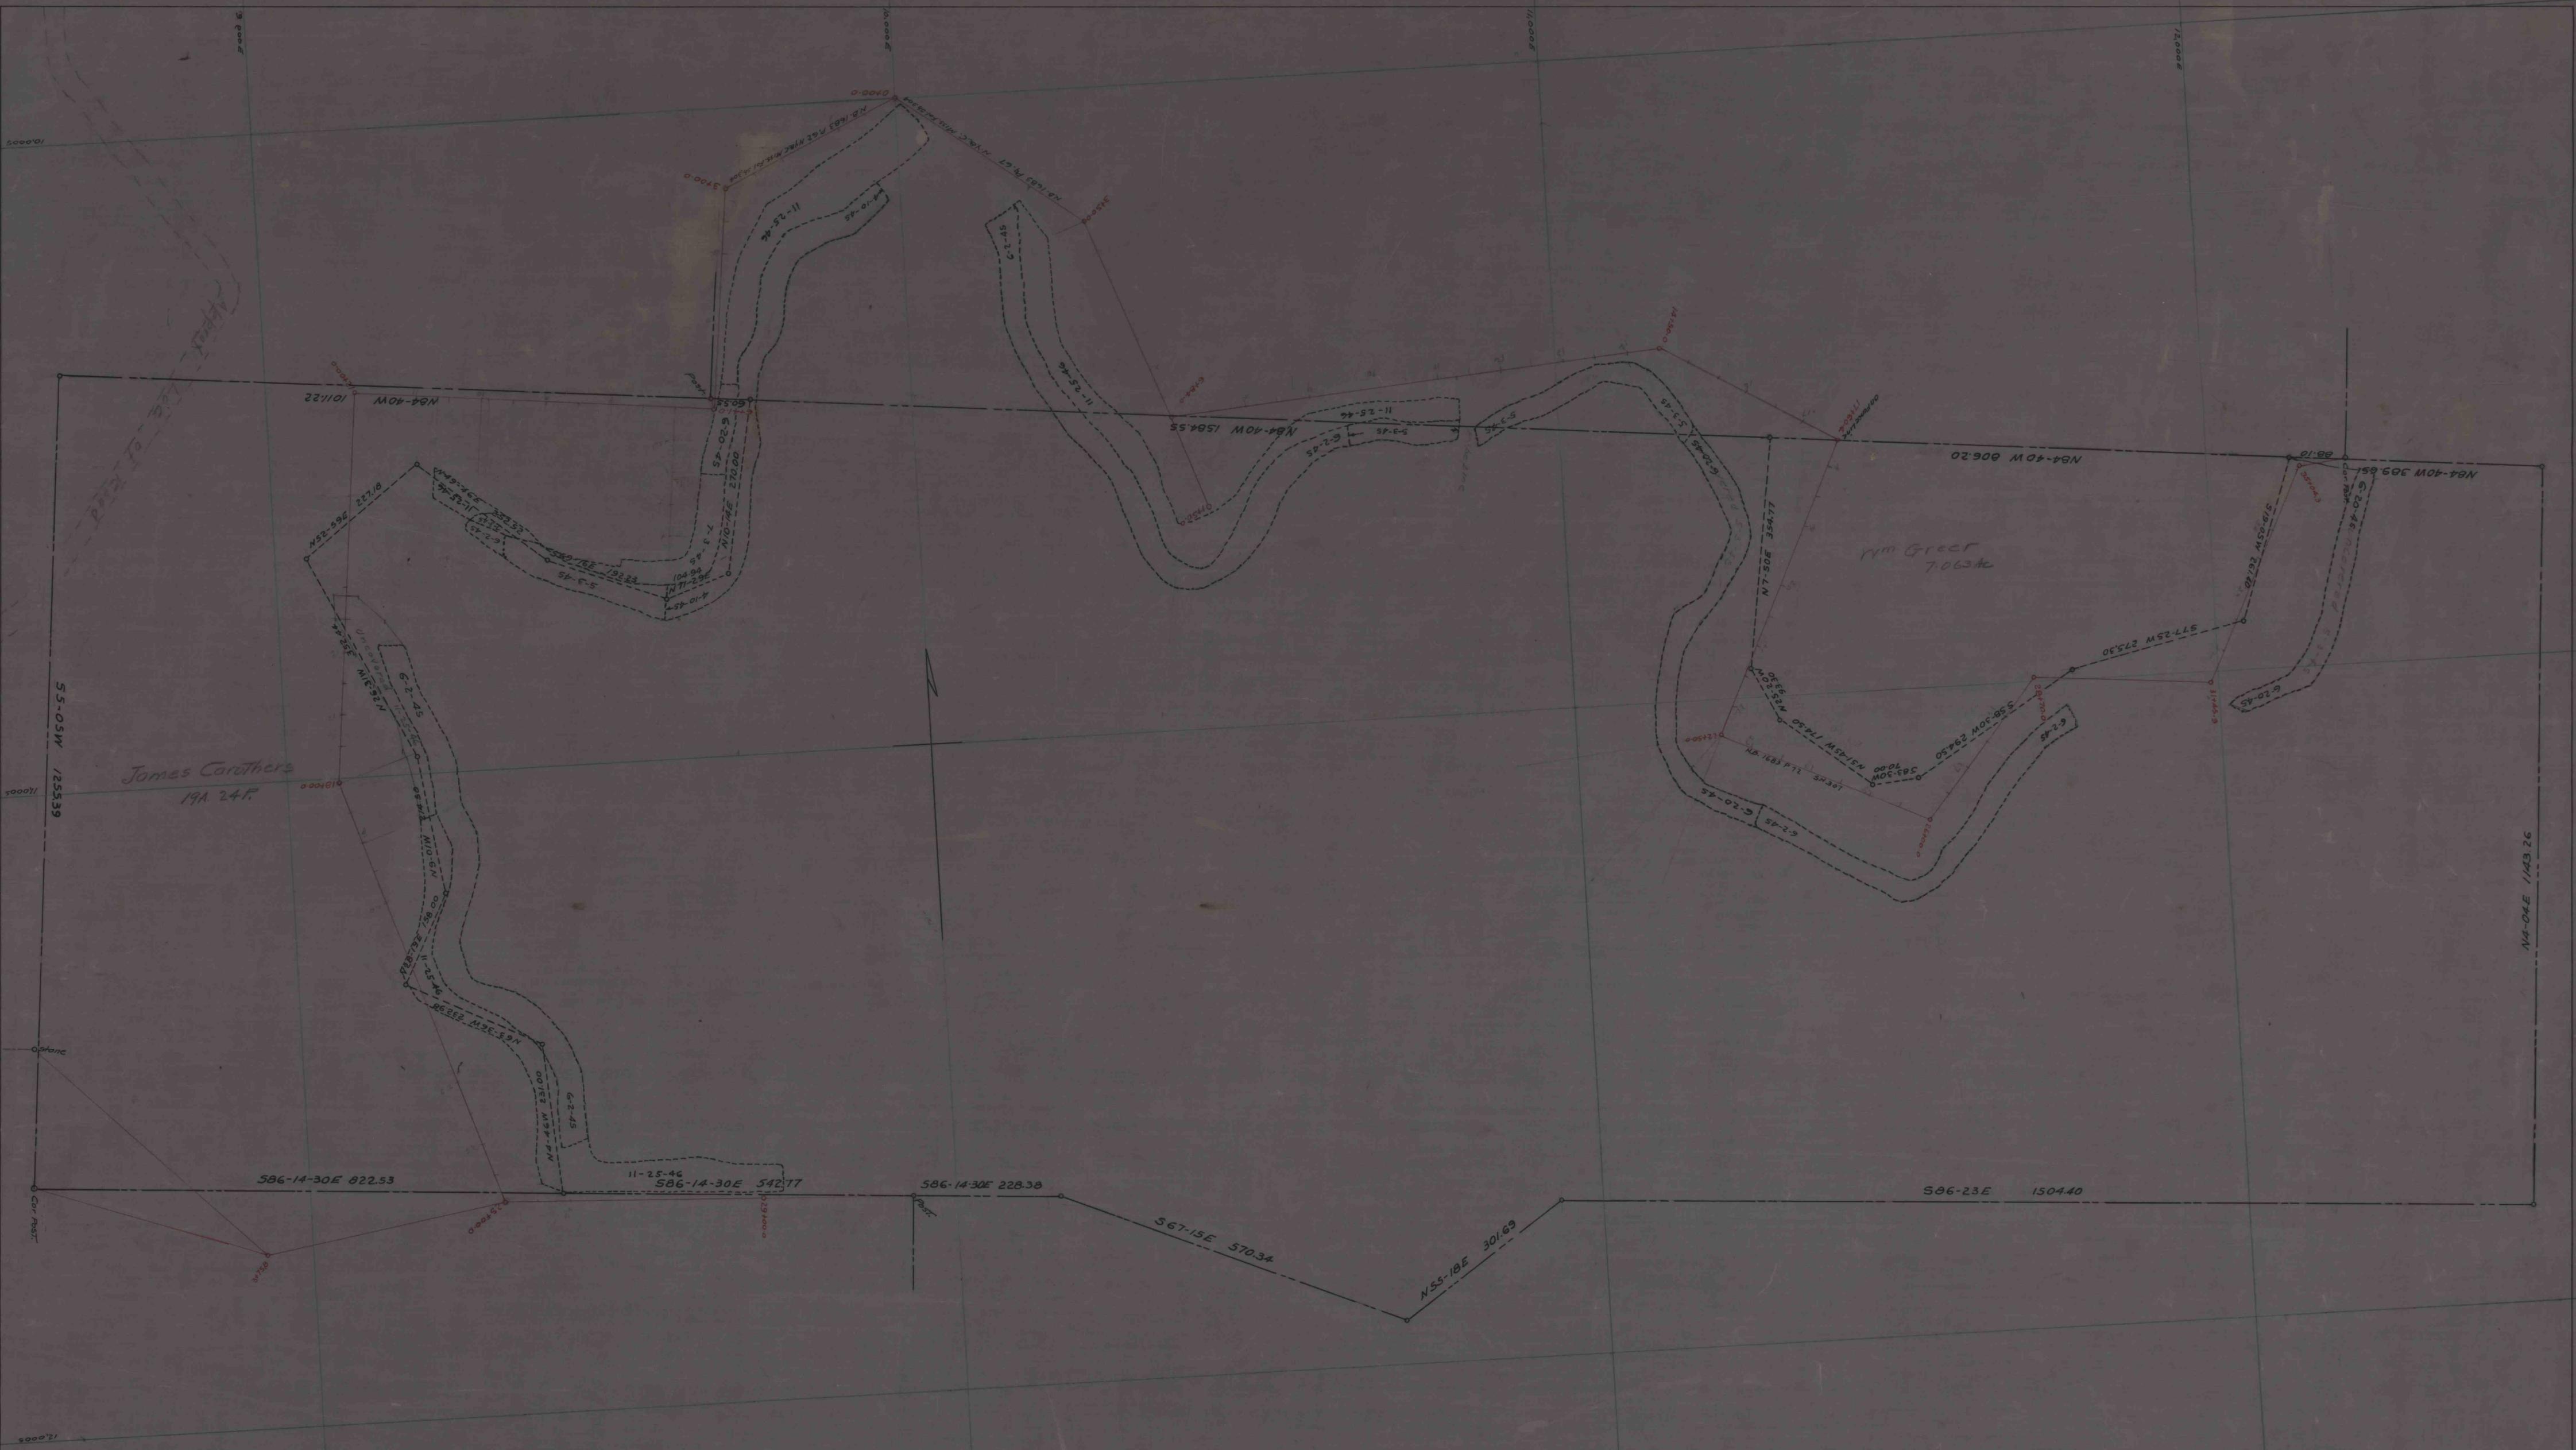

PLAN SHOWING
C.M. HALL STRIPPING OPERATION
JAMES CAROTHERS TRACT
PLUM CREEK MINE
PATTON TWP. ALLE, CO. PA.
MAY 1945. SCALE 1"=100'