


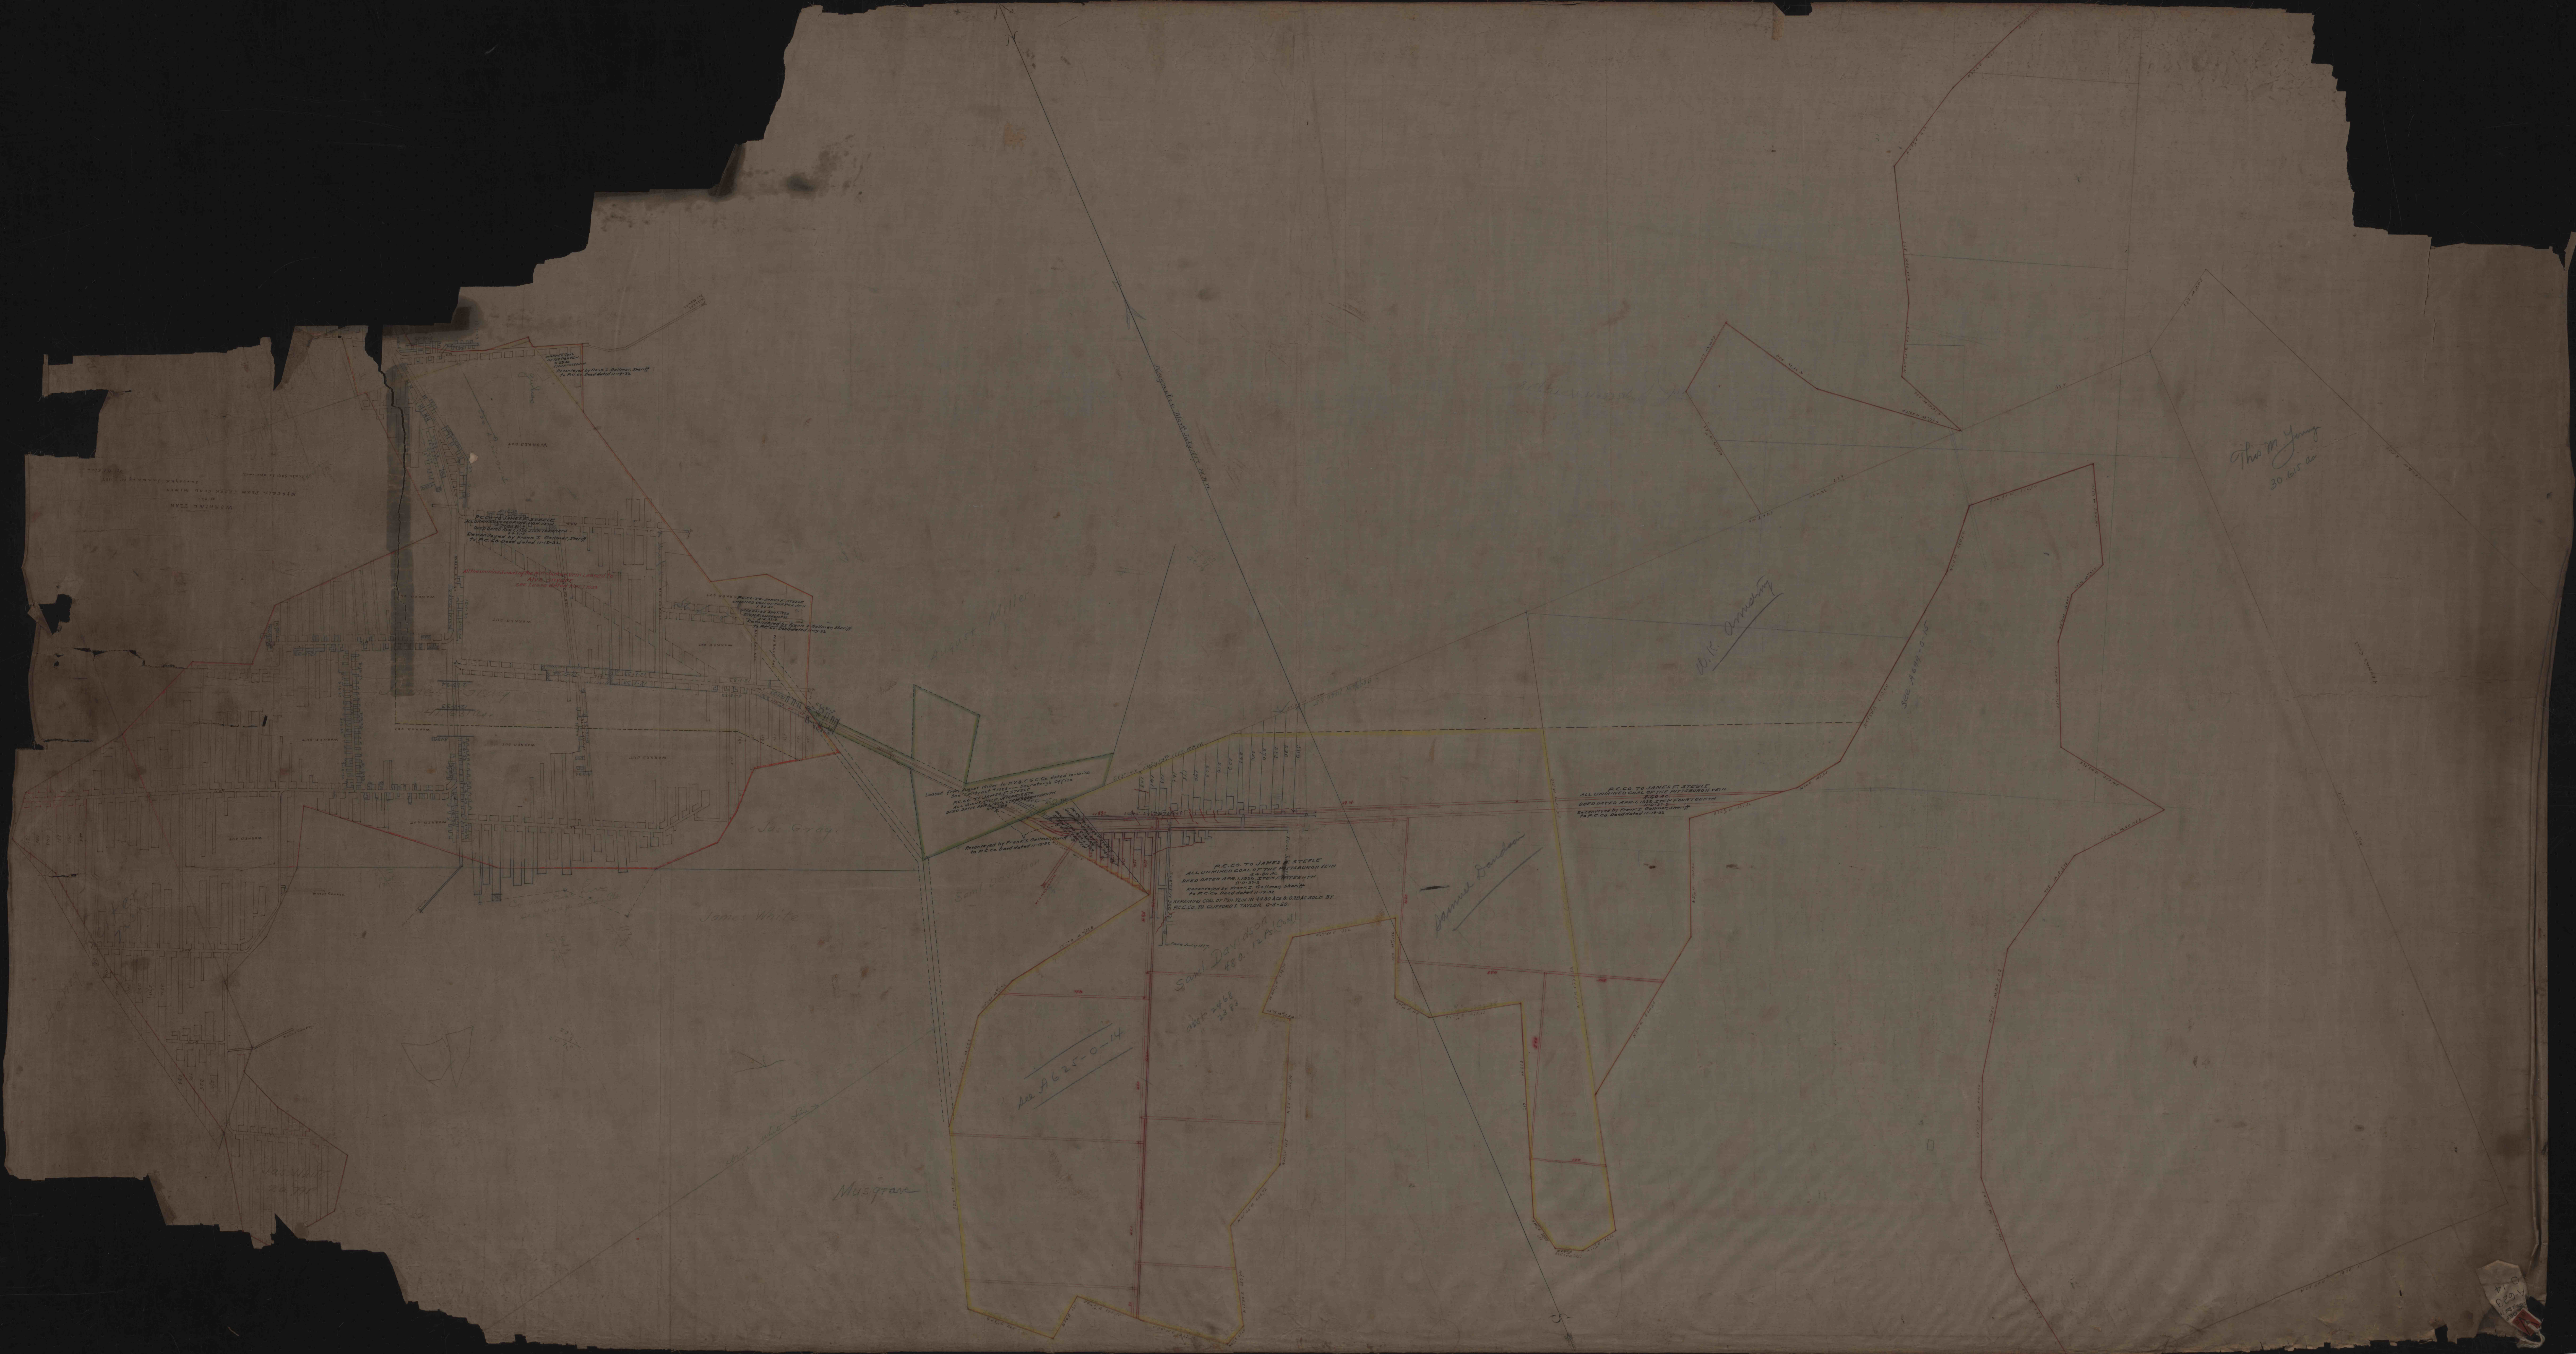

Thos M. Young
30 lots as

W.R. Amory

James Davidson

Sam Davidson


Magrath

James White

See Gray

August Miller

