



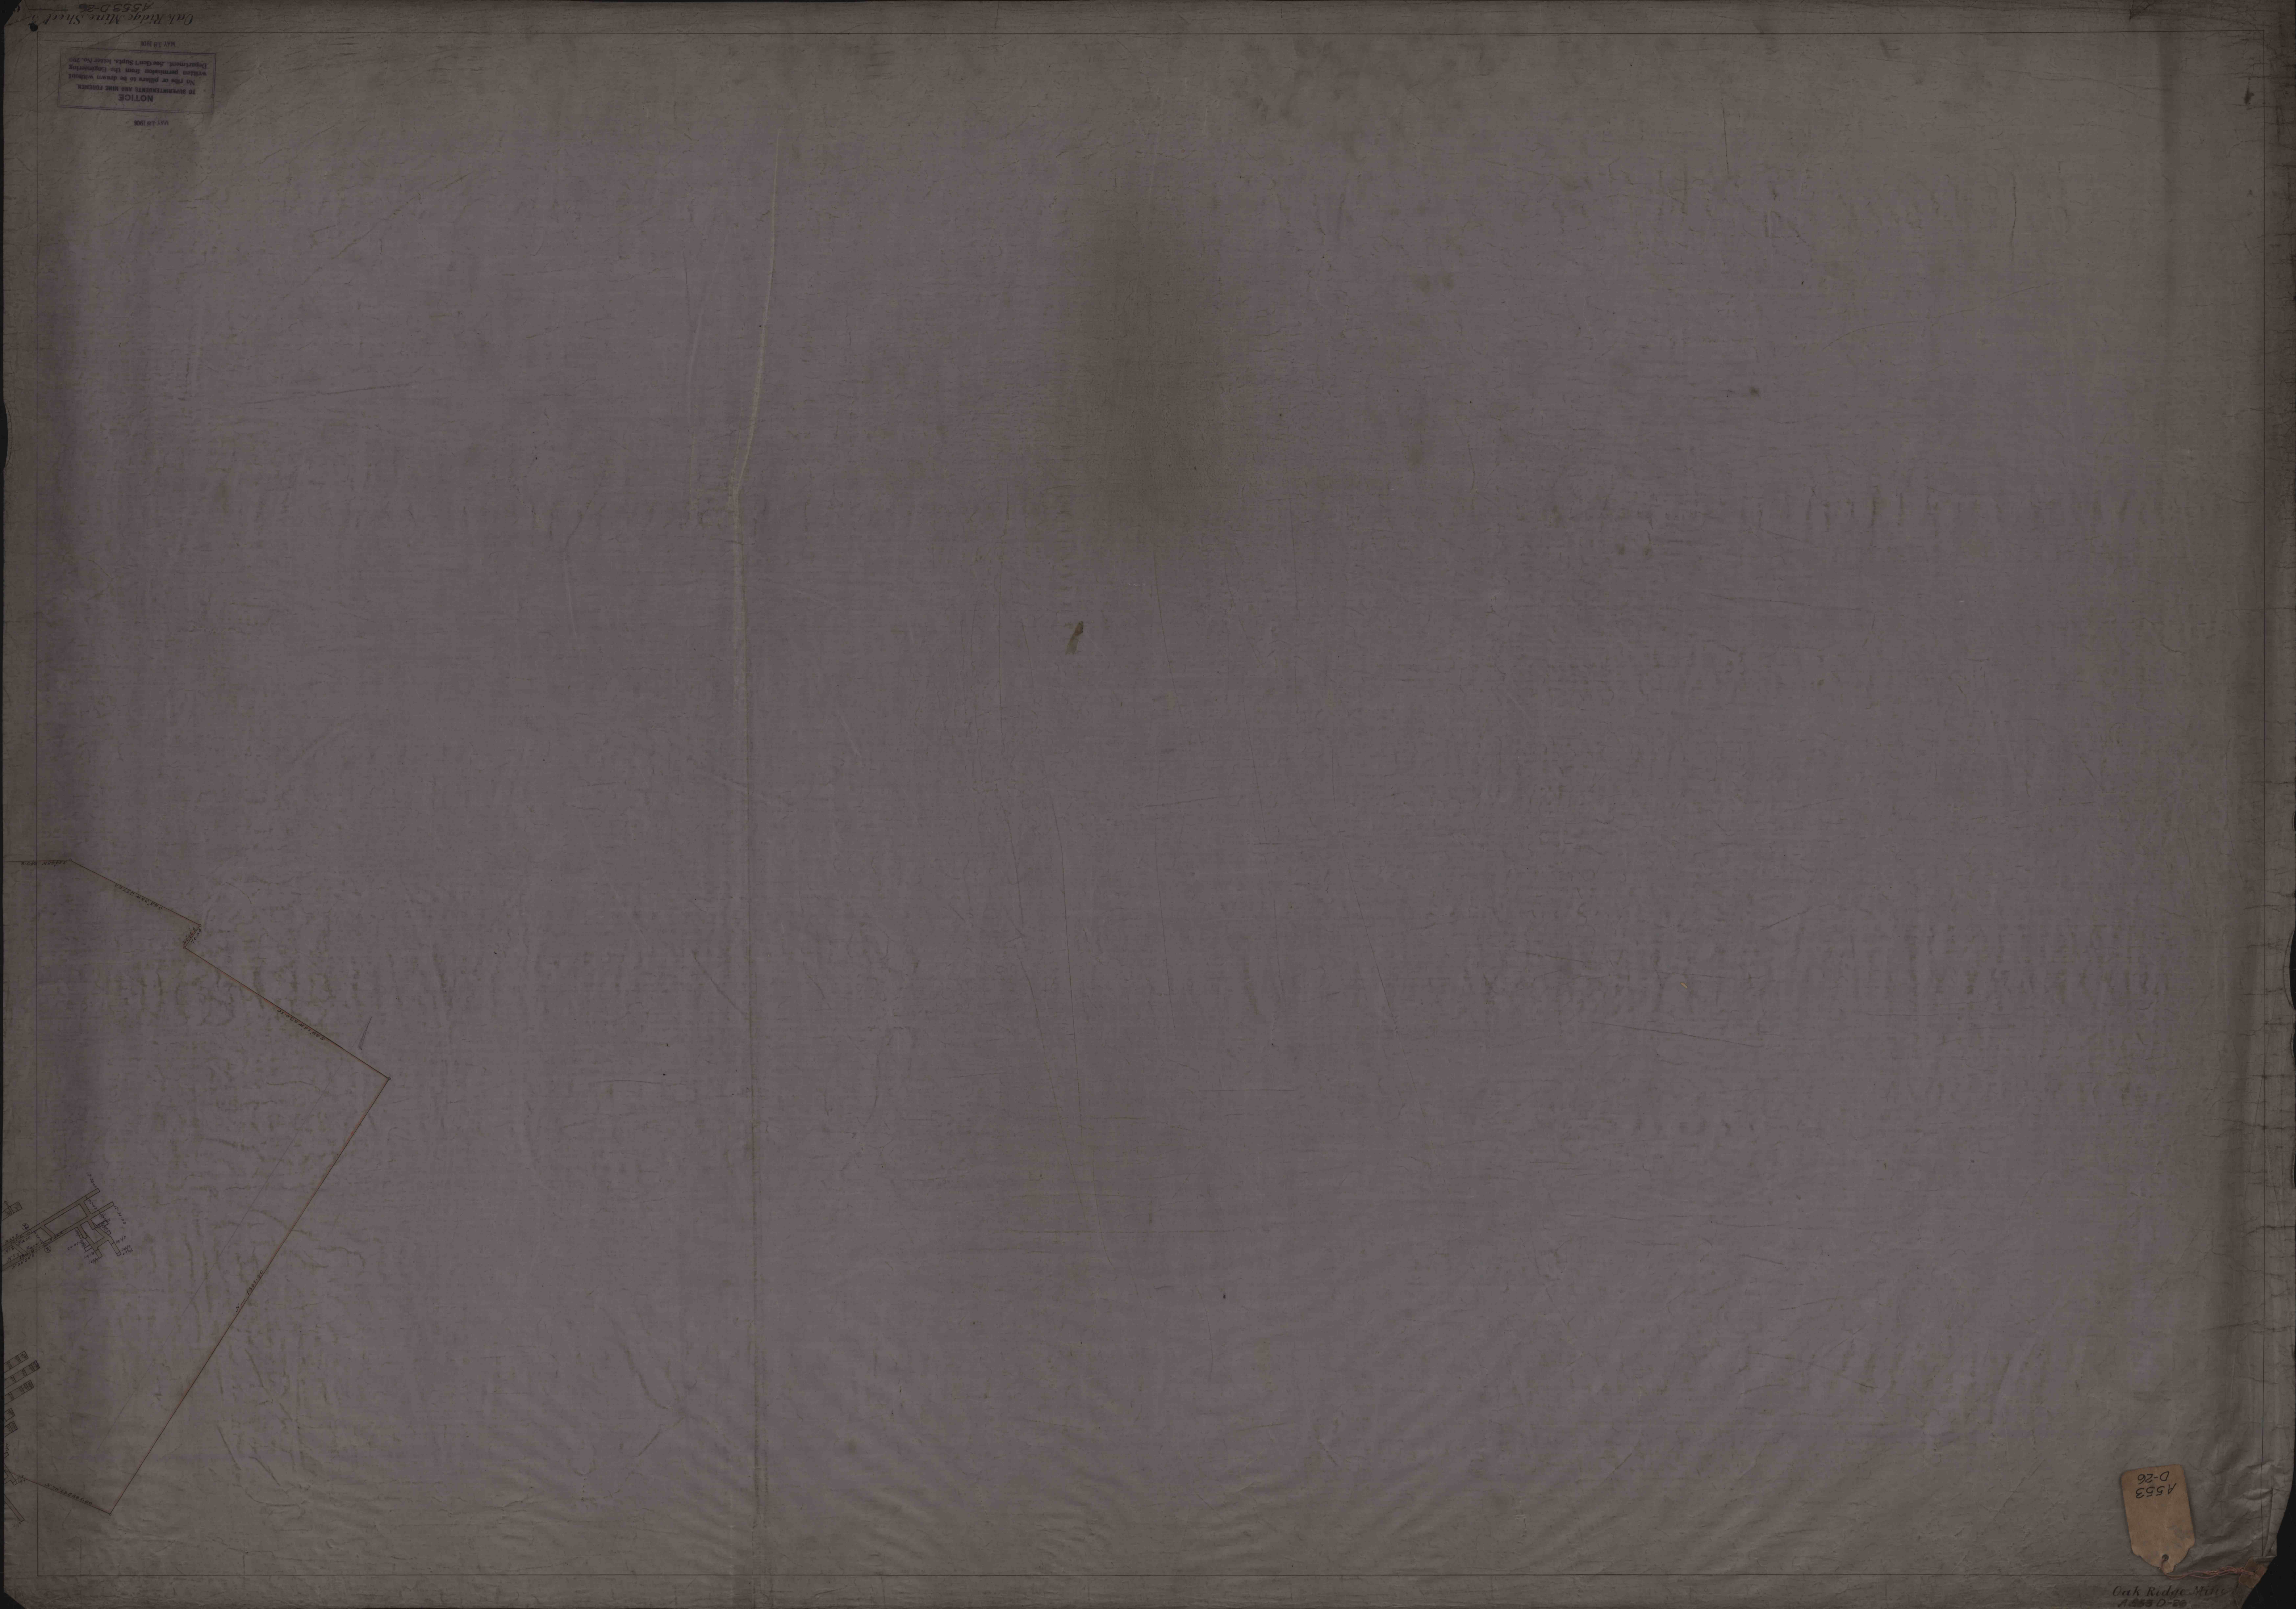

NOTICE
No file or plates to be drawn without
written permission from the Engineering
Department. See chart page 1000 and 1001

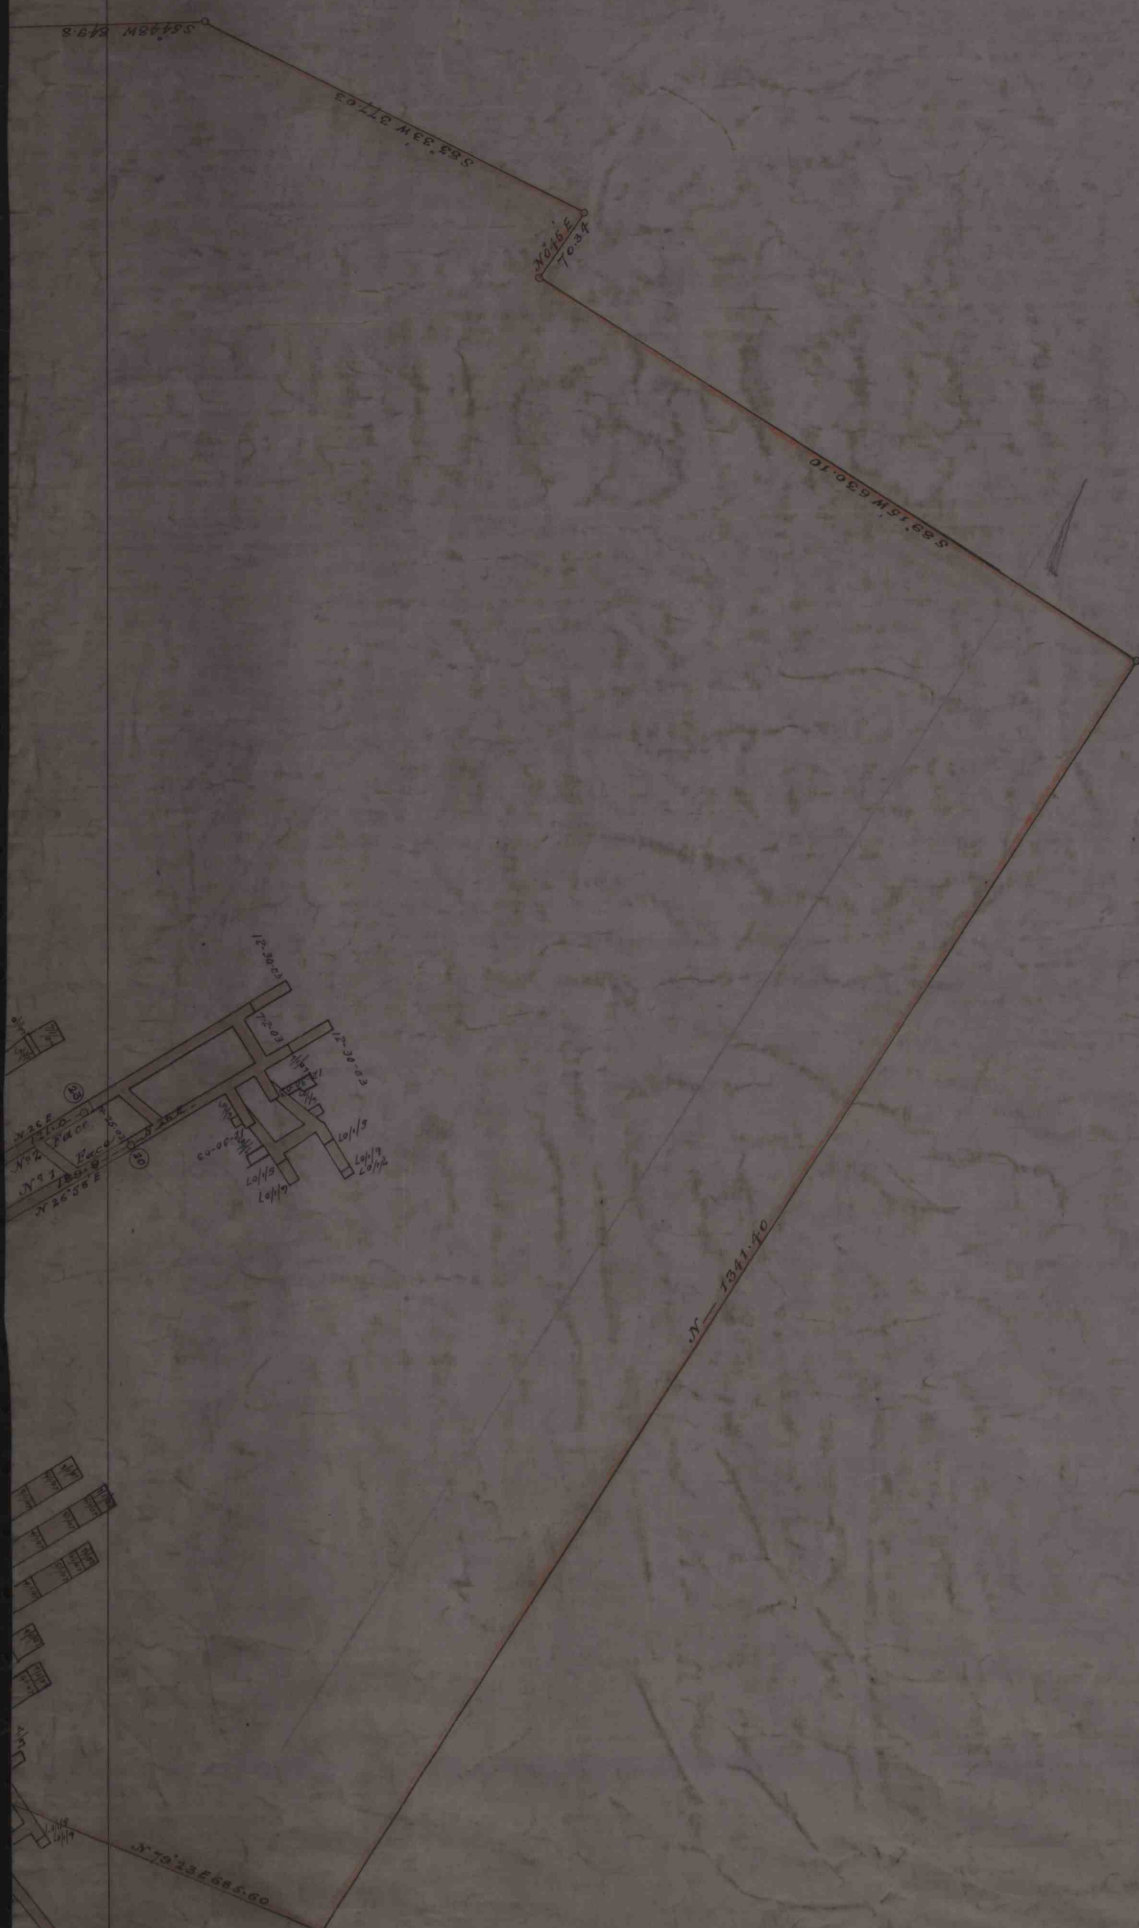

A553
D-26

Oak Ridge Mine
A553 D-26