


7-0-512-A
A 715
0-14

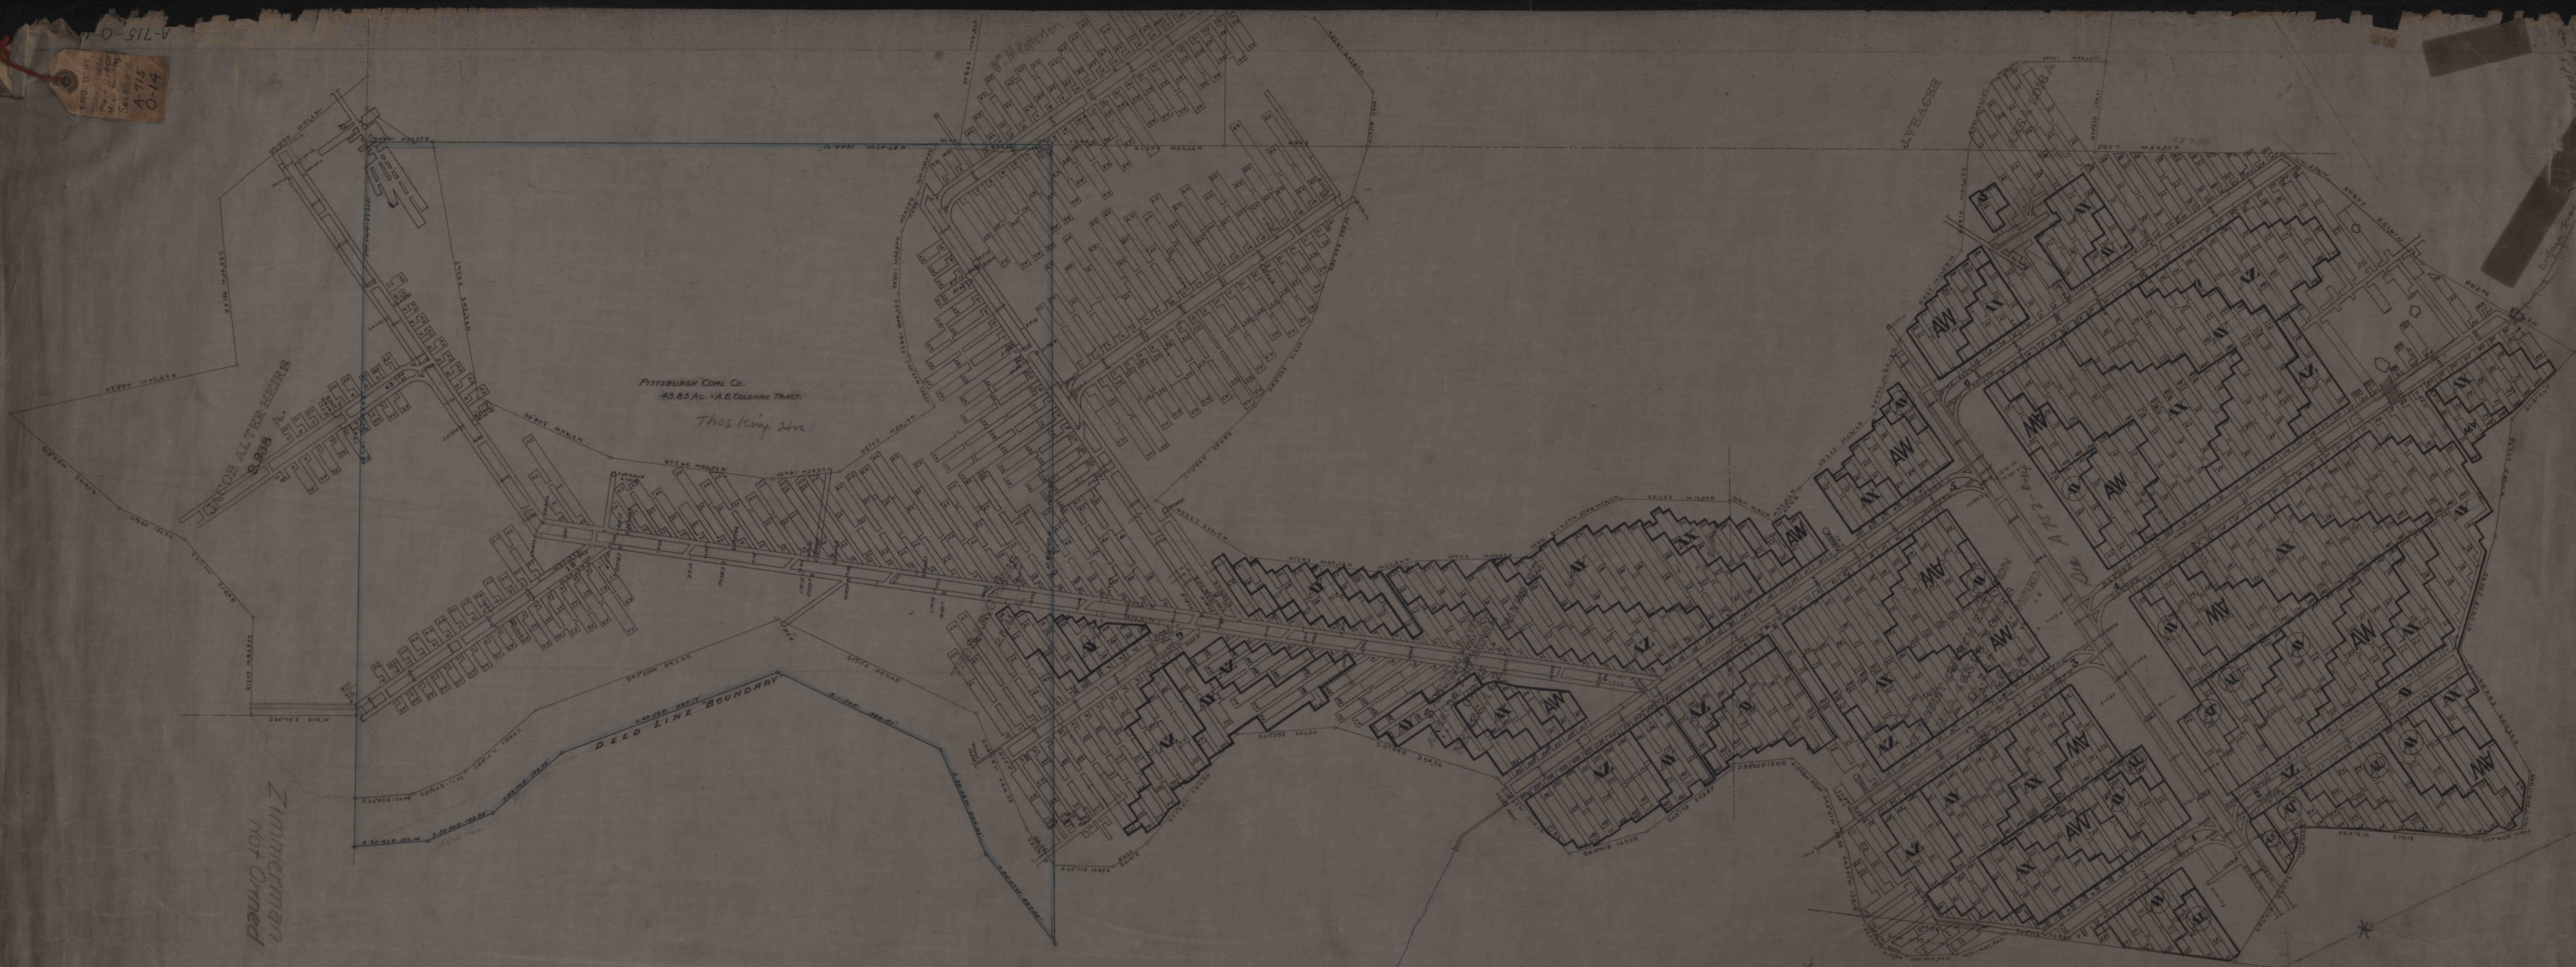

Note -
Use Tracing # A 752-0-14
for this Section

MAP SHOWING
THIRD SECTION
PLUM CREEK MINE WORKINGS
Plan A 715-0-14

PLUM TWR ALLEGHENY CO., PA.

Scale 1 inch = 100 ft.

DATE OF SURVEY

- AN = Dec 9-09
- AO = Mar 2-10
- AP = June 1-10
- AQ = Sept 1-10
- AR = Dec 9-10
- AS = Mar 14-11
- AT = May 31-11
- AU = Sept 6-11
- AV = Dec 6-11



fit to A 682-0-14

fit to A 682-0-14