


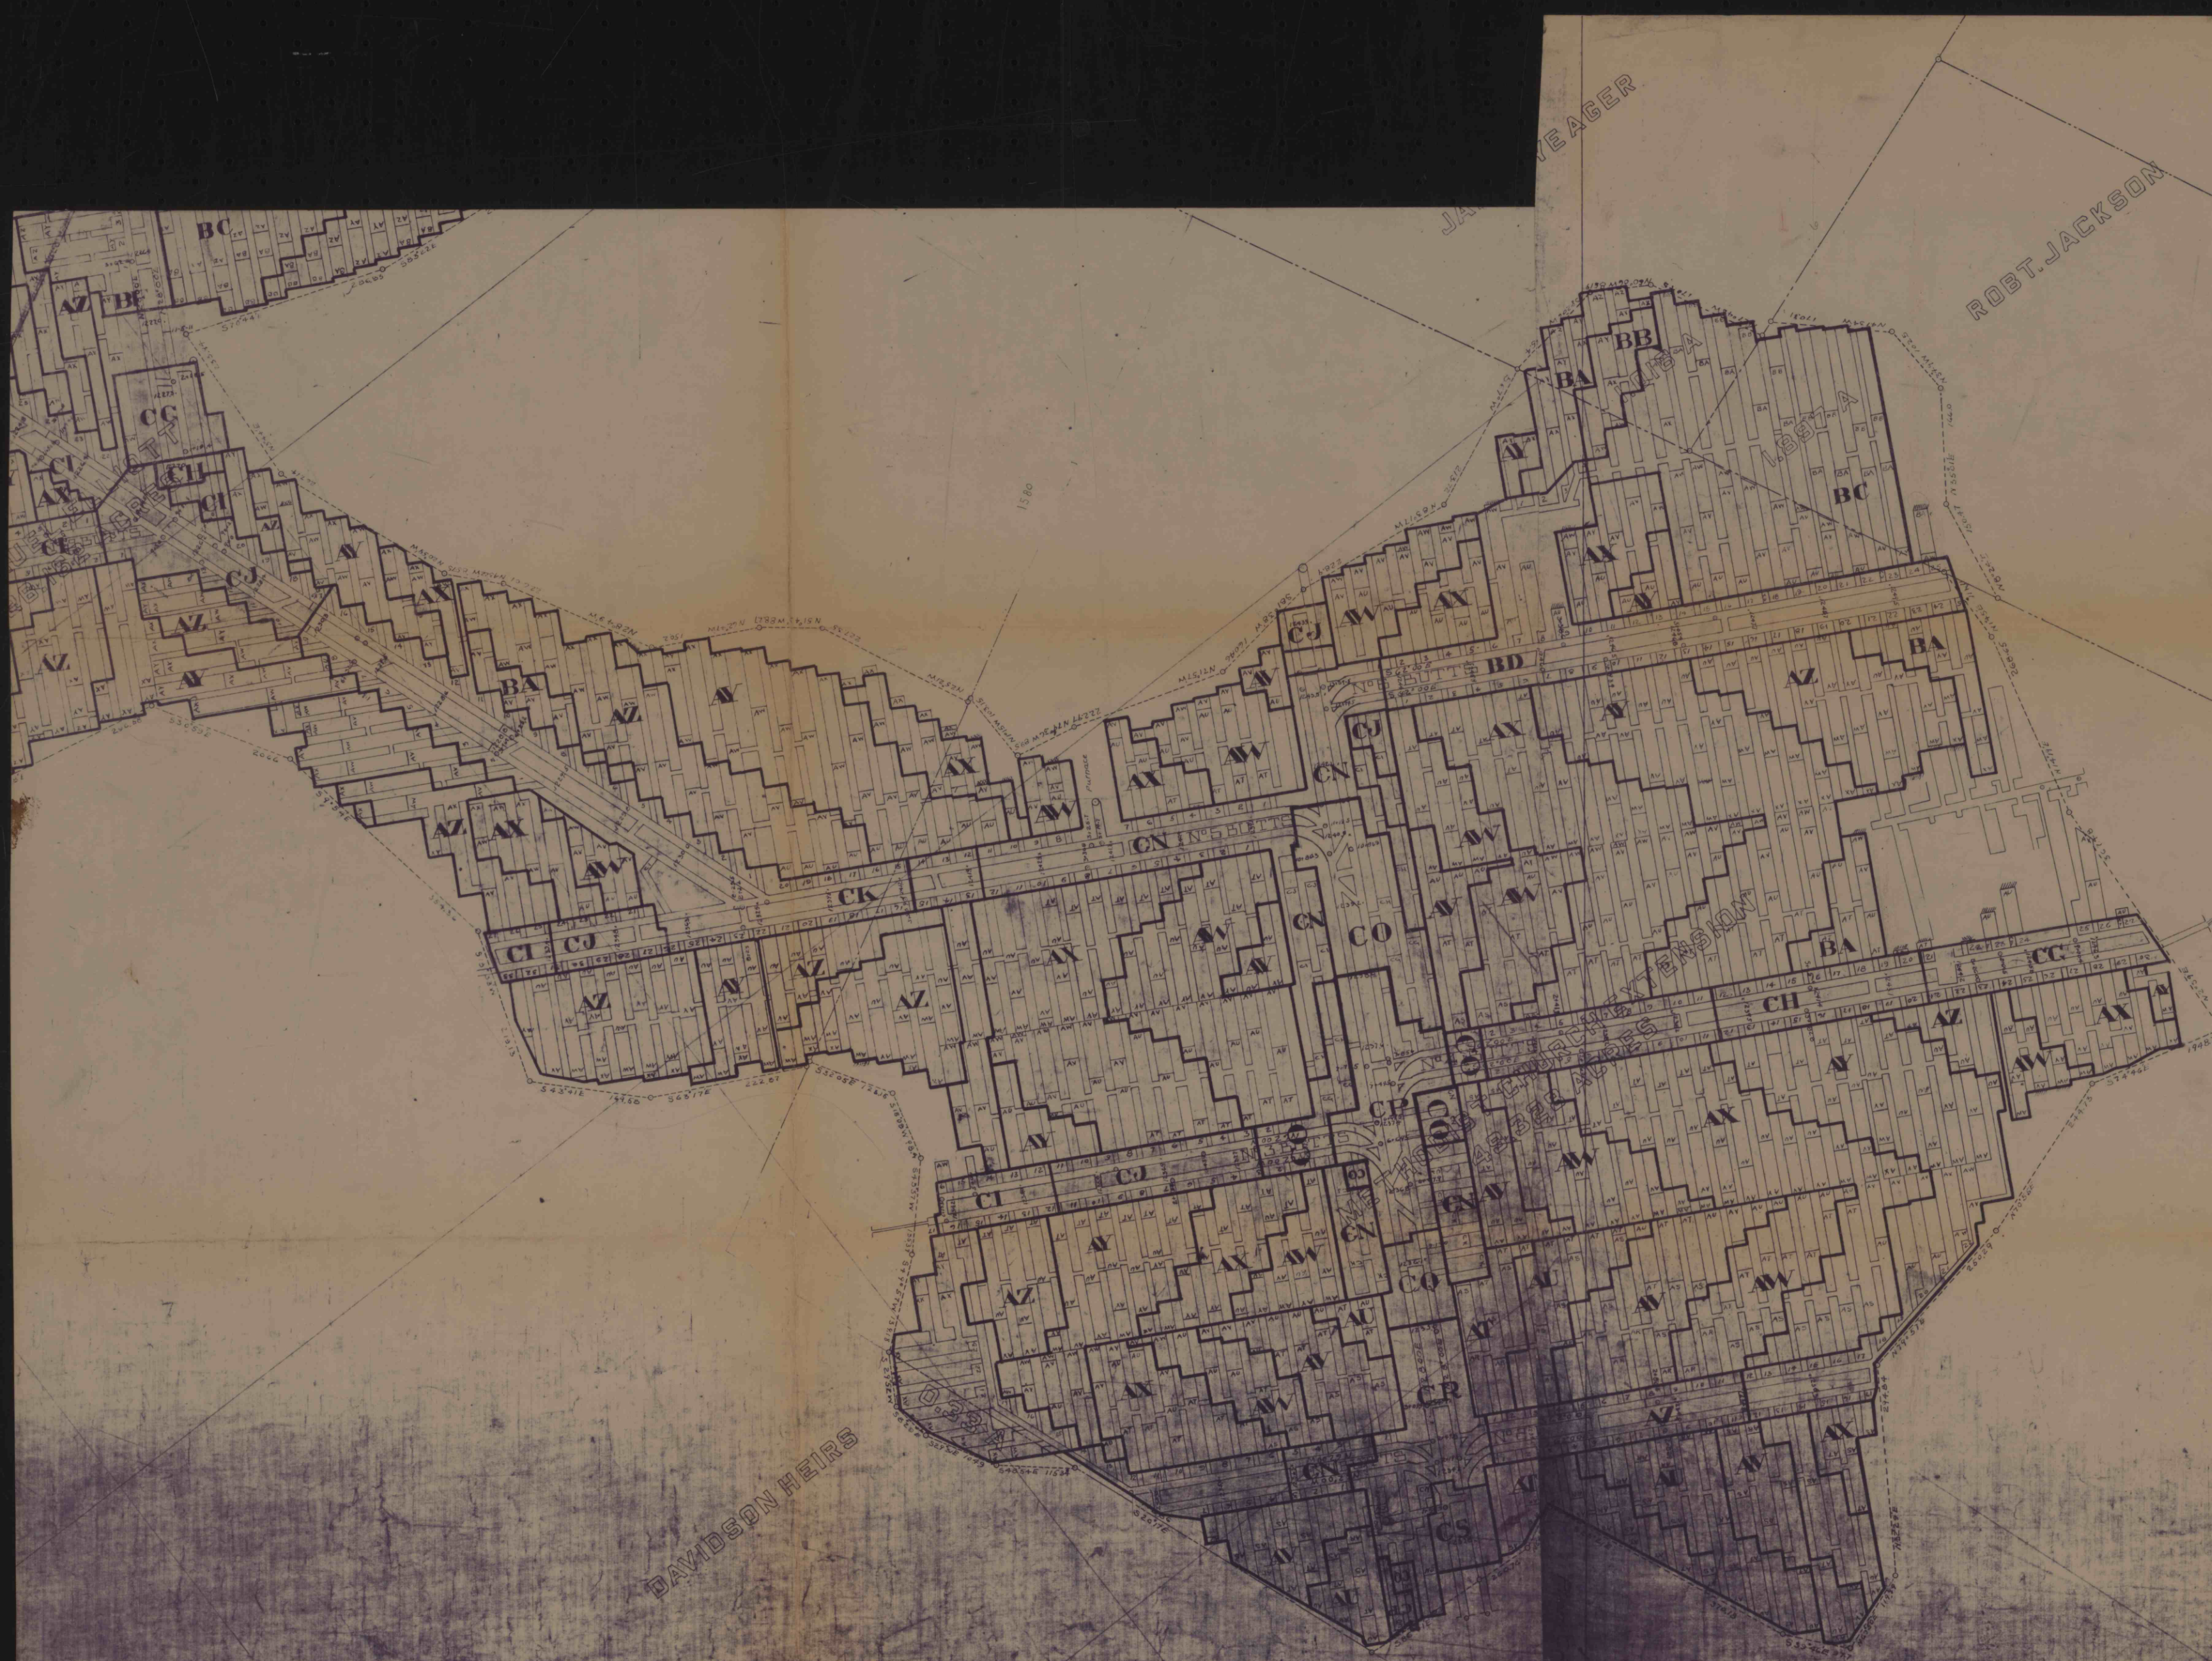

PLUM CREEK MINE

SURVEY DATES

AR	12-6-10	BH	12-23-14
AS	2-27-11	BI	3-3-16
AT	6-8-11	BJ	6-8-16
AU	9-6-11	BK	10-9-16
AV	12-5-11	BL	12-2-16
AW	3-7-12	BM	3-2-16
AX	6-10-12	BN	6-12-16
AY	9-13-12	BO	9-14-16
AZ	12-14-12	BP	12-6-16
BA	4-11-13	BO*	3-2-17
BB	6-6-13	BR	6-19-17
BC	9-12-13	BS	9-26-17
BD	12-9-13	BT	12-19-17
BE	3-3-14	BU	3-13-18
BF	6-12-14	BV	6-1-18
BG	9-11-14	BW	9-16-18
BX	11-18-18		
BY	3-12-19		
BZ	6-11-19		

Herman!

This print is all we could find on the McCaslin Tract. Apparently they never located all the property corners as they do not show on the hard back map

John McClure