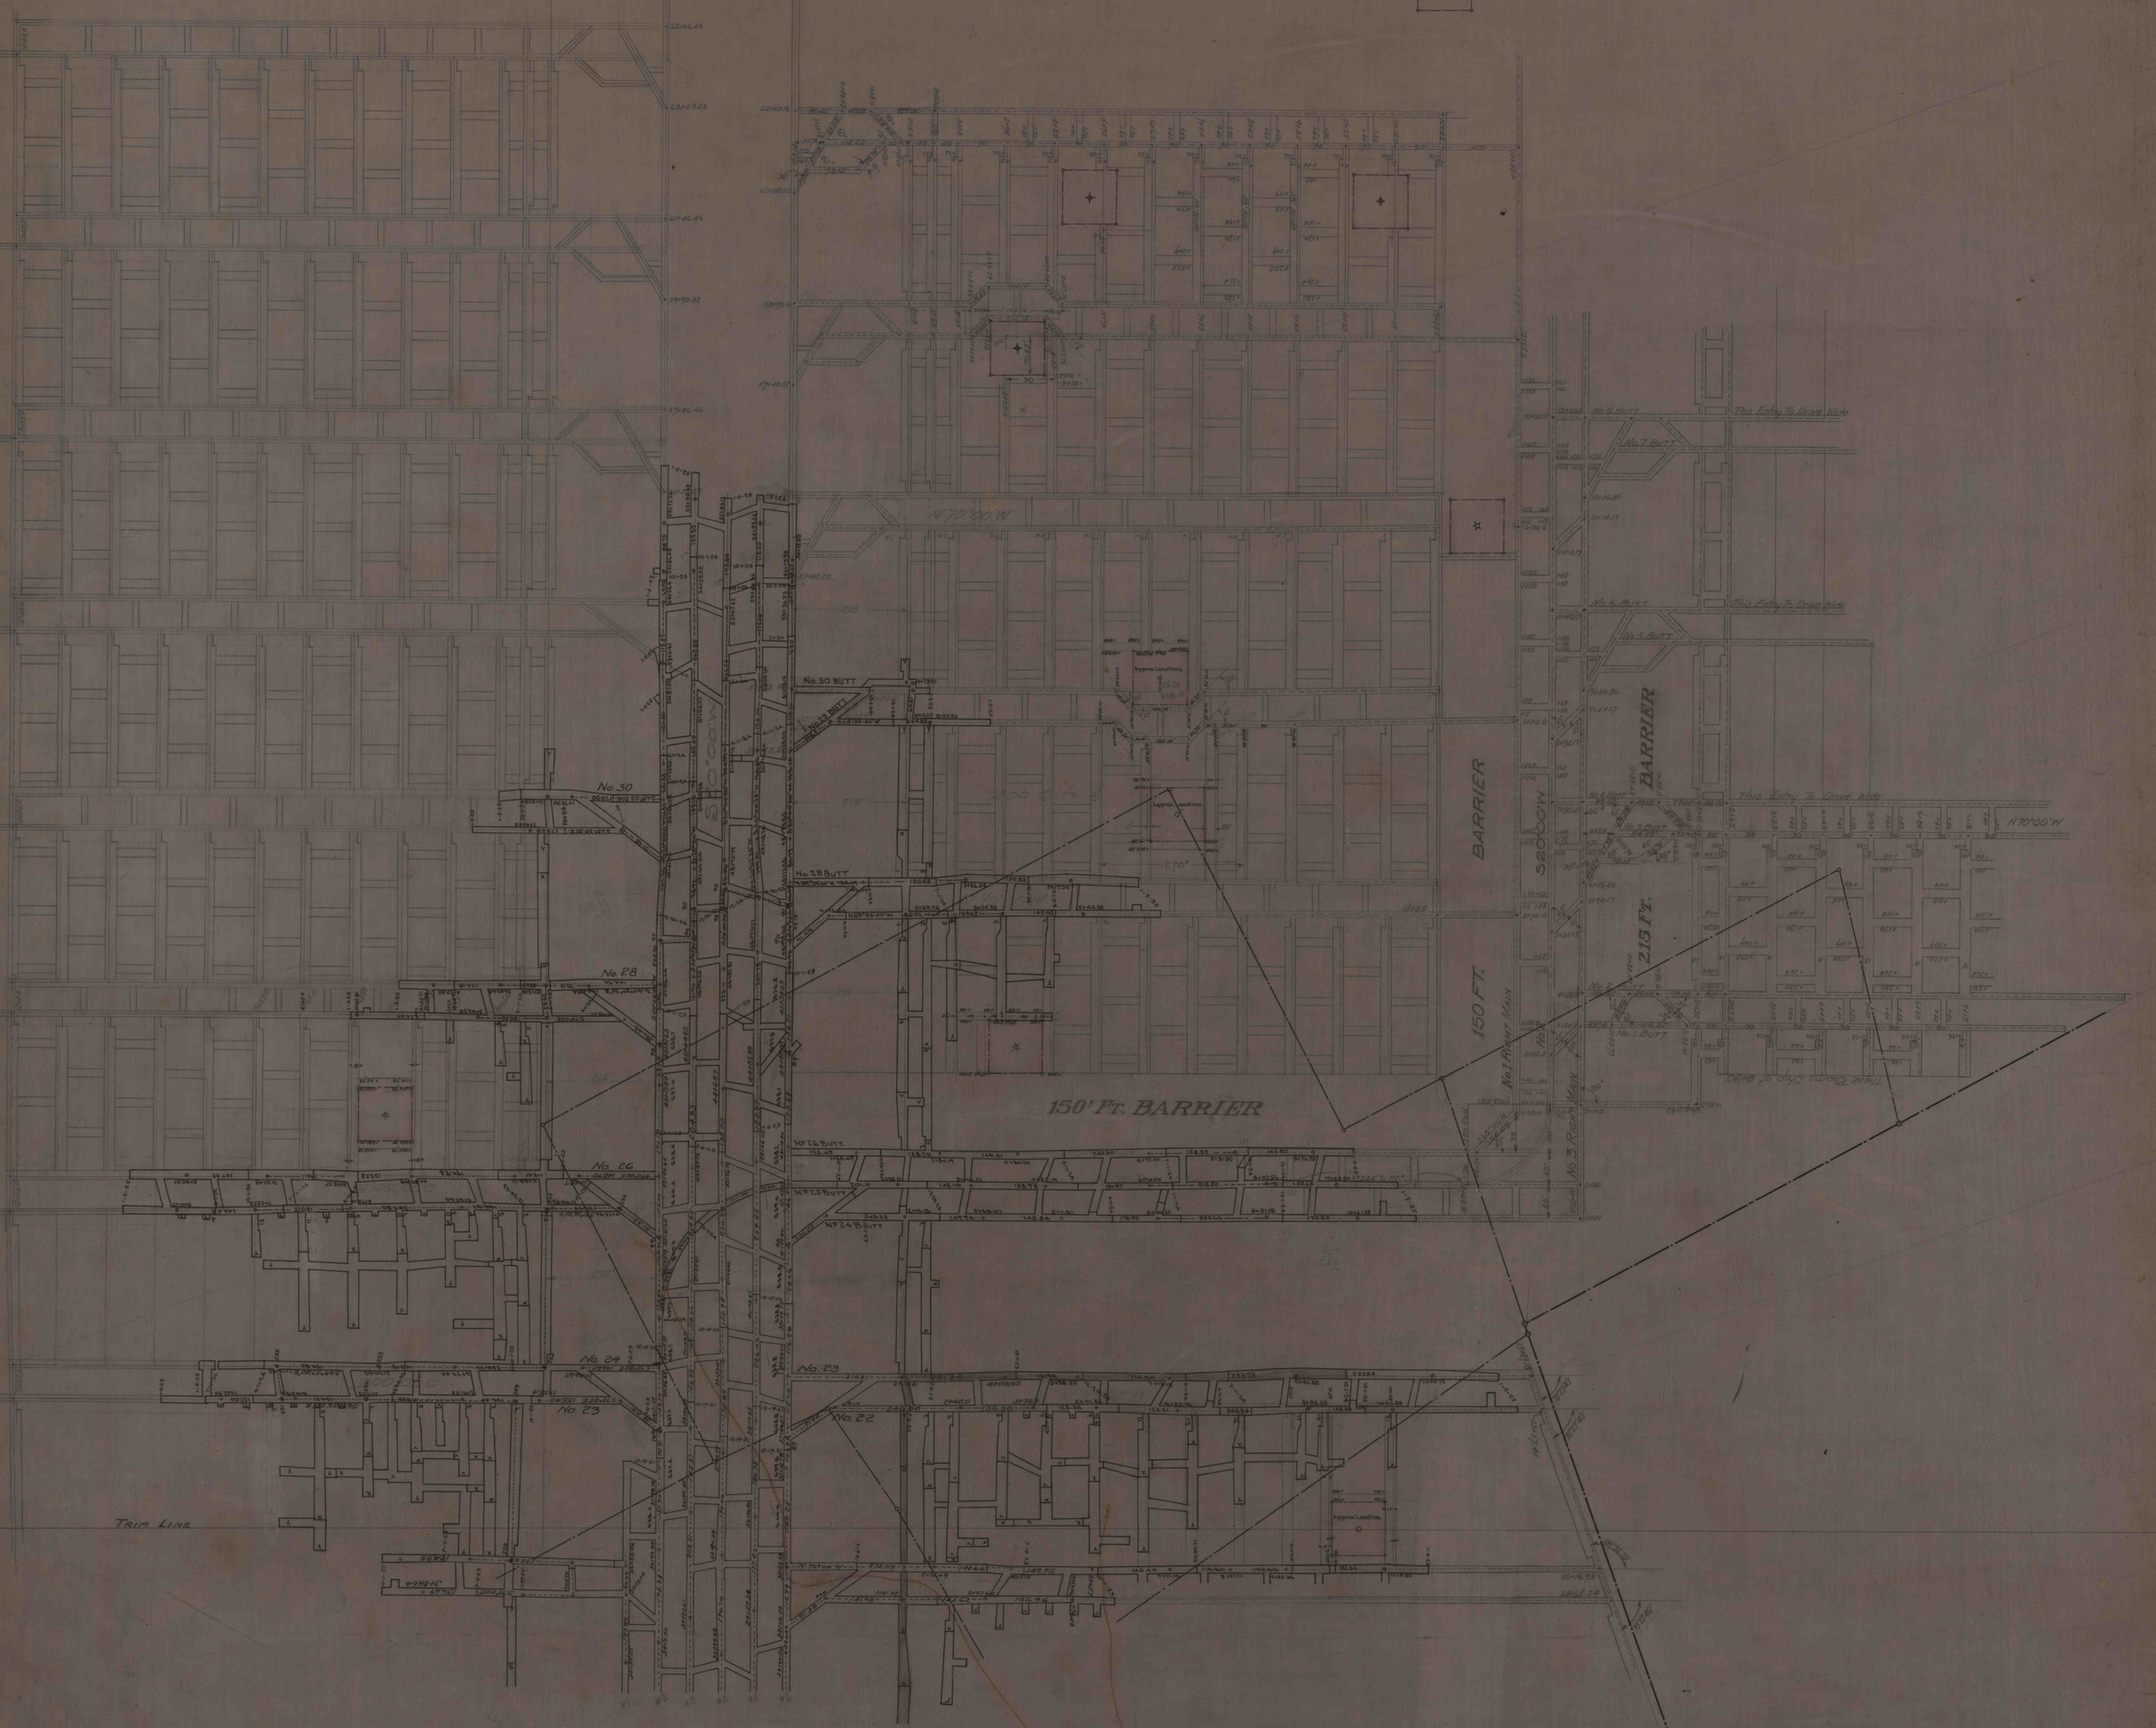
N 70°00'W
No. 30 BUTT
No. 23 BUTT
No. 30
No. 28 BUTT
No. 28
No. 26
No. 26 BUTT
No. 25 BUTT
No. 24 BUTT
No. 24
No. 23
No. 22
150' FT. BARRIER
BARRIER
150 FT.
215 FT.
No. 1 Room Main
No. 3 Room Main
No. 1 BUTT
No. 5 BUTT
No. 6 BUTT
No. 7 BUTT
This Entry To Drive Wide
TRIM LINE