


502
A694-014

A694-014
Sheet 5

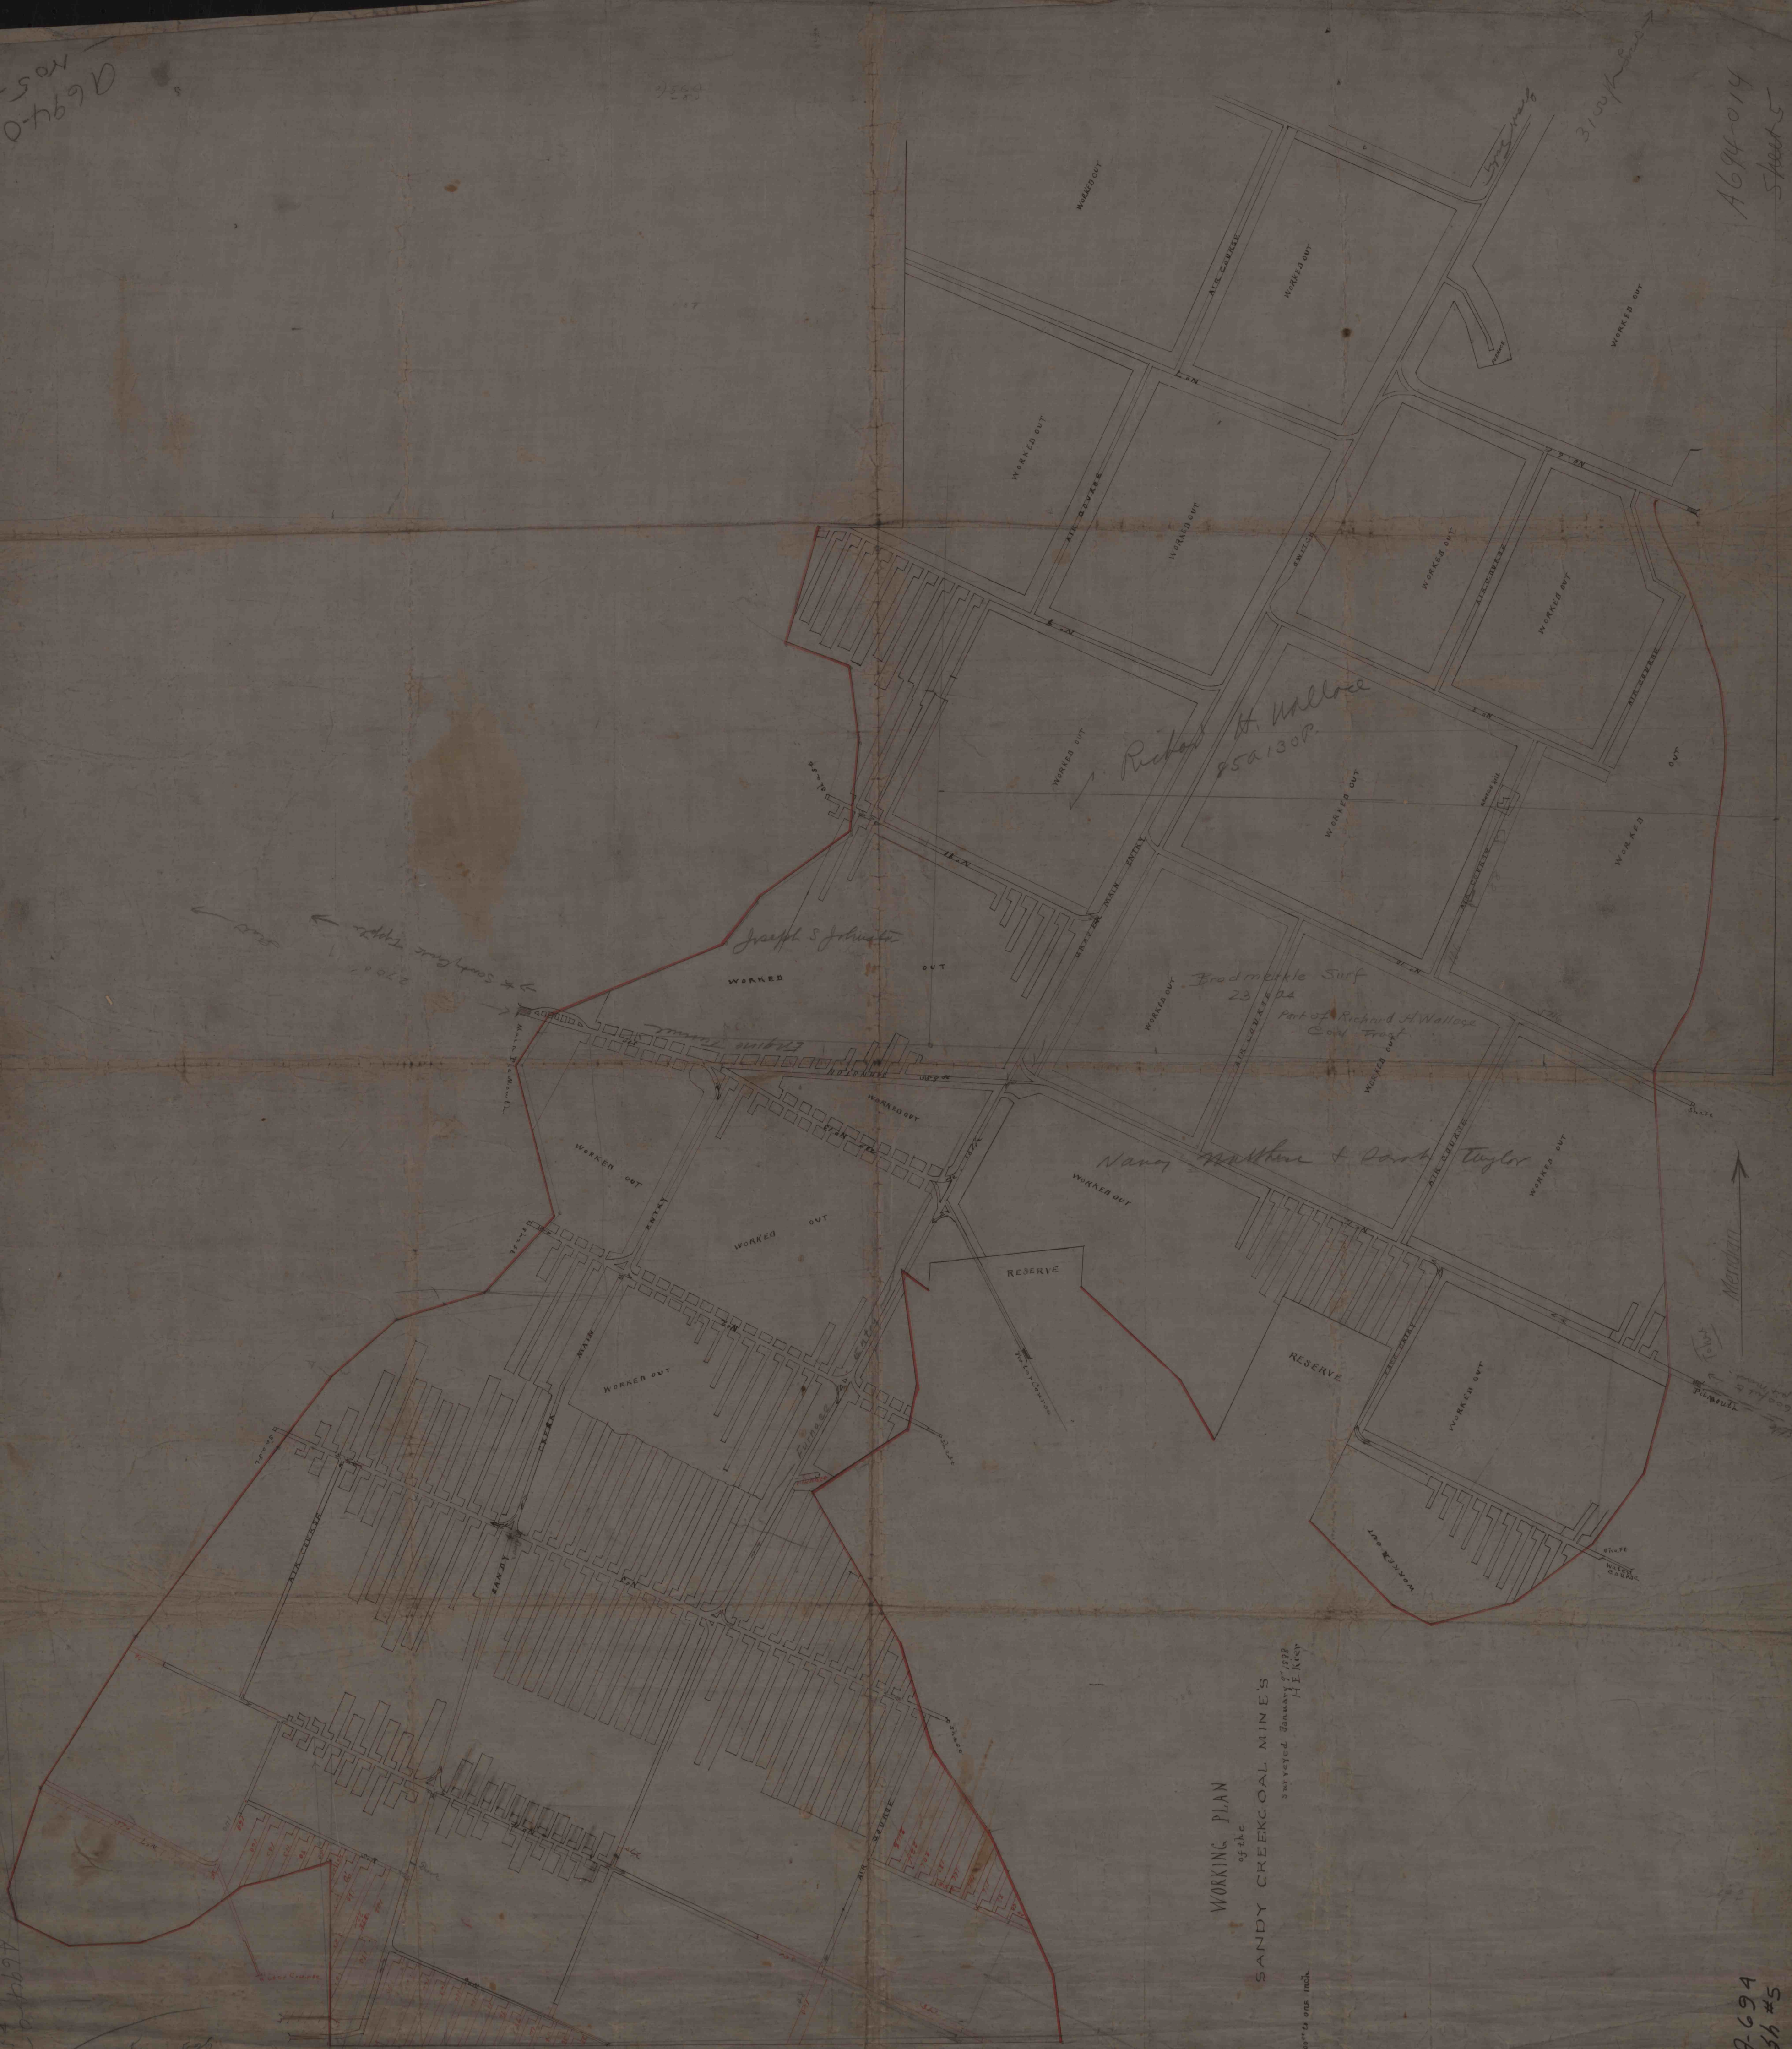

WORKING PLAN
of the
SANDY CREEK COAL MINES
Surveyed January 1898
H. E. KIRBY

Scale 100' = 1" and 1/2"

A694-014
Sheet 5

A-694
Sh #5