


A694-014  
No. 3

PLAN  
OF THE  
SANDY CREEK COAL MINES  
SITUATED IN PENN. ALLEGHENY CO. PENN.  
JANUARY, 1896  
H. E. KIER, M. E.  
SCALE - 2000 TO ONE INCH

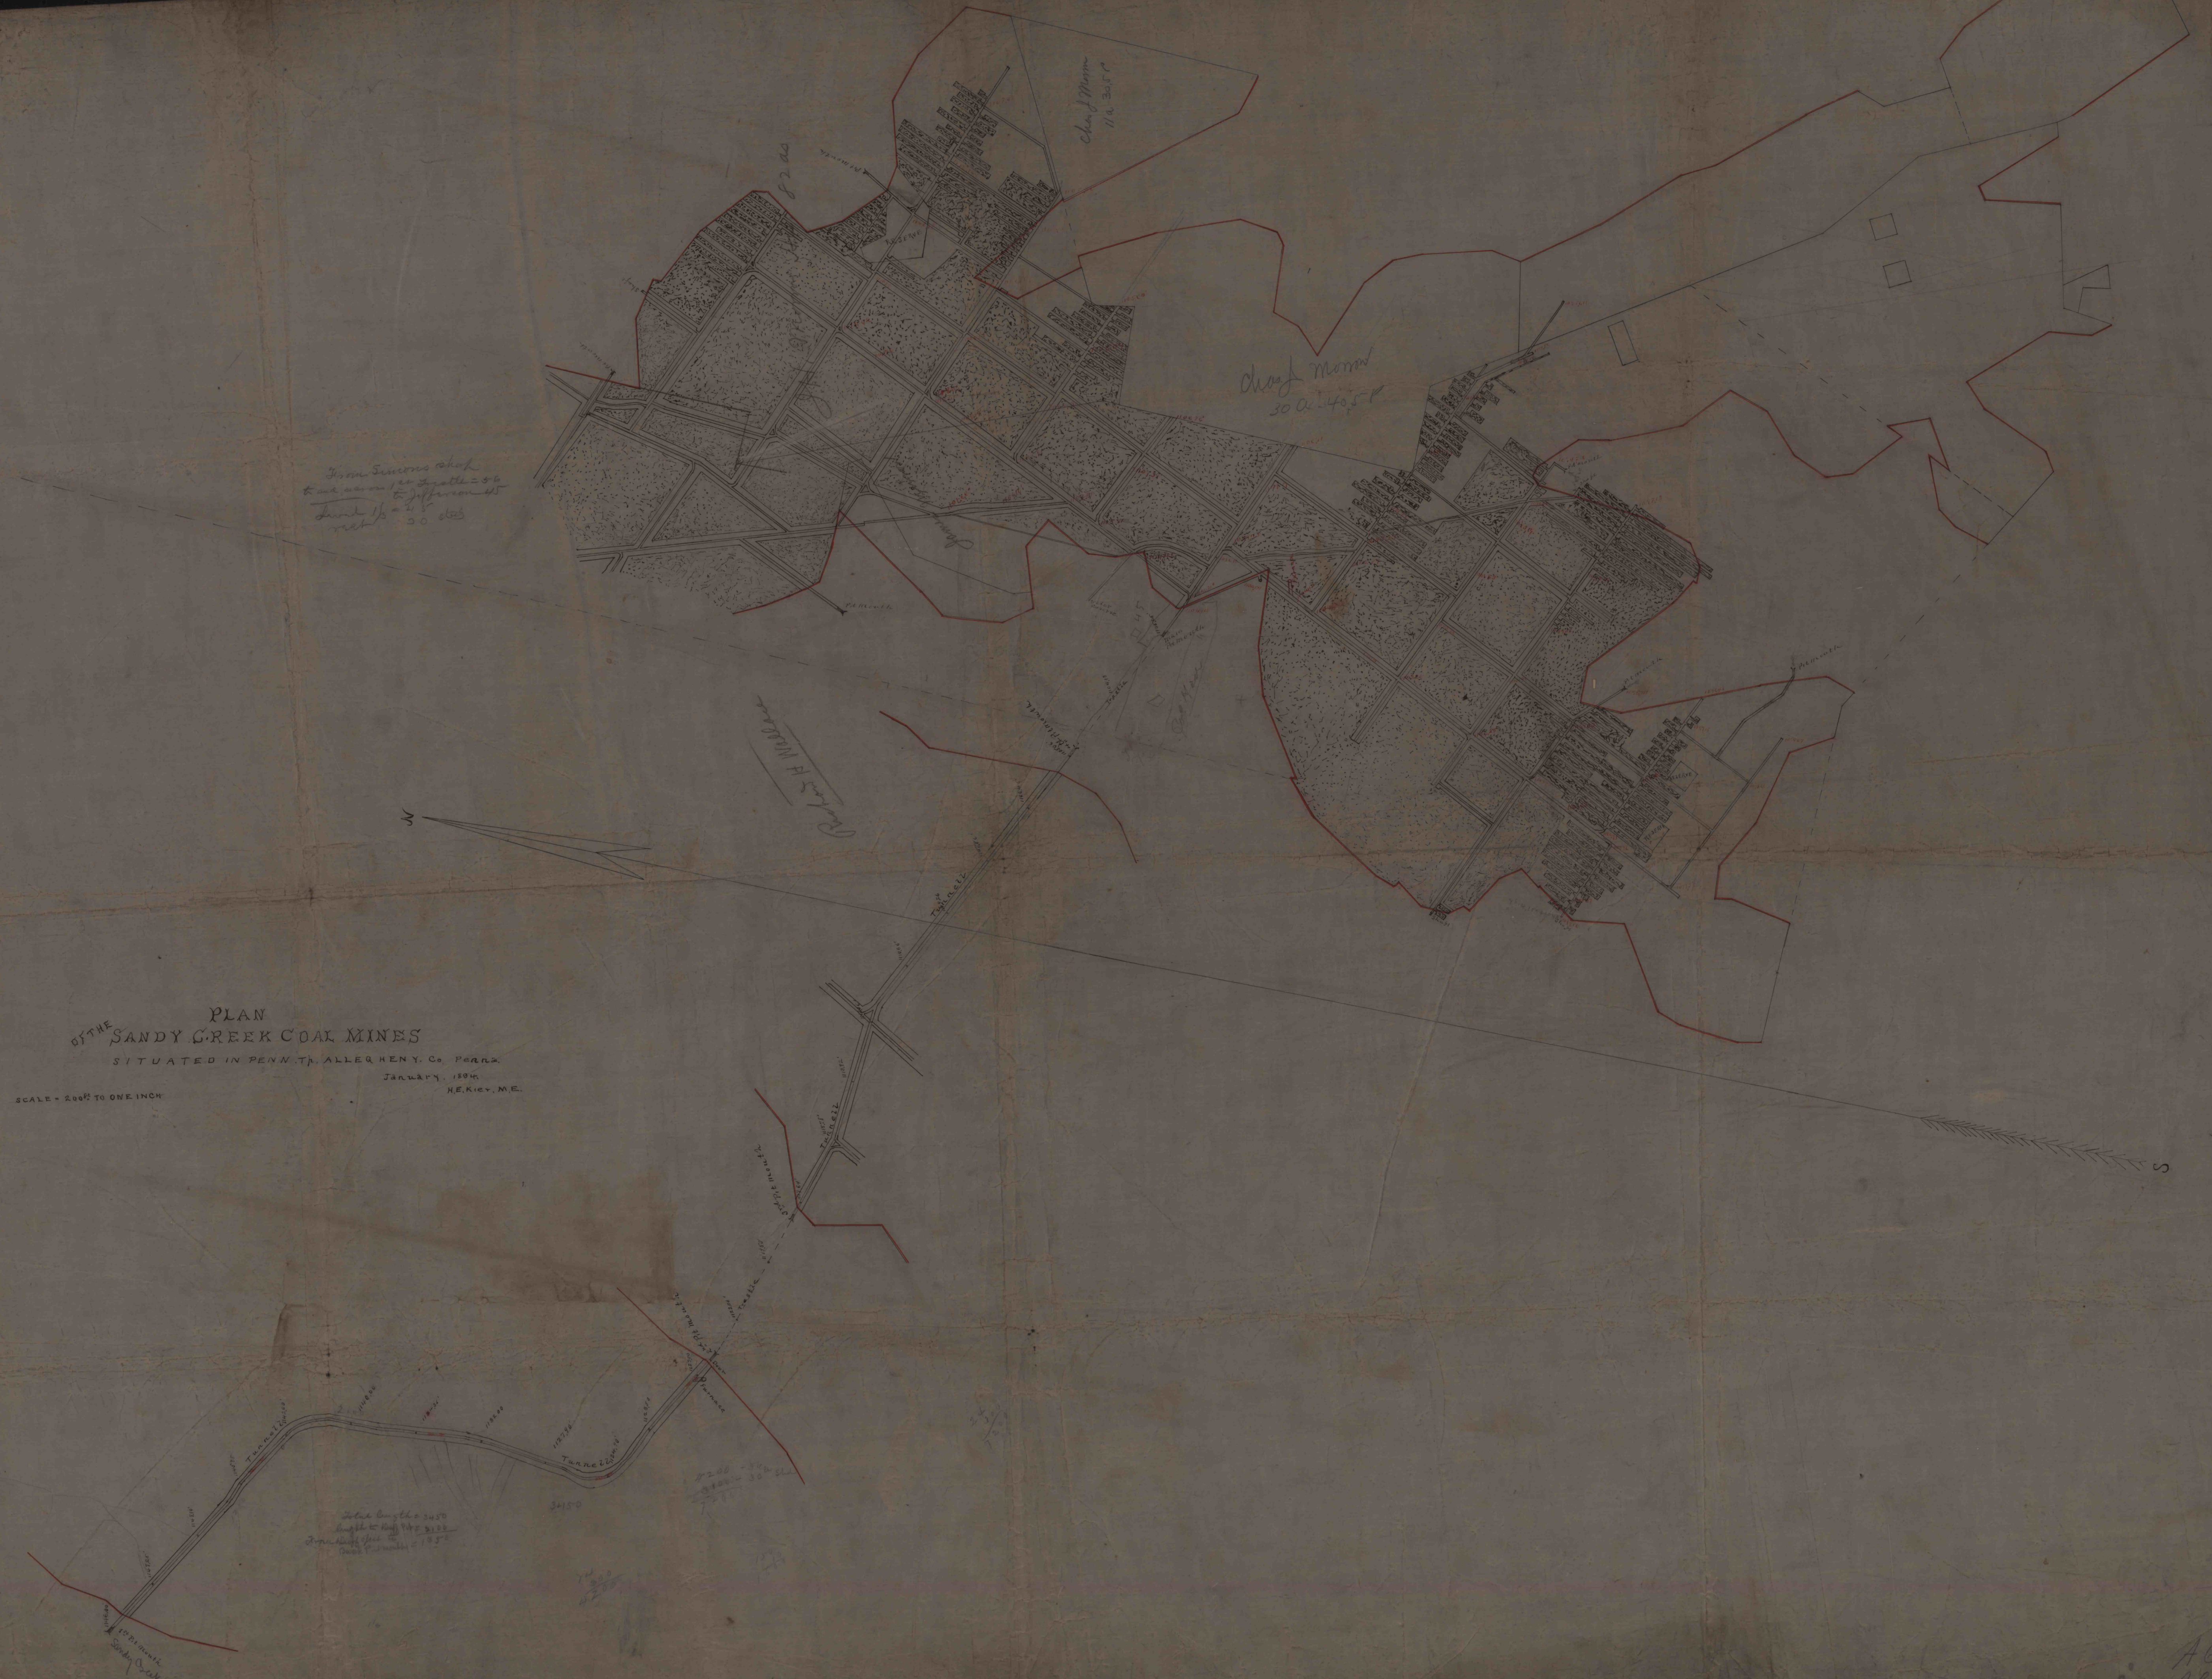

From Simpson's shop  
to the mine as shown  
to the mine  
about 1/2 mile  
about 30 days

Chas. J. Morris  
30 A. 40 5 6

Chas. J. Morris  
11 A. 3 4 5 6

A-694  
Sh. 3

A694-0-14  
Sheet 3