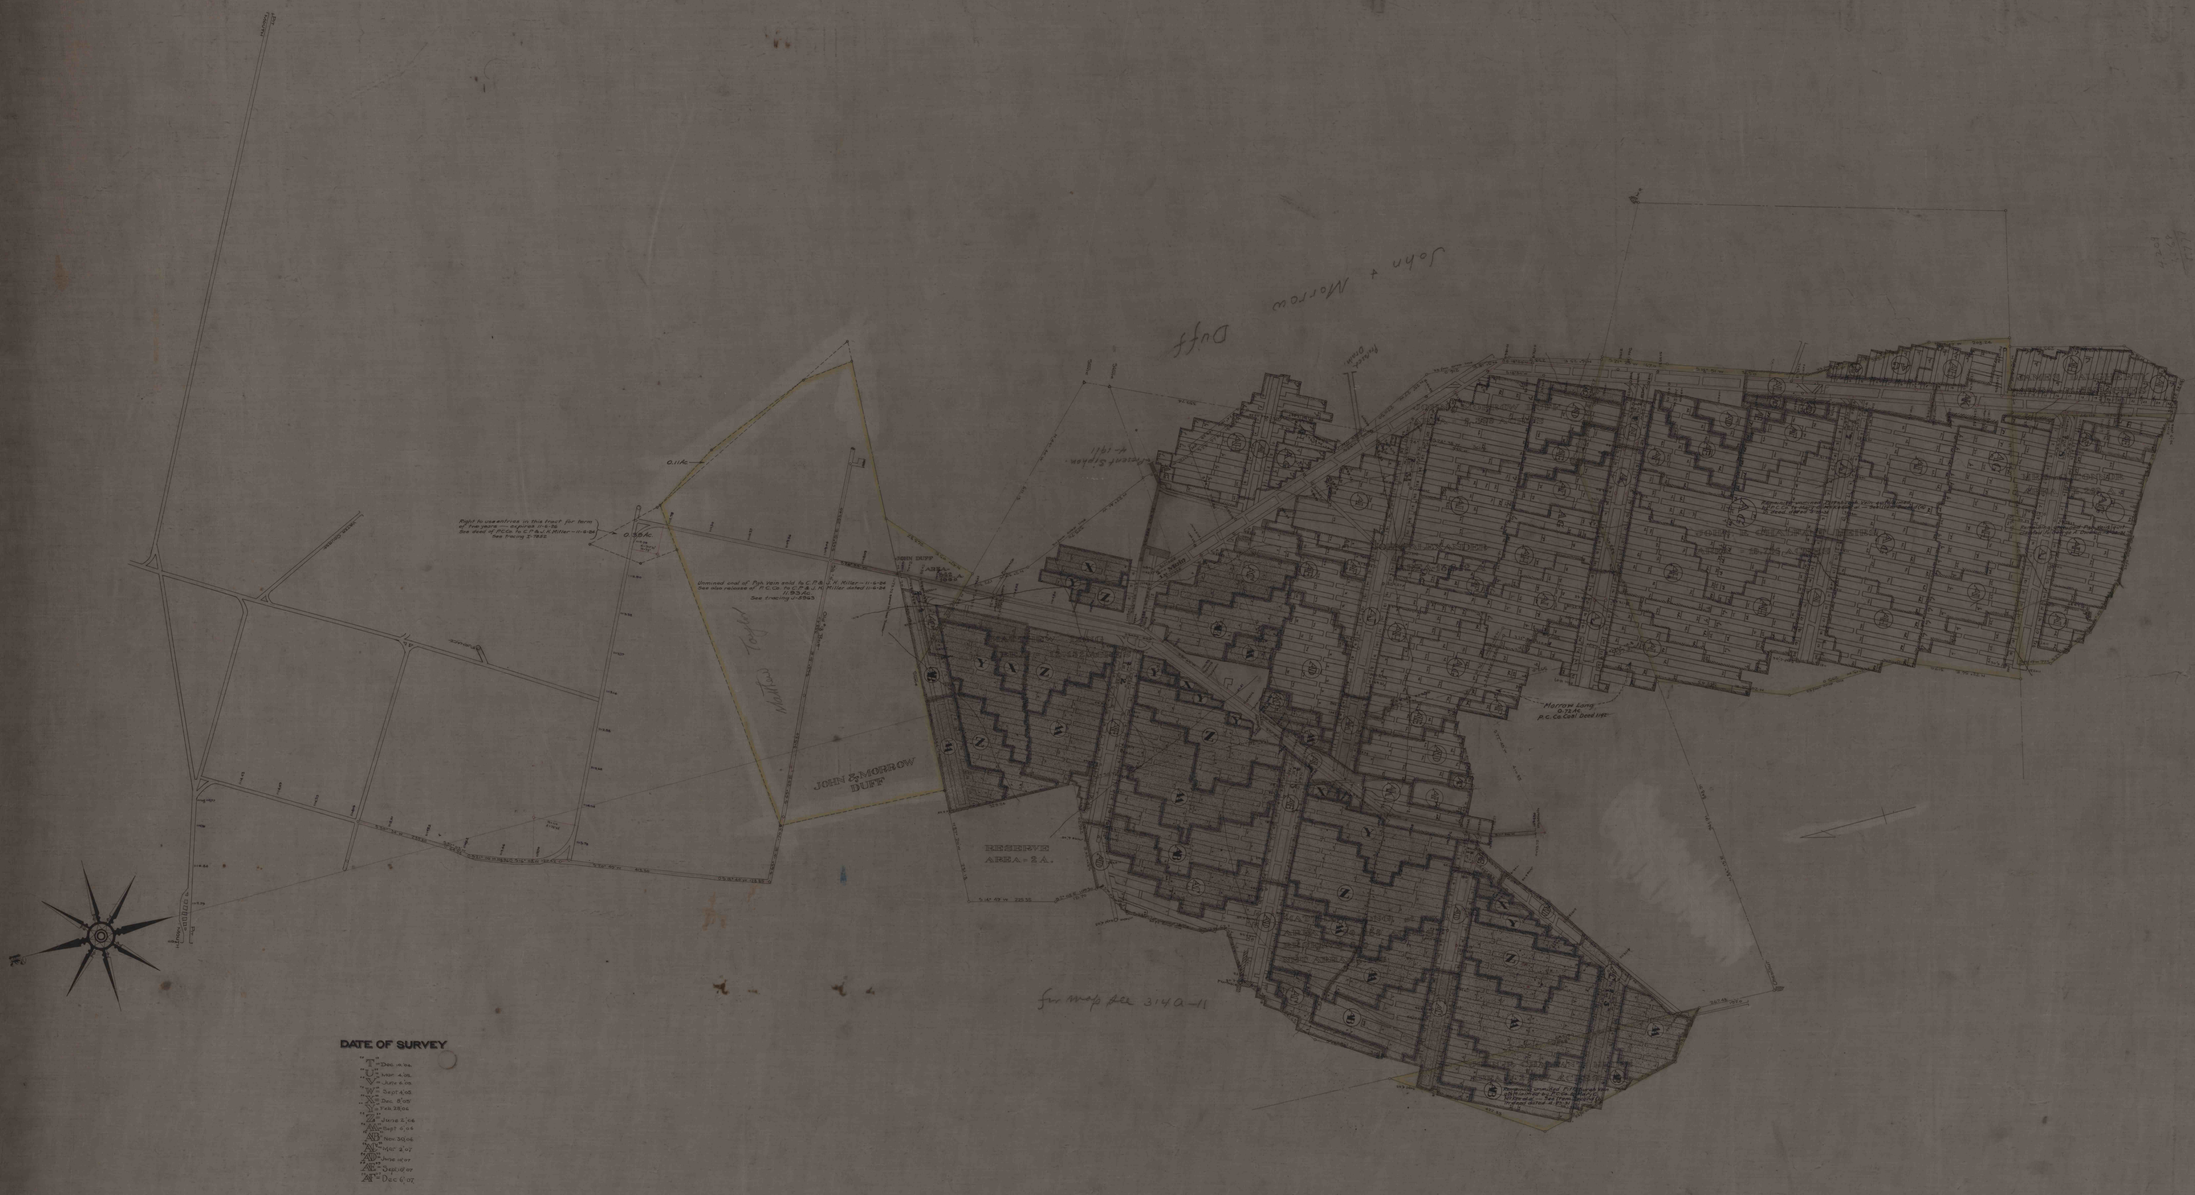

PLAN
showing
THIRD SECTION
SANDY CREEK MINE
situated in
PENN TWP. ALLEGHENY CO. PA.
Scale 1 inch = 100 feet

680-0-14

A-680