


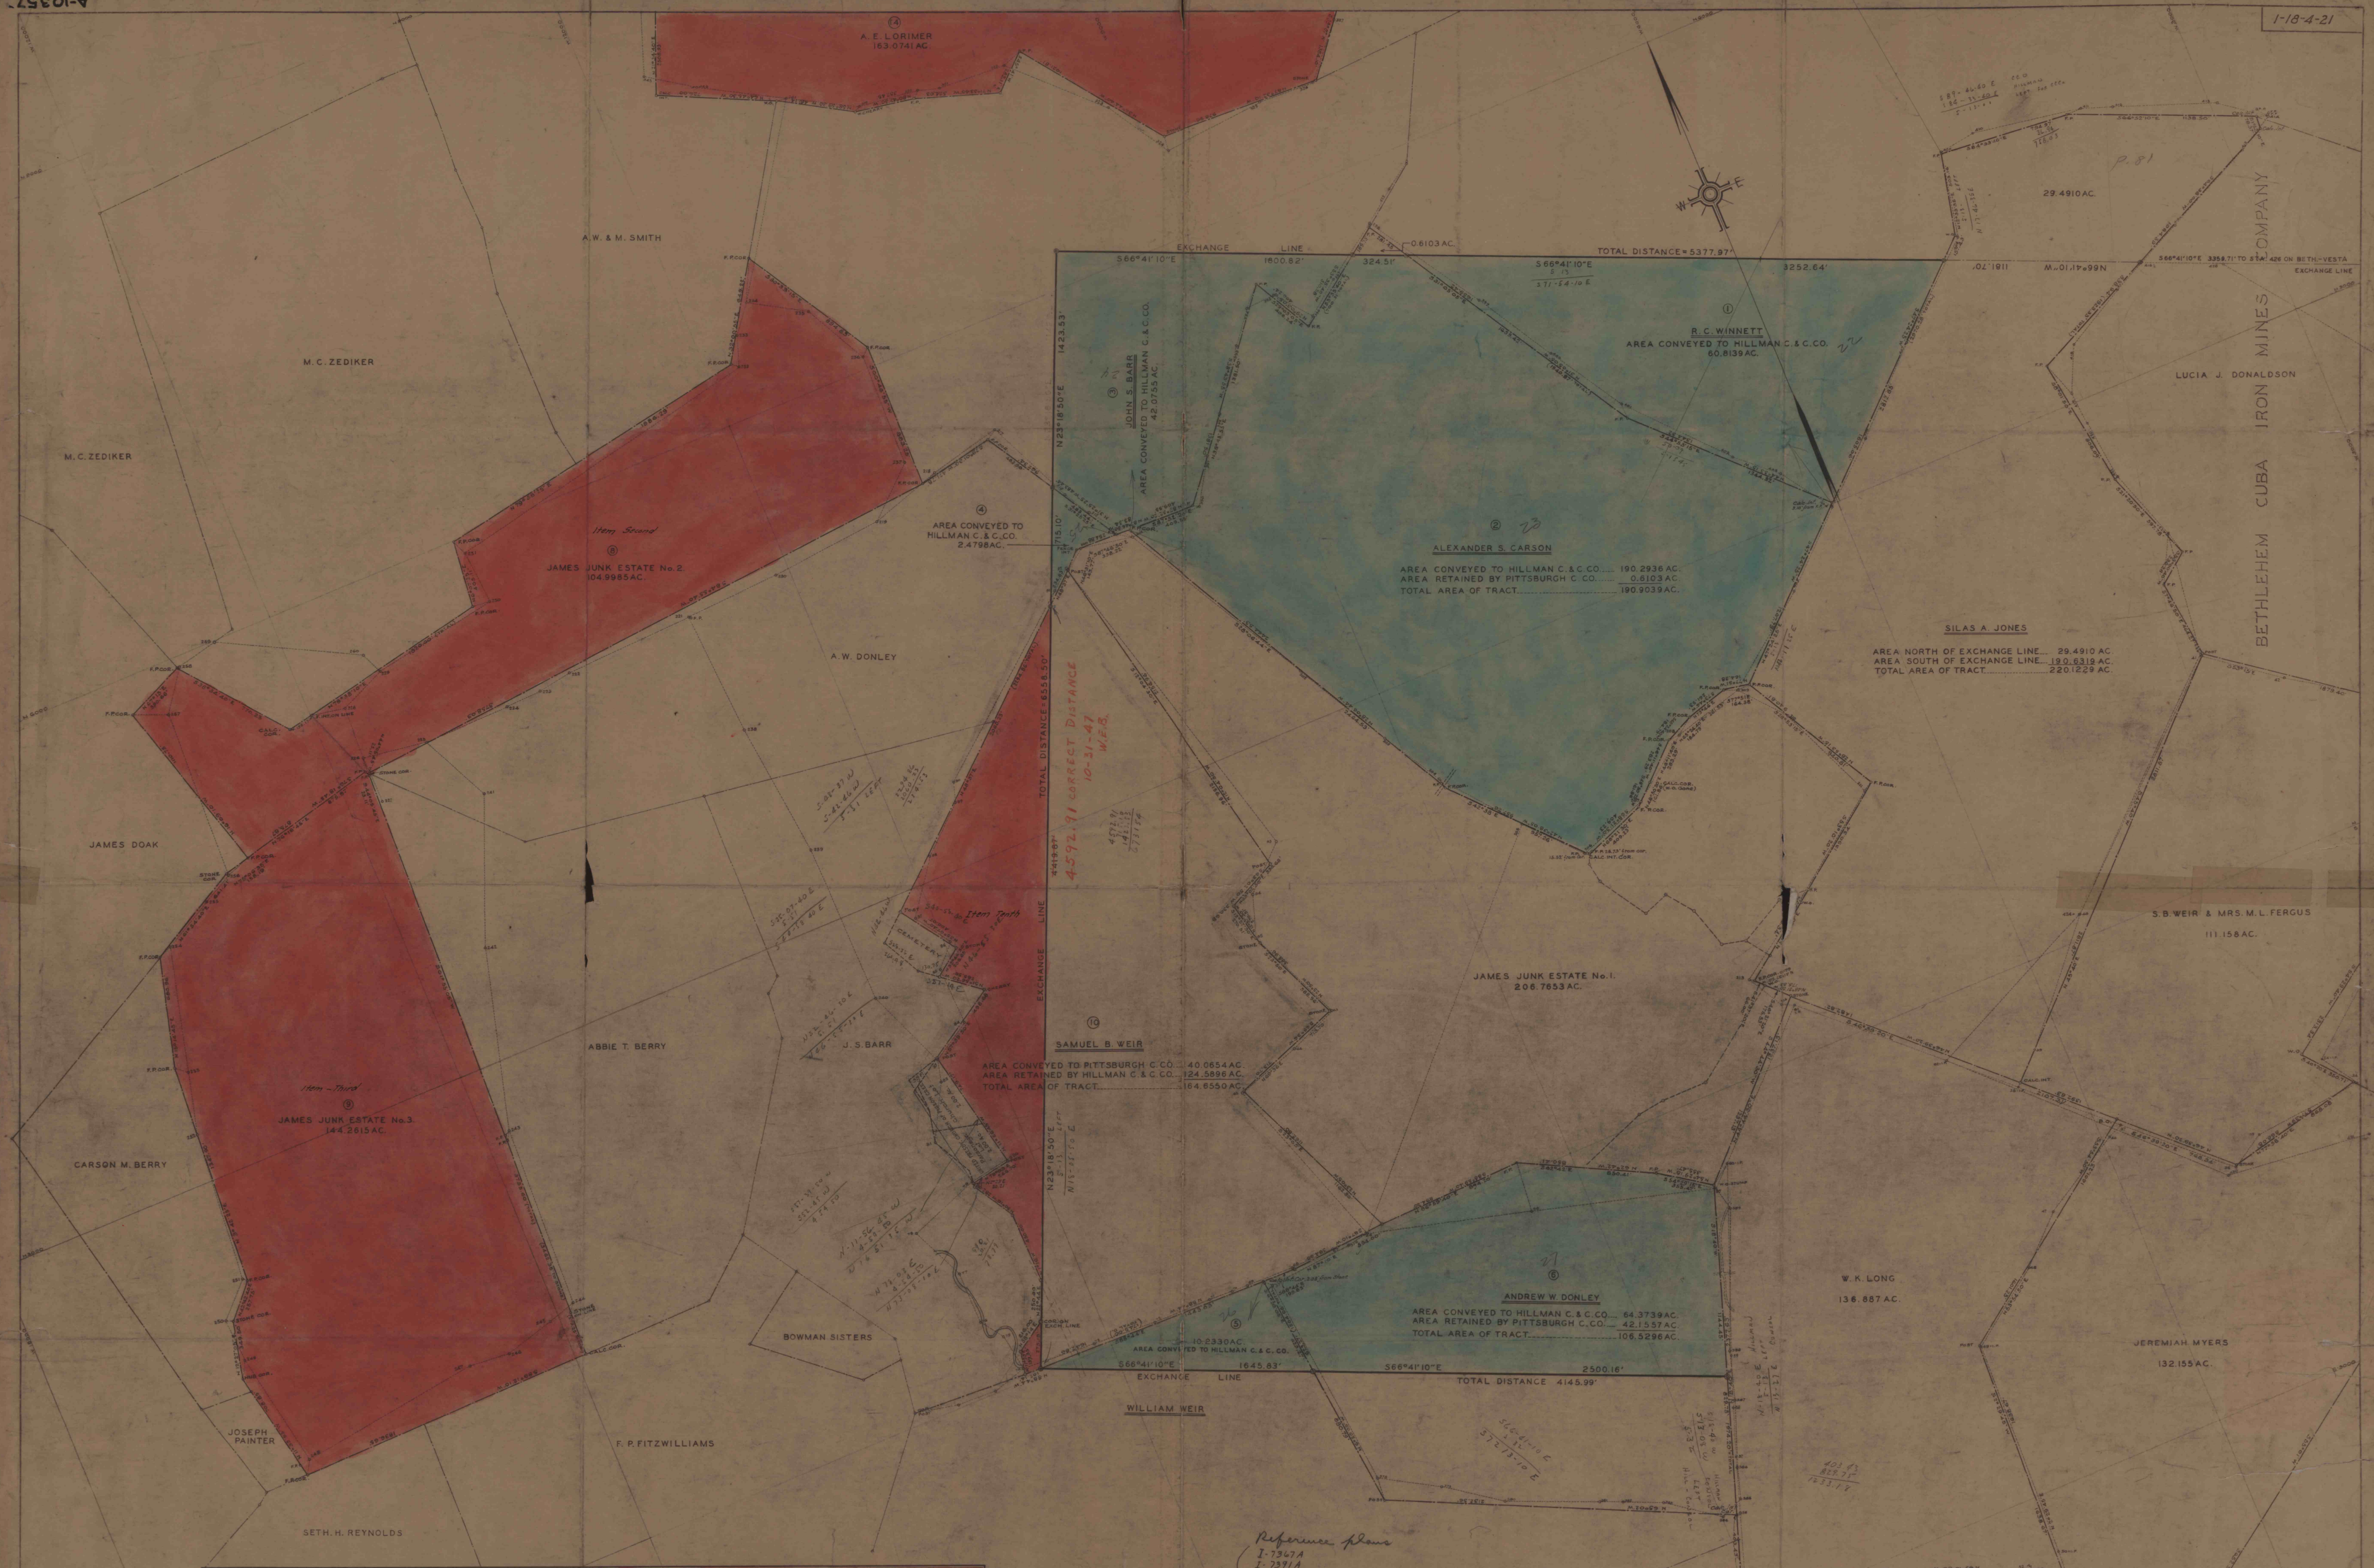

TOTAL DISTANCE 6556.30'
4592.71 CORRECT DISTANCE
10-31-47
M.E.B.

Reference Plans
I-7347A
I-7347B
I-7347C
I-7347MN
I-7347MO
I-7347MP
I-7347NO
I-7347NP
I-7347NQ
PITTSBURGH COAL CO. TO HILLMAN COAL & COKE CO.					HILLMAN COAL & COKE CO. TO PITTSBURGH COAL CO.				
No.	NAME OF TRACT	TOWNSHIP & COUNTY	DWG. No.	AREA	No.	NAME OF TRACT	TOWNSHIP & COUNTY	DWG. No.	AREA
1	R. C. WINNETT	SOMERSET TWP., WASH. CO.	1-18-4-21	60.8139	1	JAMES JUNK EST. No. 2	SO. STRABANE & SOMERSET	1-18-4-21	104.9985
2	ALEXANDER S. CARSON	" " " "	"	190.2936	2	JAMES JUNK EST. No. 3	SO. STRABANE TWP., WASH. CO.	"	144.2615
3	JOHN S. BARR	" " " "	"	42.0755	3	SAMUEL B. WEIR	SOMERSET " " " "	"	40.0654
4	A. W. DONLEY	" " " "	"	2.4796	4	C. L. SNOWDON EST.	NOTTINGHAM " " " "	3-1-30-136	91.9828
5	WILLIAM WEIR	" " " "	"	10.2330	5	HUGH BARR (WM. KNOX)	SOMERSET " " " "	"	144.3359
6	ANDREW W. DONLEY	NO. BETH. TWP., WASH. CO.	"	64.3739	6	J. T. ALLEN	NO. STRABANE & SOMERSET	"	186.3827
				585.9843	7	A. E. LORIMER (WM. KNOX)	SOMERSET TWP., WASH. CO.	"	163.0741
					8	JAMES SIMONS No. 1	SO. STRABANE " " " "	"	68.2423
					9	JAMES SIMONS No. 2	" " " "	"	10.1586
					10	RALPH B. BUSH	SOMERSET TWP. WASH. CO.	"	2.7520
TOTAL				956.2540	TOTAL				956.2540

BETHLEHEM CUBA IRON MINES CO.

HILLMAN COAL & COKE CO.	
PITTSBURGH PA.	
PROPOSED EXCHANGE	
Hillman C. & C. Co. - Pittsburgh Coal Co.	
at Westerly end of Eighty-Four Field	
Somerset Twp., Washington Co., Penna.	
Drawn C.D.S.	Traced
Checked D.W.	Date 12-15-17
Approved	File No. 218-4-21
Sheet No. 1 of 1	