




RECORD OF #1 ECHARD GAS WELL
Near Greengarden.
GREENSBORO GAS CO.

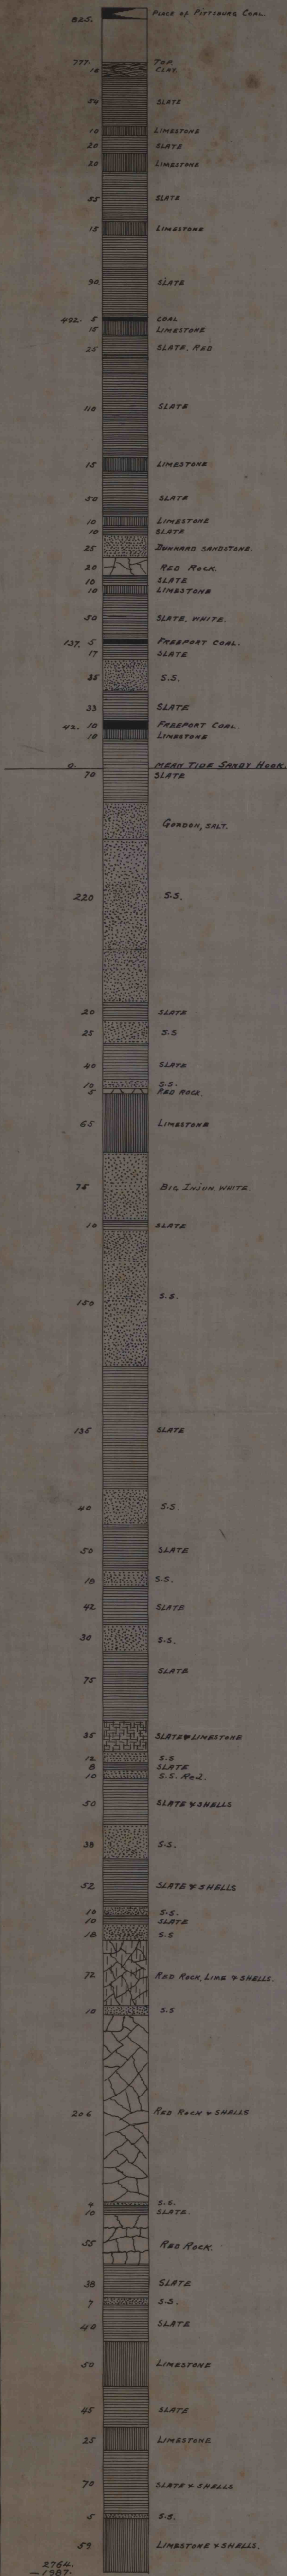

RECORD OF #4 BIG SMITH GAS WELL
Near Greengarden.
GREENSBORO GAS CO.

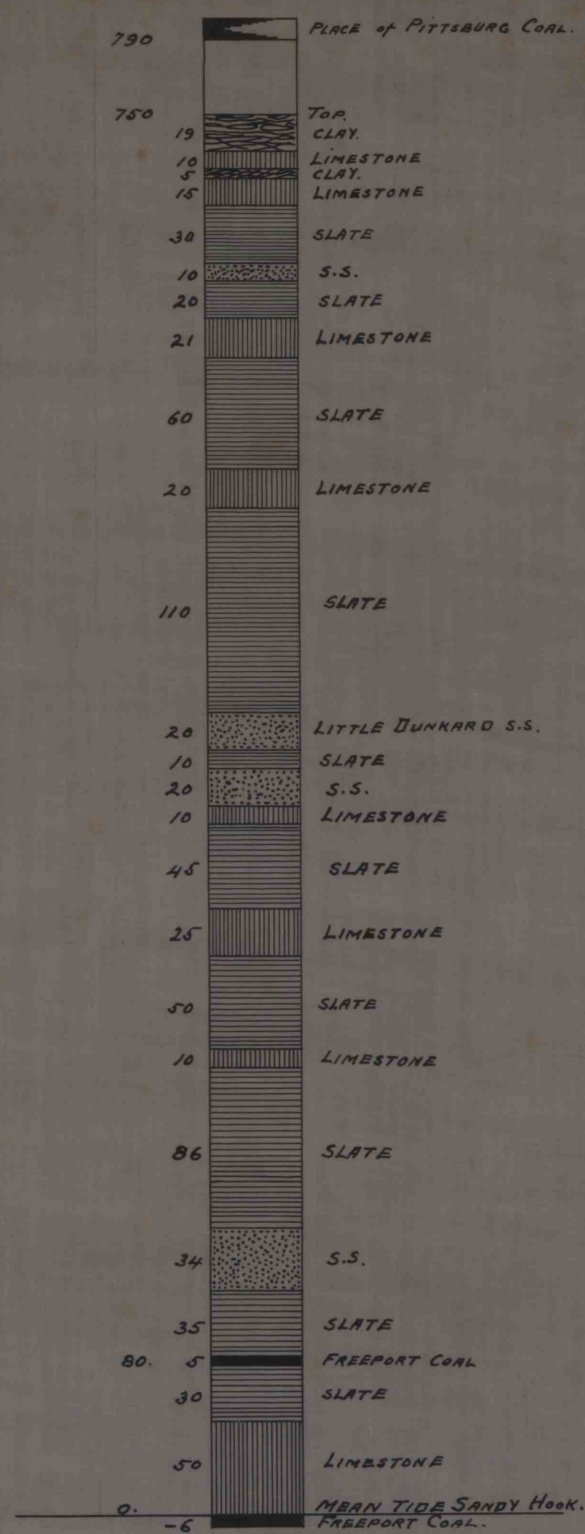

RECORD OF #2 ECHARD GAS WELL
Near Greengarden.
GREENSBORO GAS CO.

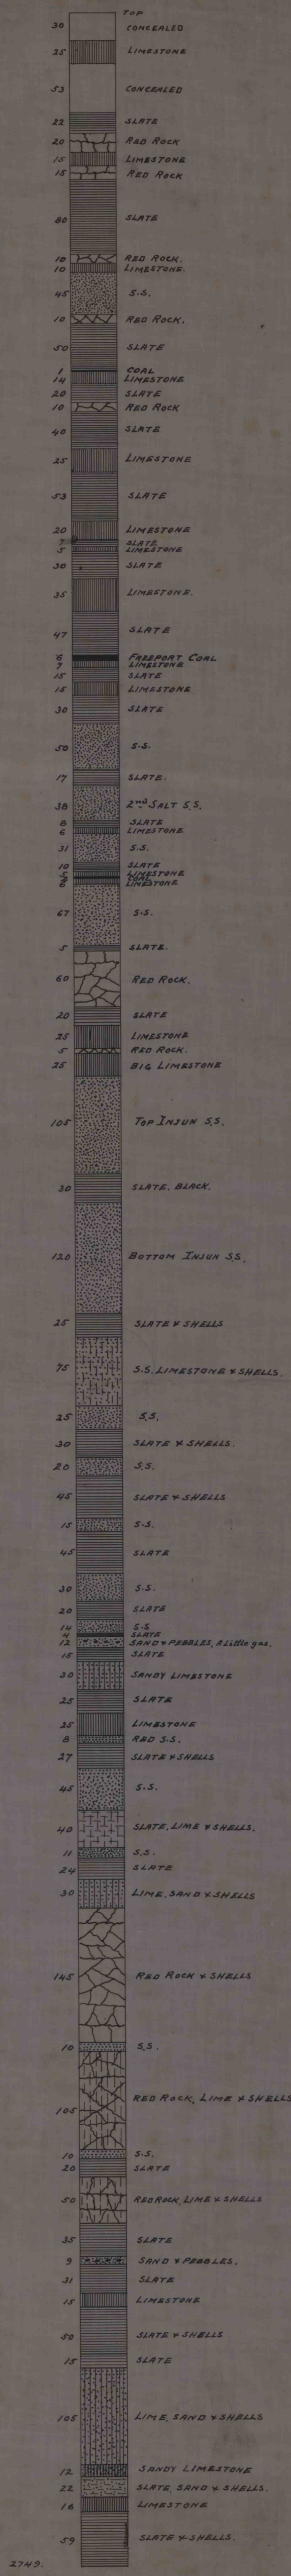

RECORD OF #2 LOWEN GAS WELL
PENN GAS COAL CO.

