


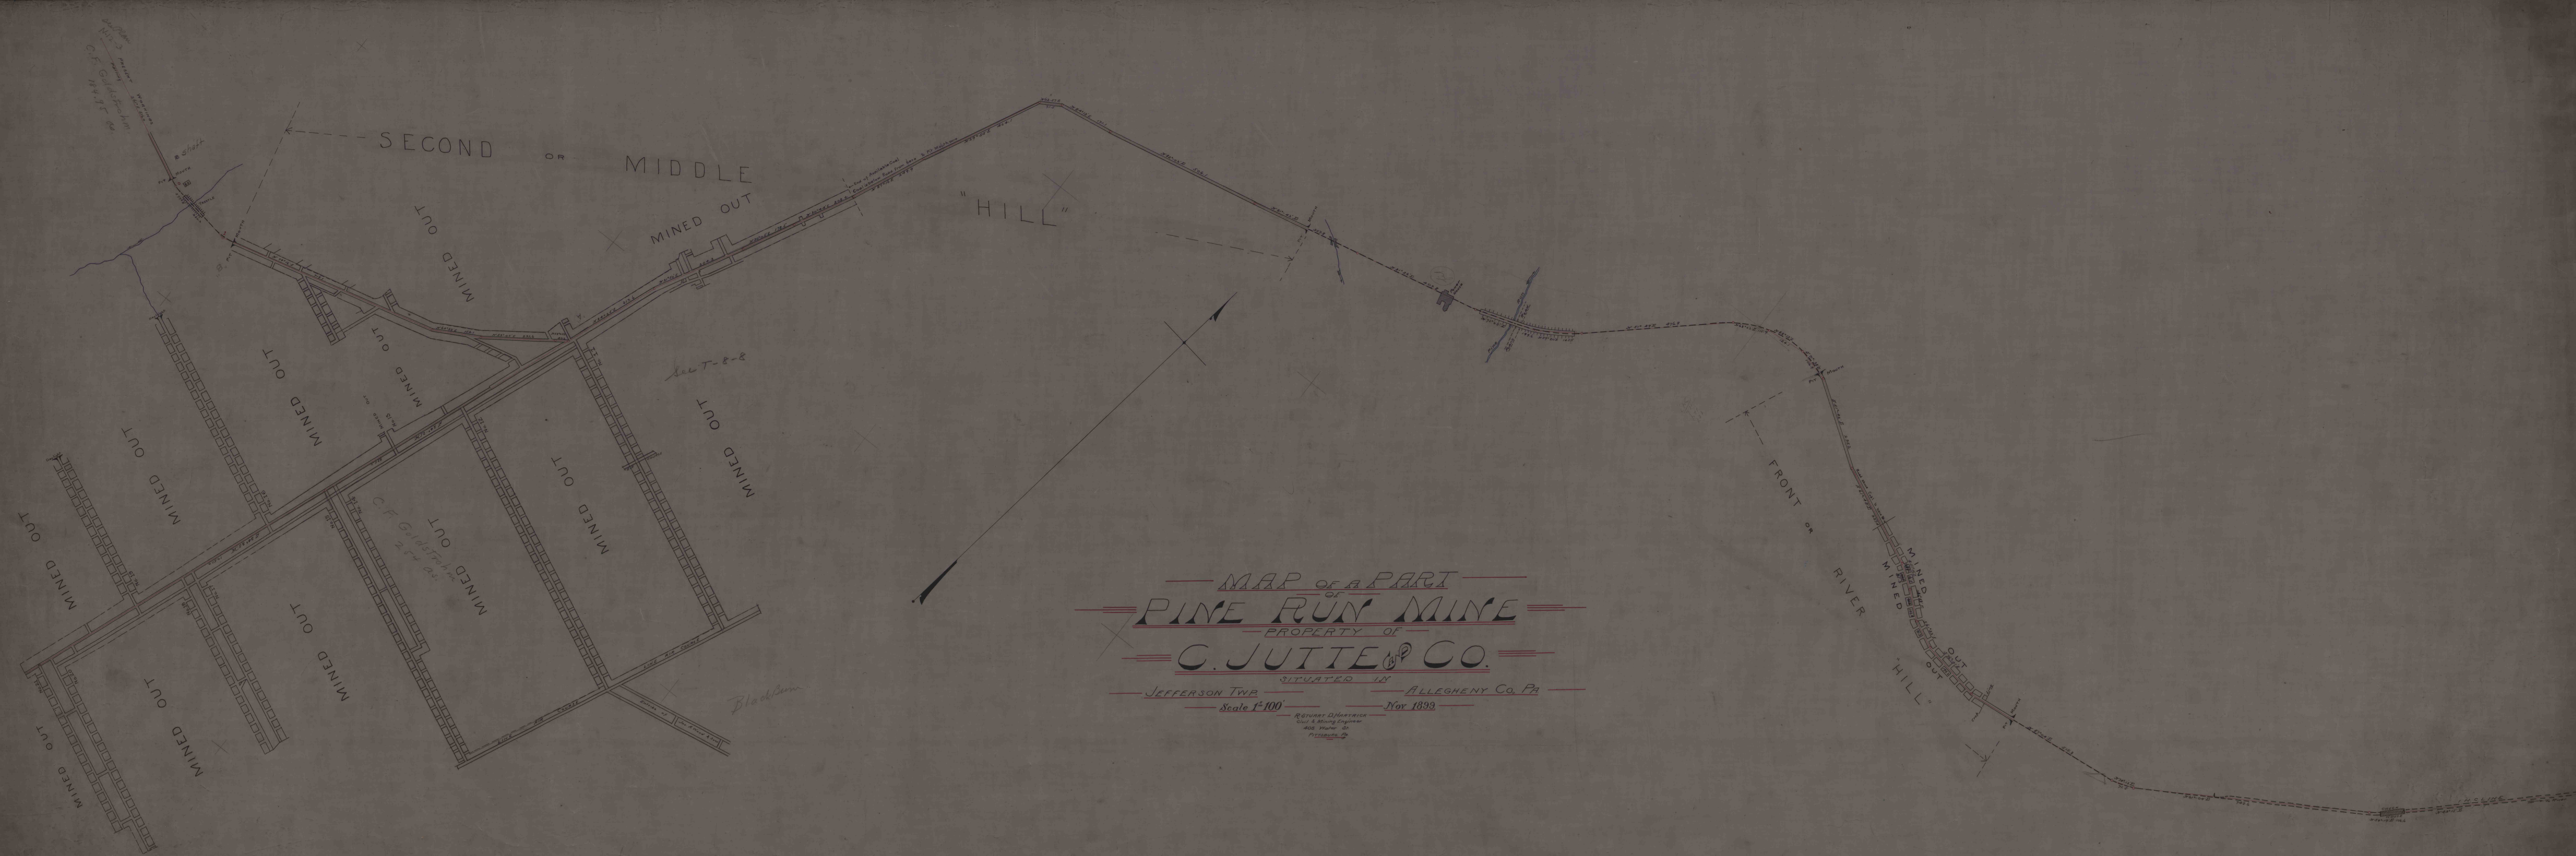

— MAP OF A PART —
PINE RUN MINE
PROPERTY OF
C. JUTTE & CO.
SITUATED IN
JEFFERSON TWP ALLEGHENY CO., PA.
Scale 1"=100' Nov 1893
ROBERT D. HARTWICK
Civil & Mining Engineer
408 Water St.
PITTSBURGH, PA.