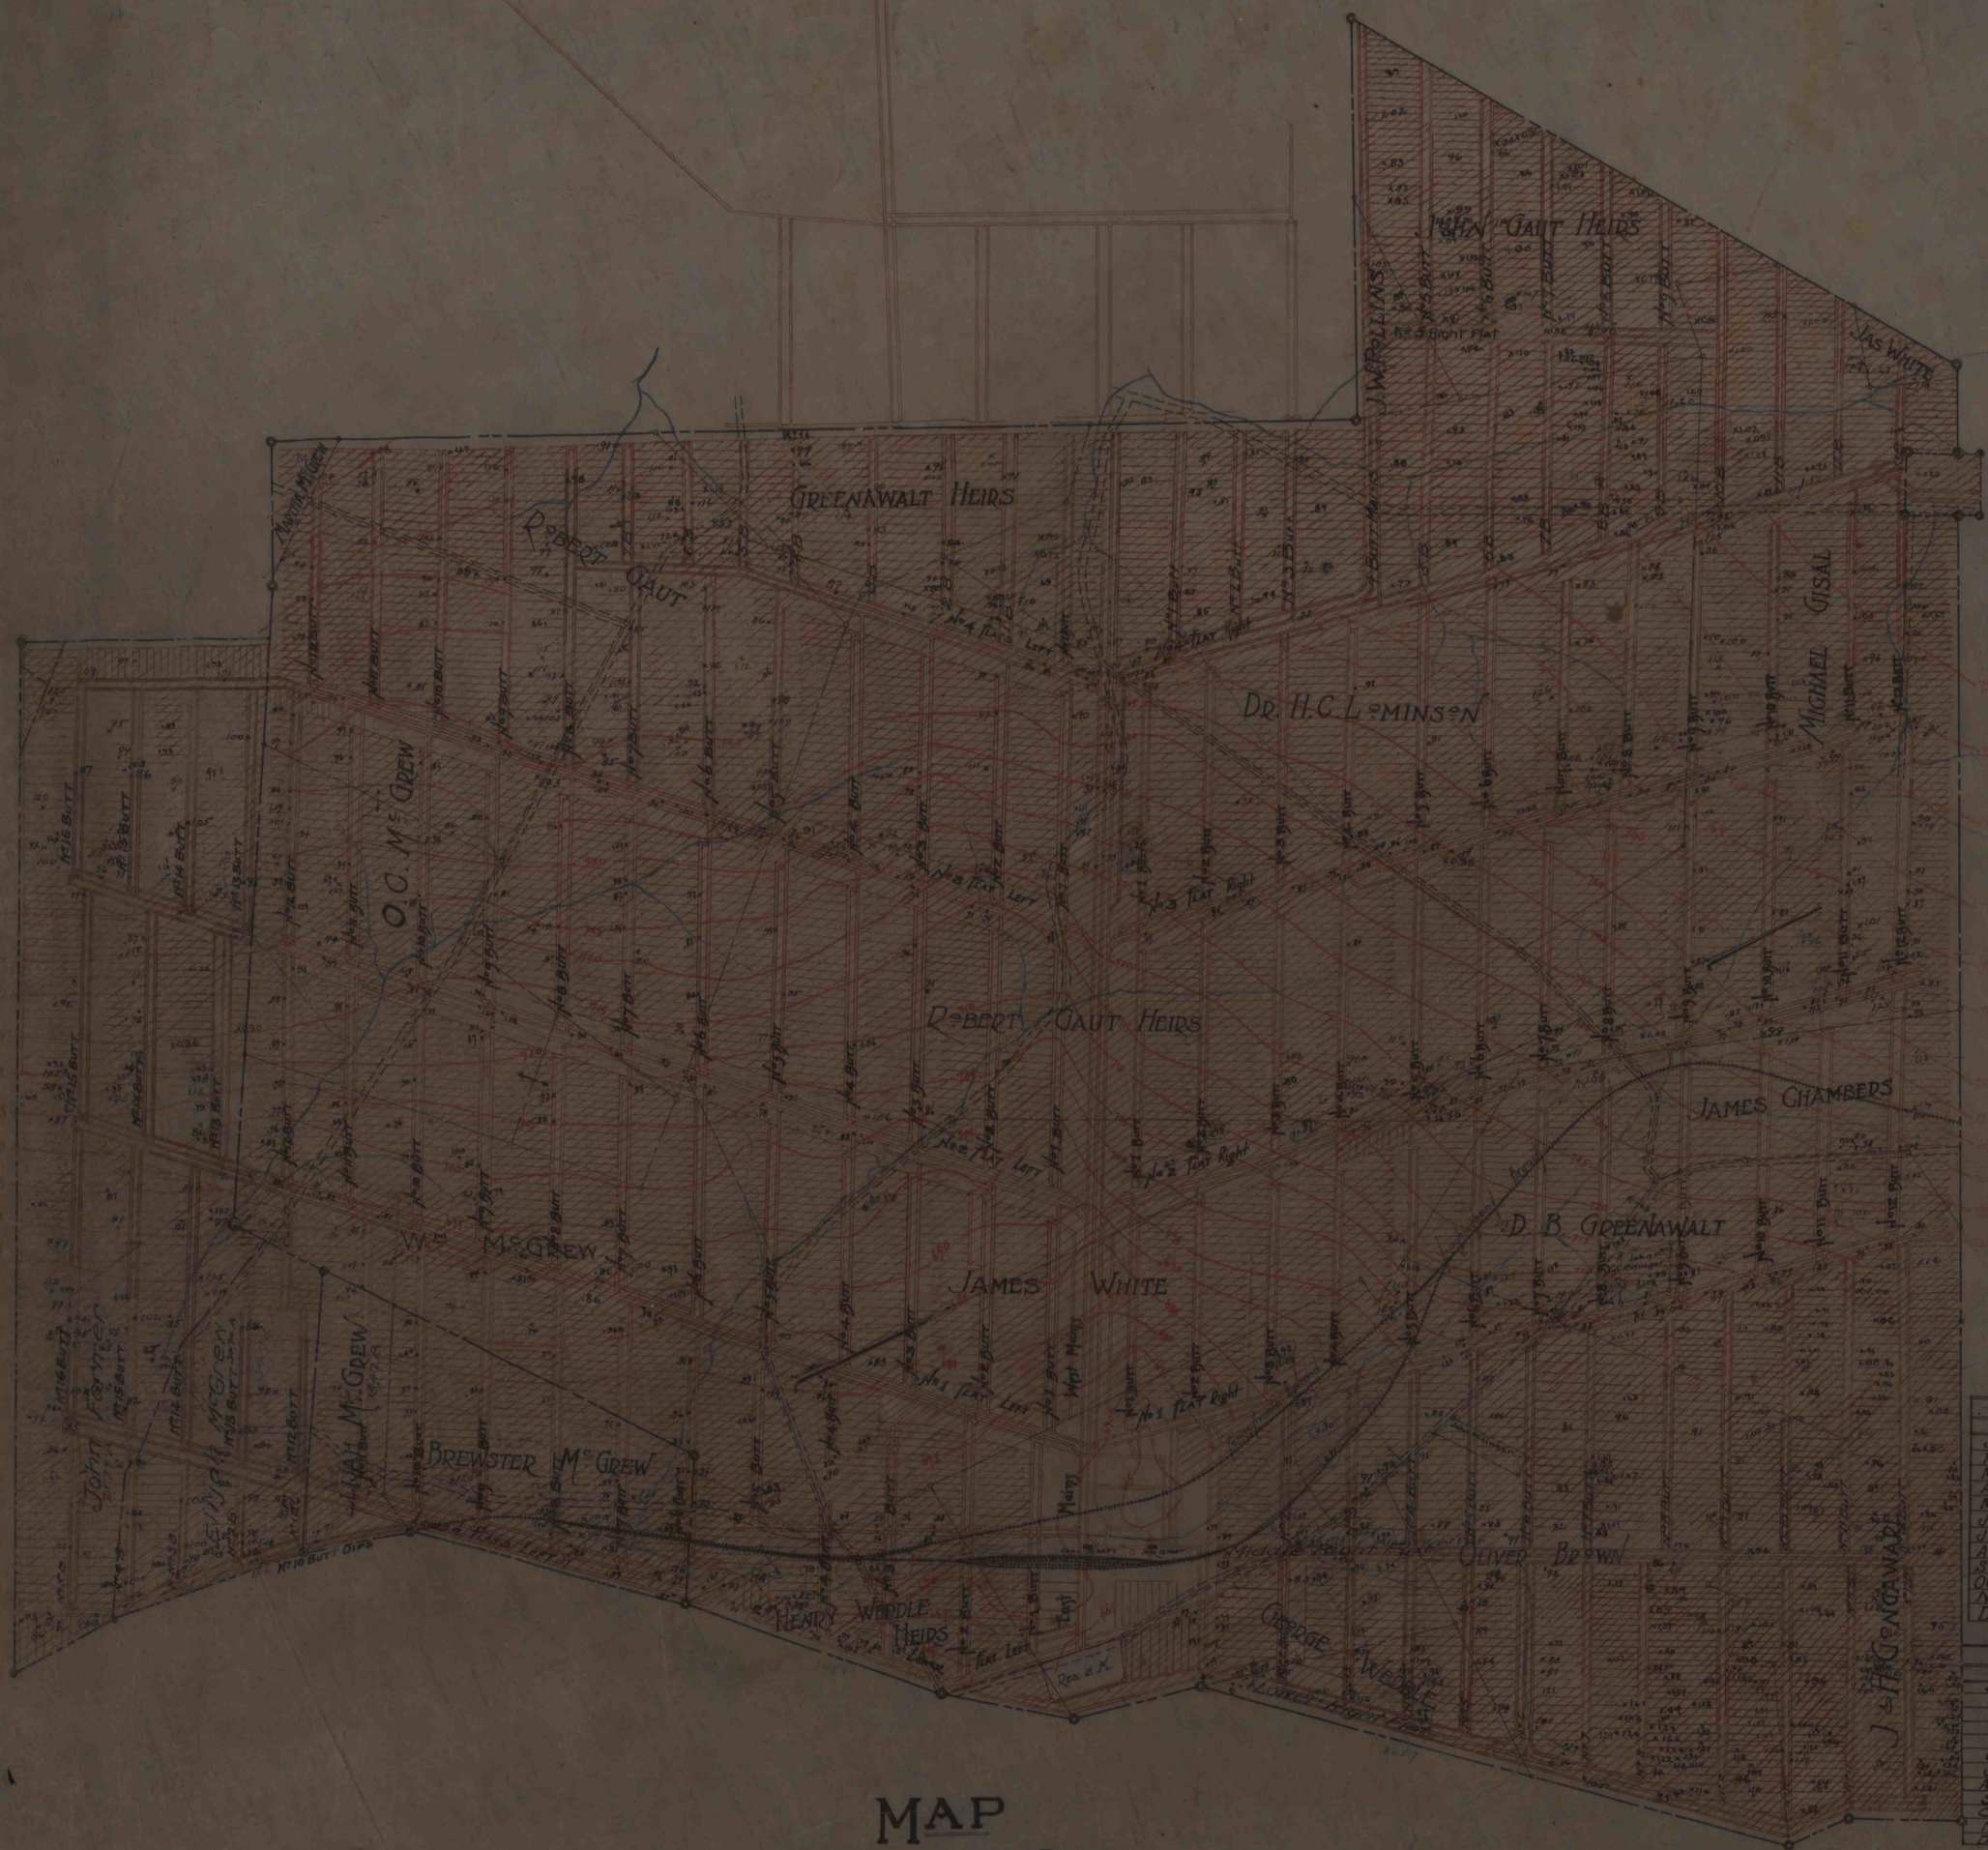

MAP

— OF —

RILEY MINE WORKINGS

FOR

Chemist Reports

SCALE 500'=1'

Westmoreland Coal Co
Irwin, Pa.
G.T. Lewis, Chief Eng.

DATE of ANALYSES	1935	1936	1937	1938	1939	1940	1941
JANUARY							
FEBRUARY							
MARCH							
APRIL							
MAY							
JUNE							
JULY							
AUGUST							
SEPTEMBER	11						
OCTOBER							
NOVEMBER							
DECEMBER							

DATE of ANALYSES	1929	1930	1931	1932	1933	1934
JANUARY			23	22		
FEBRUARY						2
MARCH						
APRIL	9					
MAY		23				
JUNE						
JULY						
AUGUST						
SEPTEMBER						
OCTOBER	14					
NOVEMBER						
DECEMBER						

DATE of ANALYSES

	1908	1907	1906	1905	1904	1903	1902	1901	1900	1899	1898	1897	1896	1895	1894	1893	1892	1891	1890	1889
JANUARY		22	13									11		24			28			48
FEBRUARY		22	9	11					6					23						
MARCH		29		25		21	15				6			24						
APRIL		15	4	19						13				24						
MAY		10		15	19							18				21				
JUNE		24	29		15	19				12										
JULY		5		6						20										
AUGUST		30	31	12		26	13		-	31	21									
SEPTEMBER				29	15								4							
OCTOBER	20	1	29															6		
NOVEMBER		2	18	2						18										
DECEMBER	22		25 30		13	6		11				28				16				48