


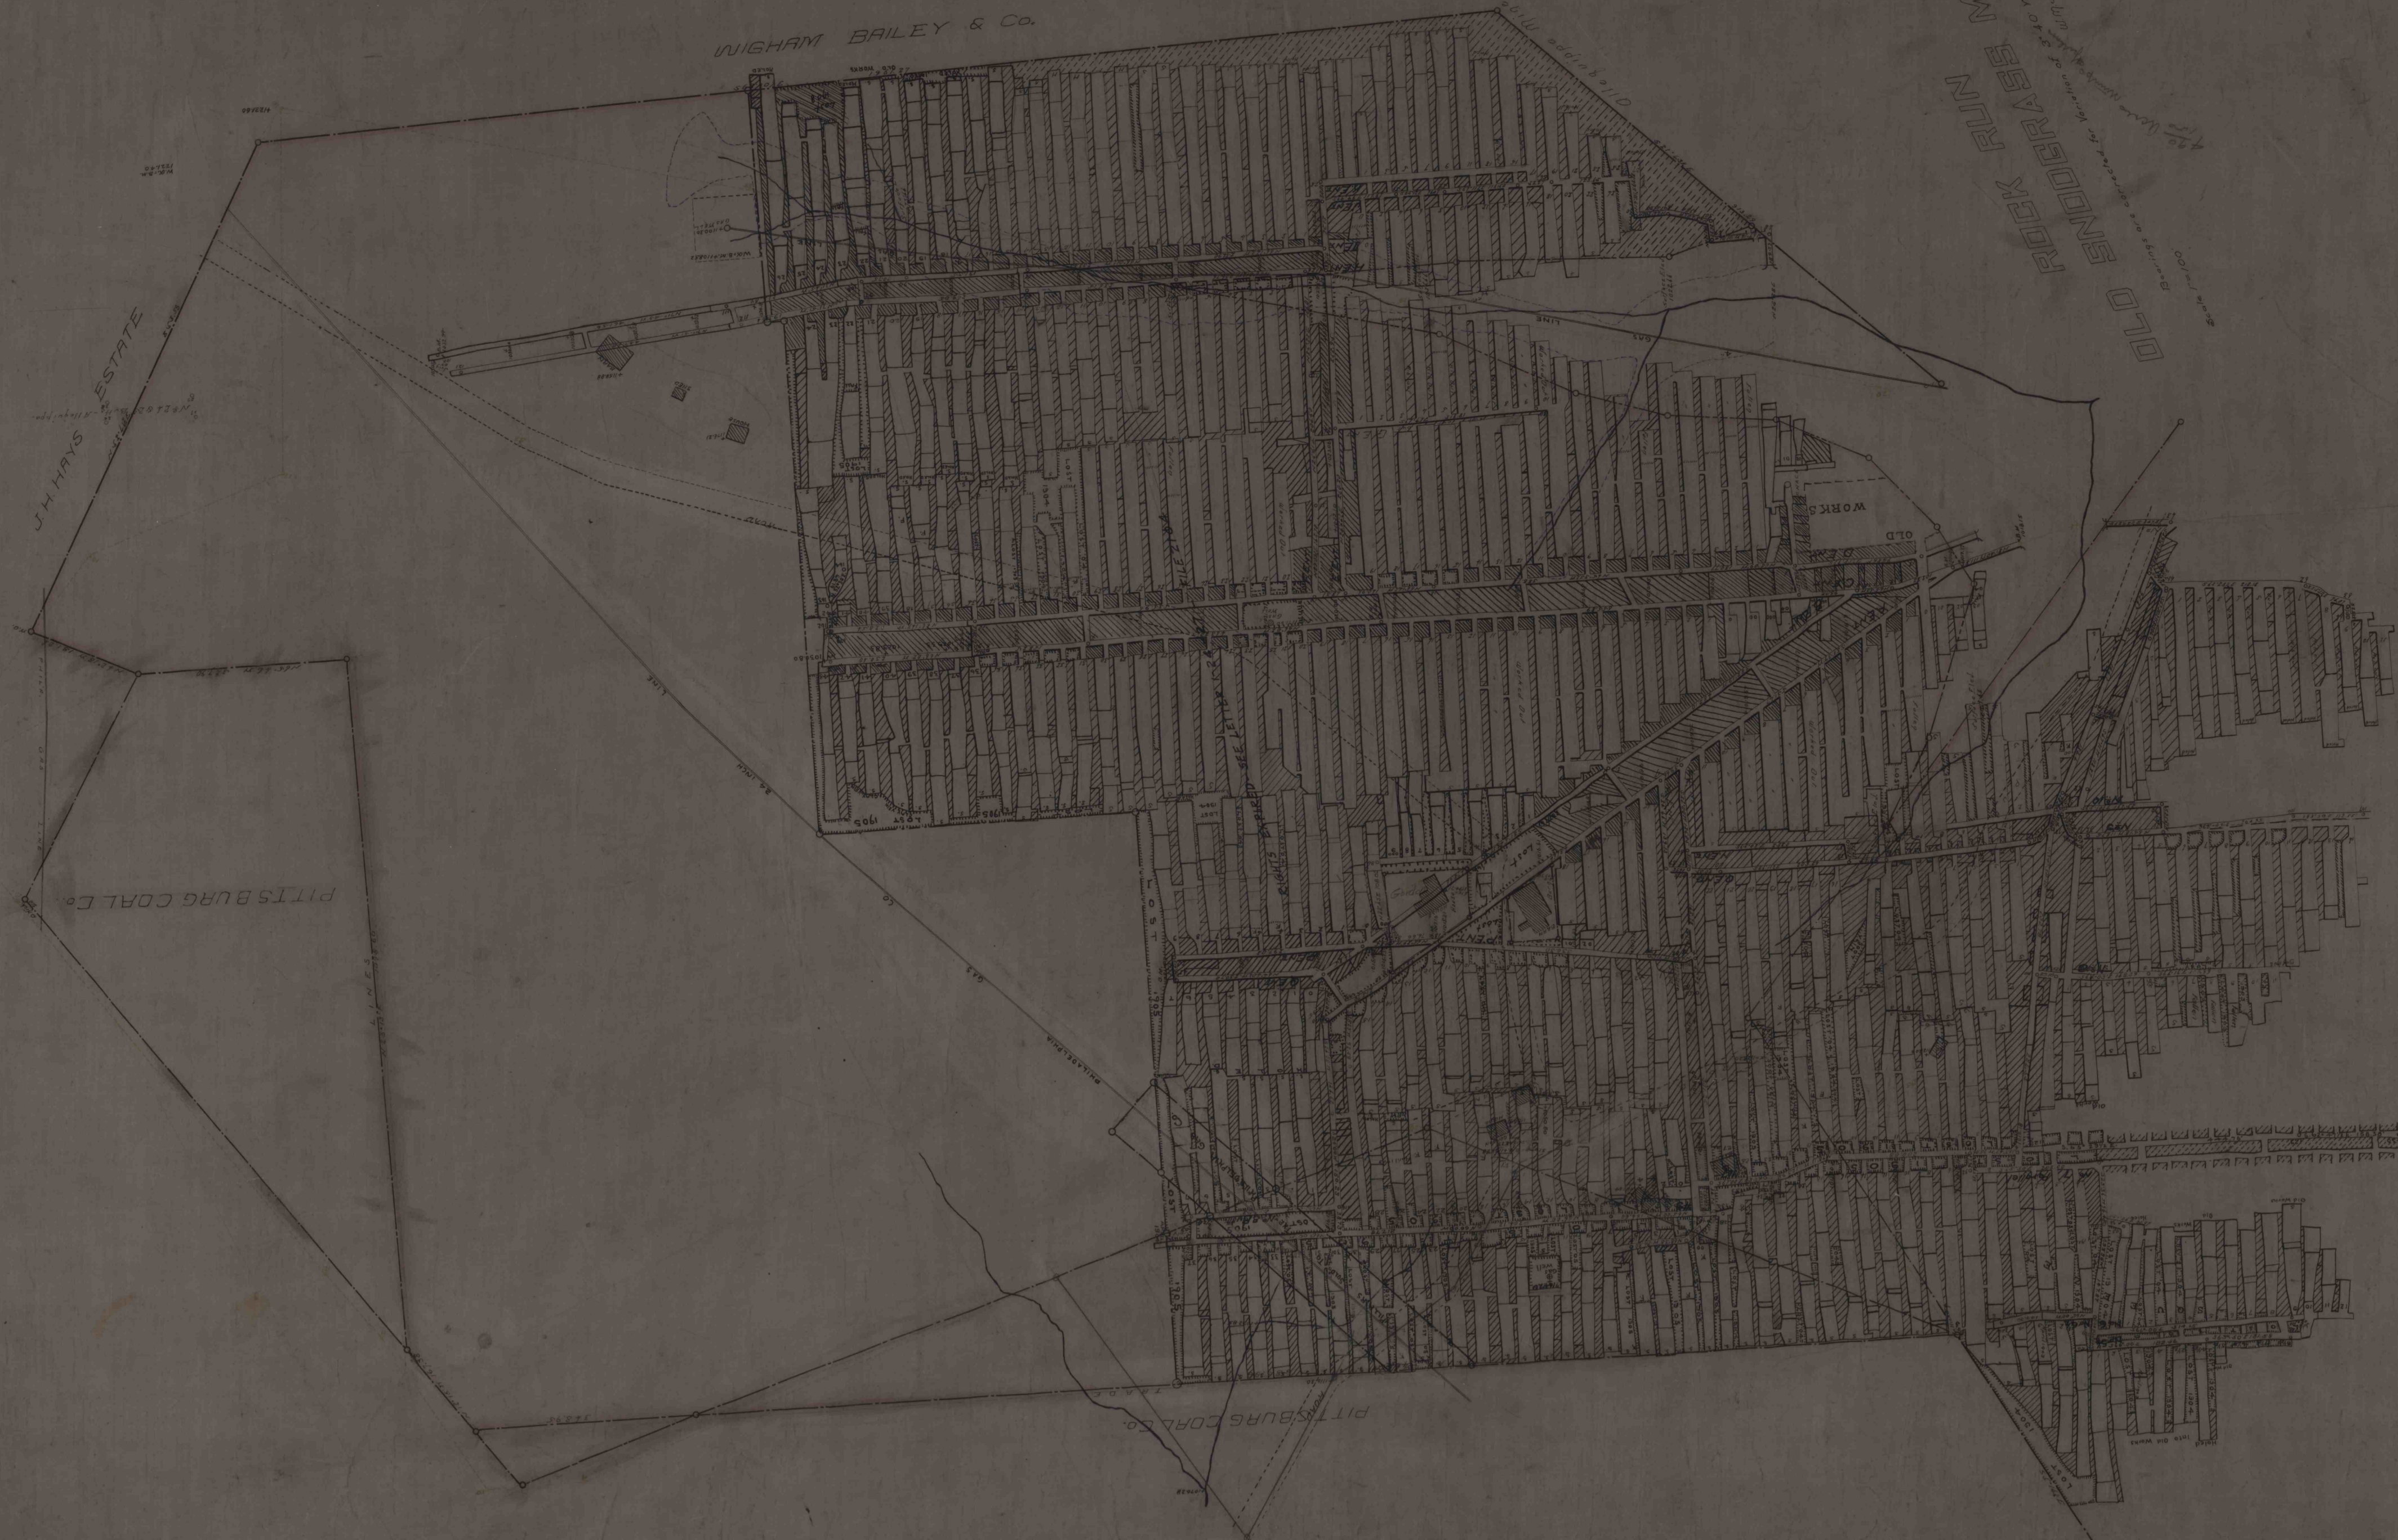

KEEP WITH P-13