


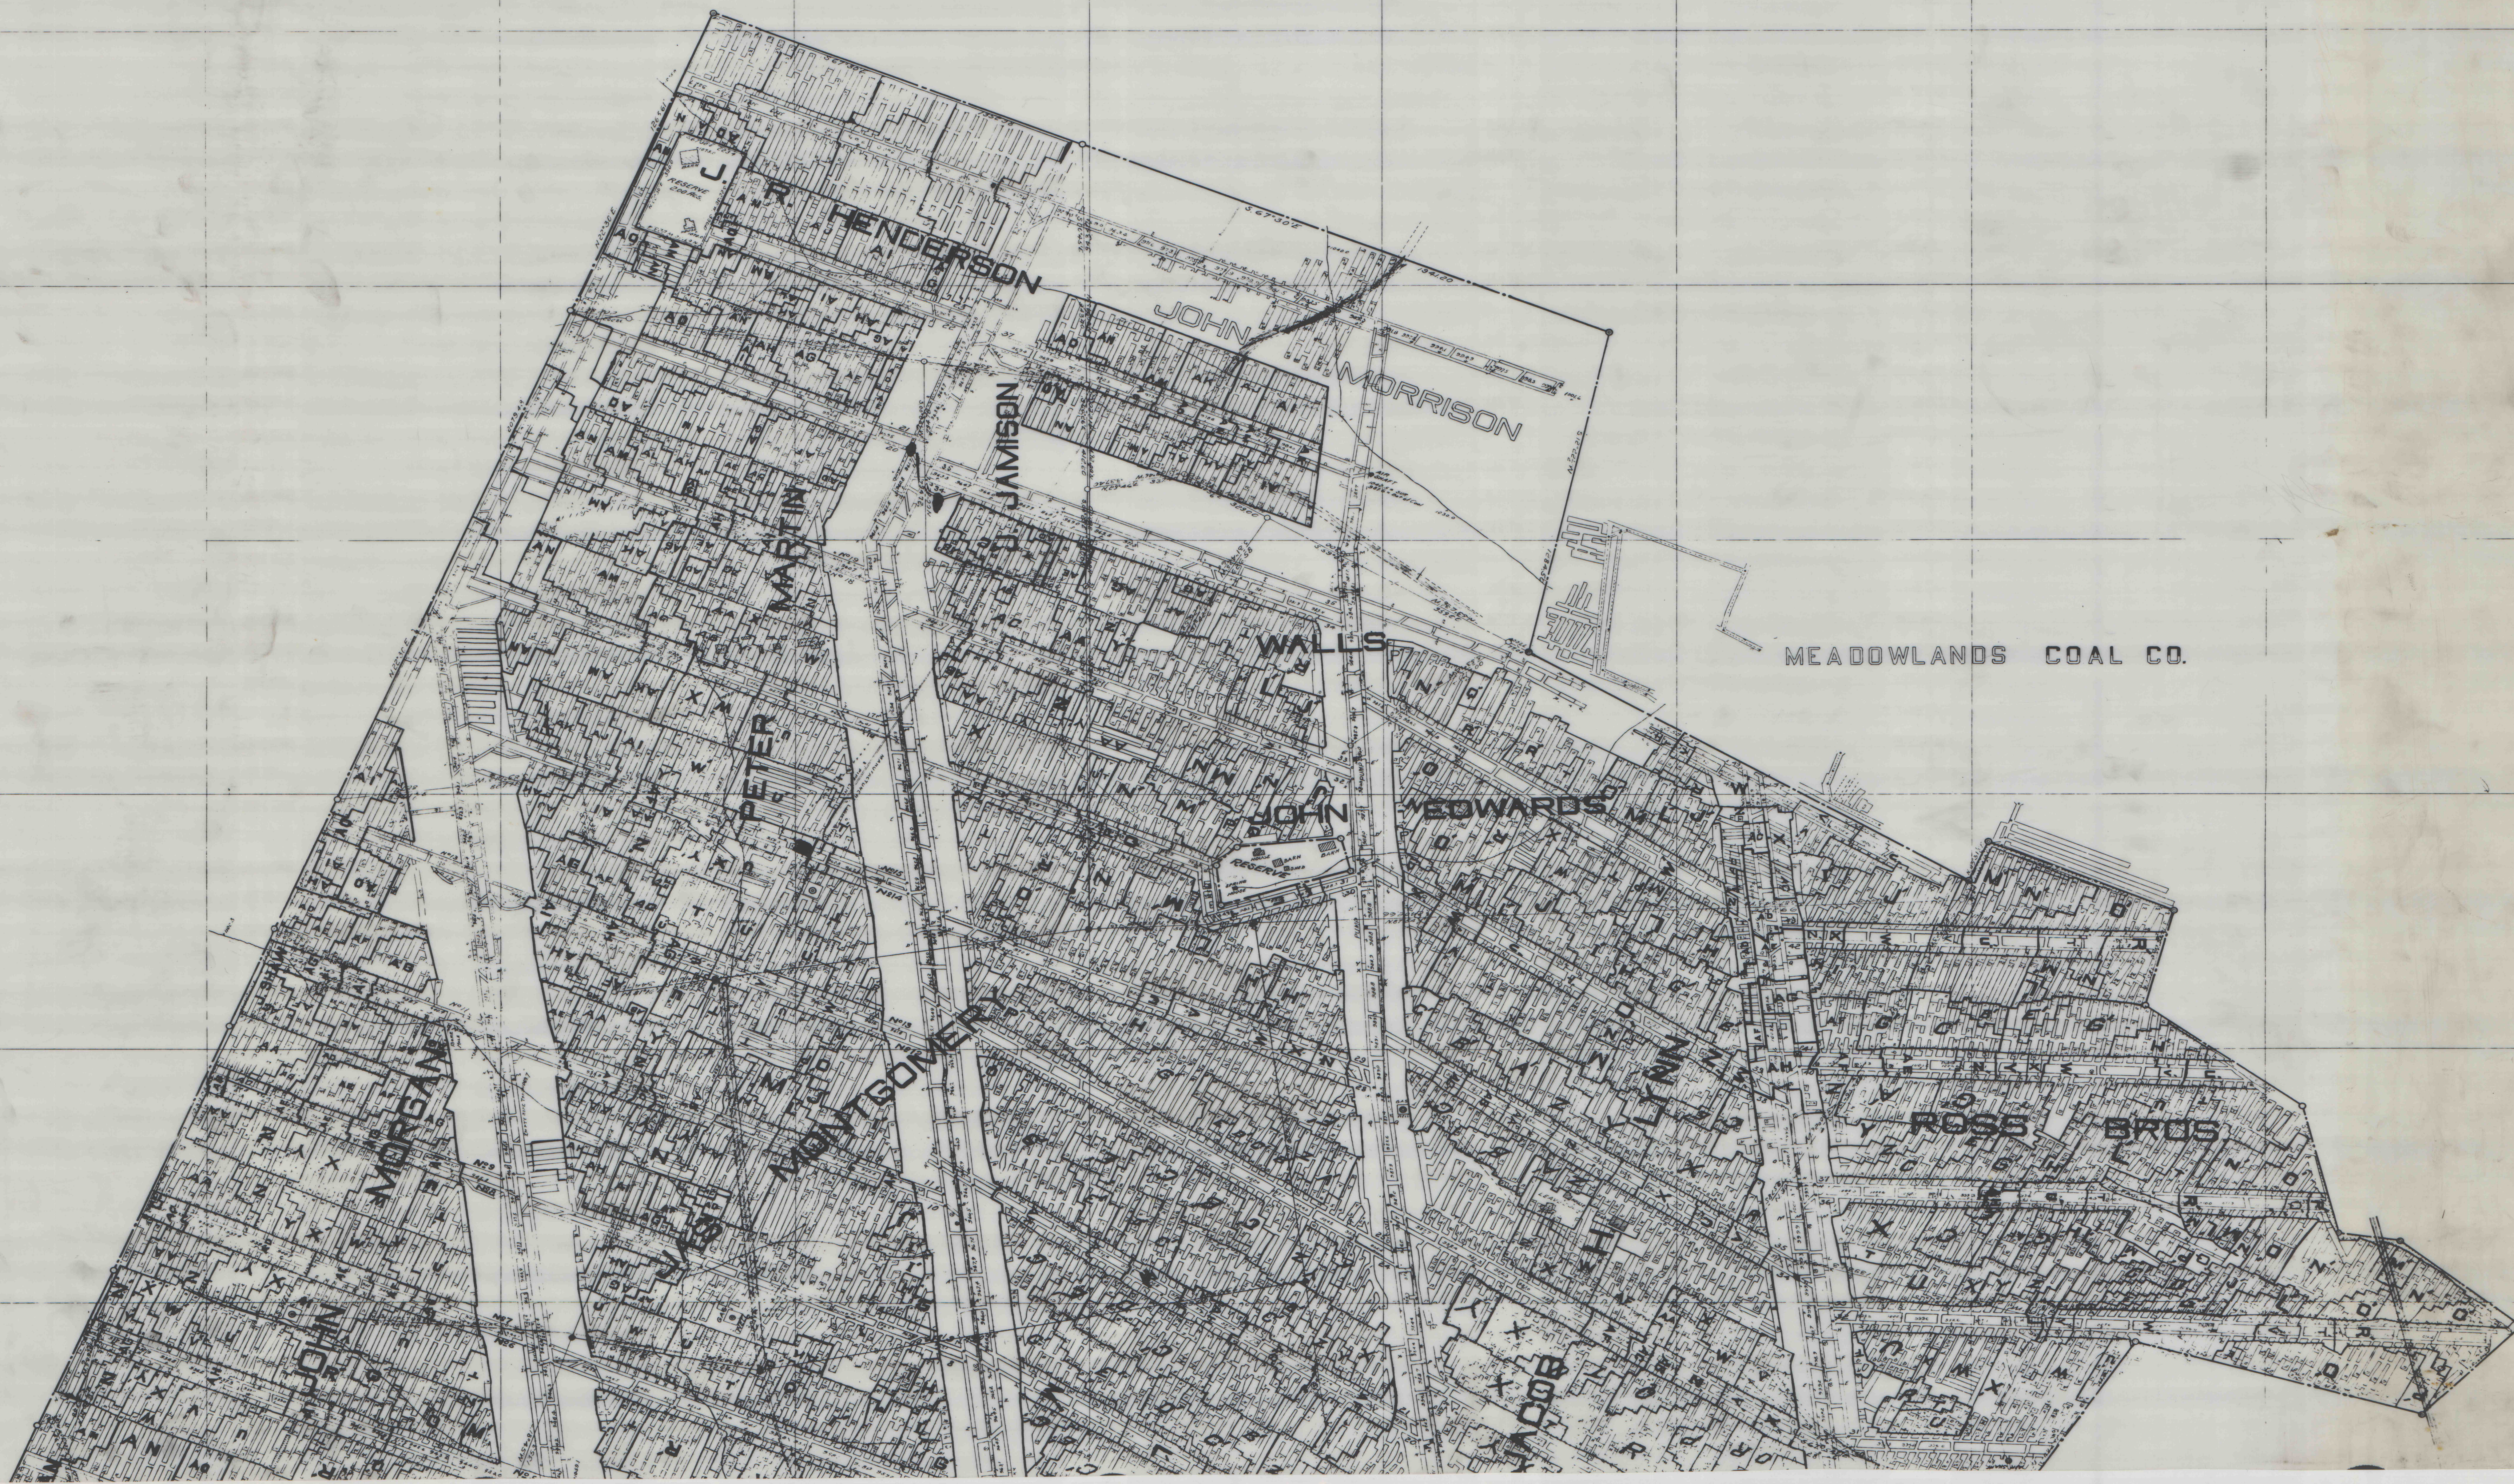

map of
1894-1911