


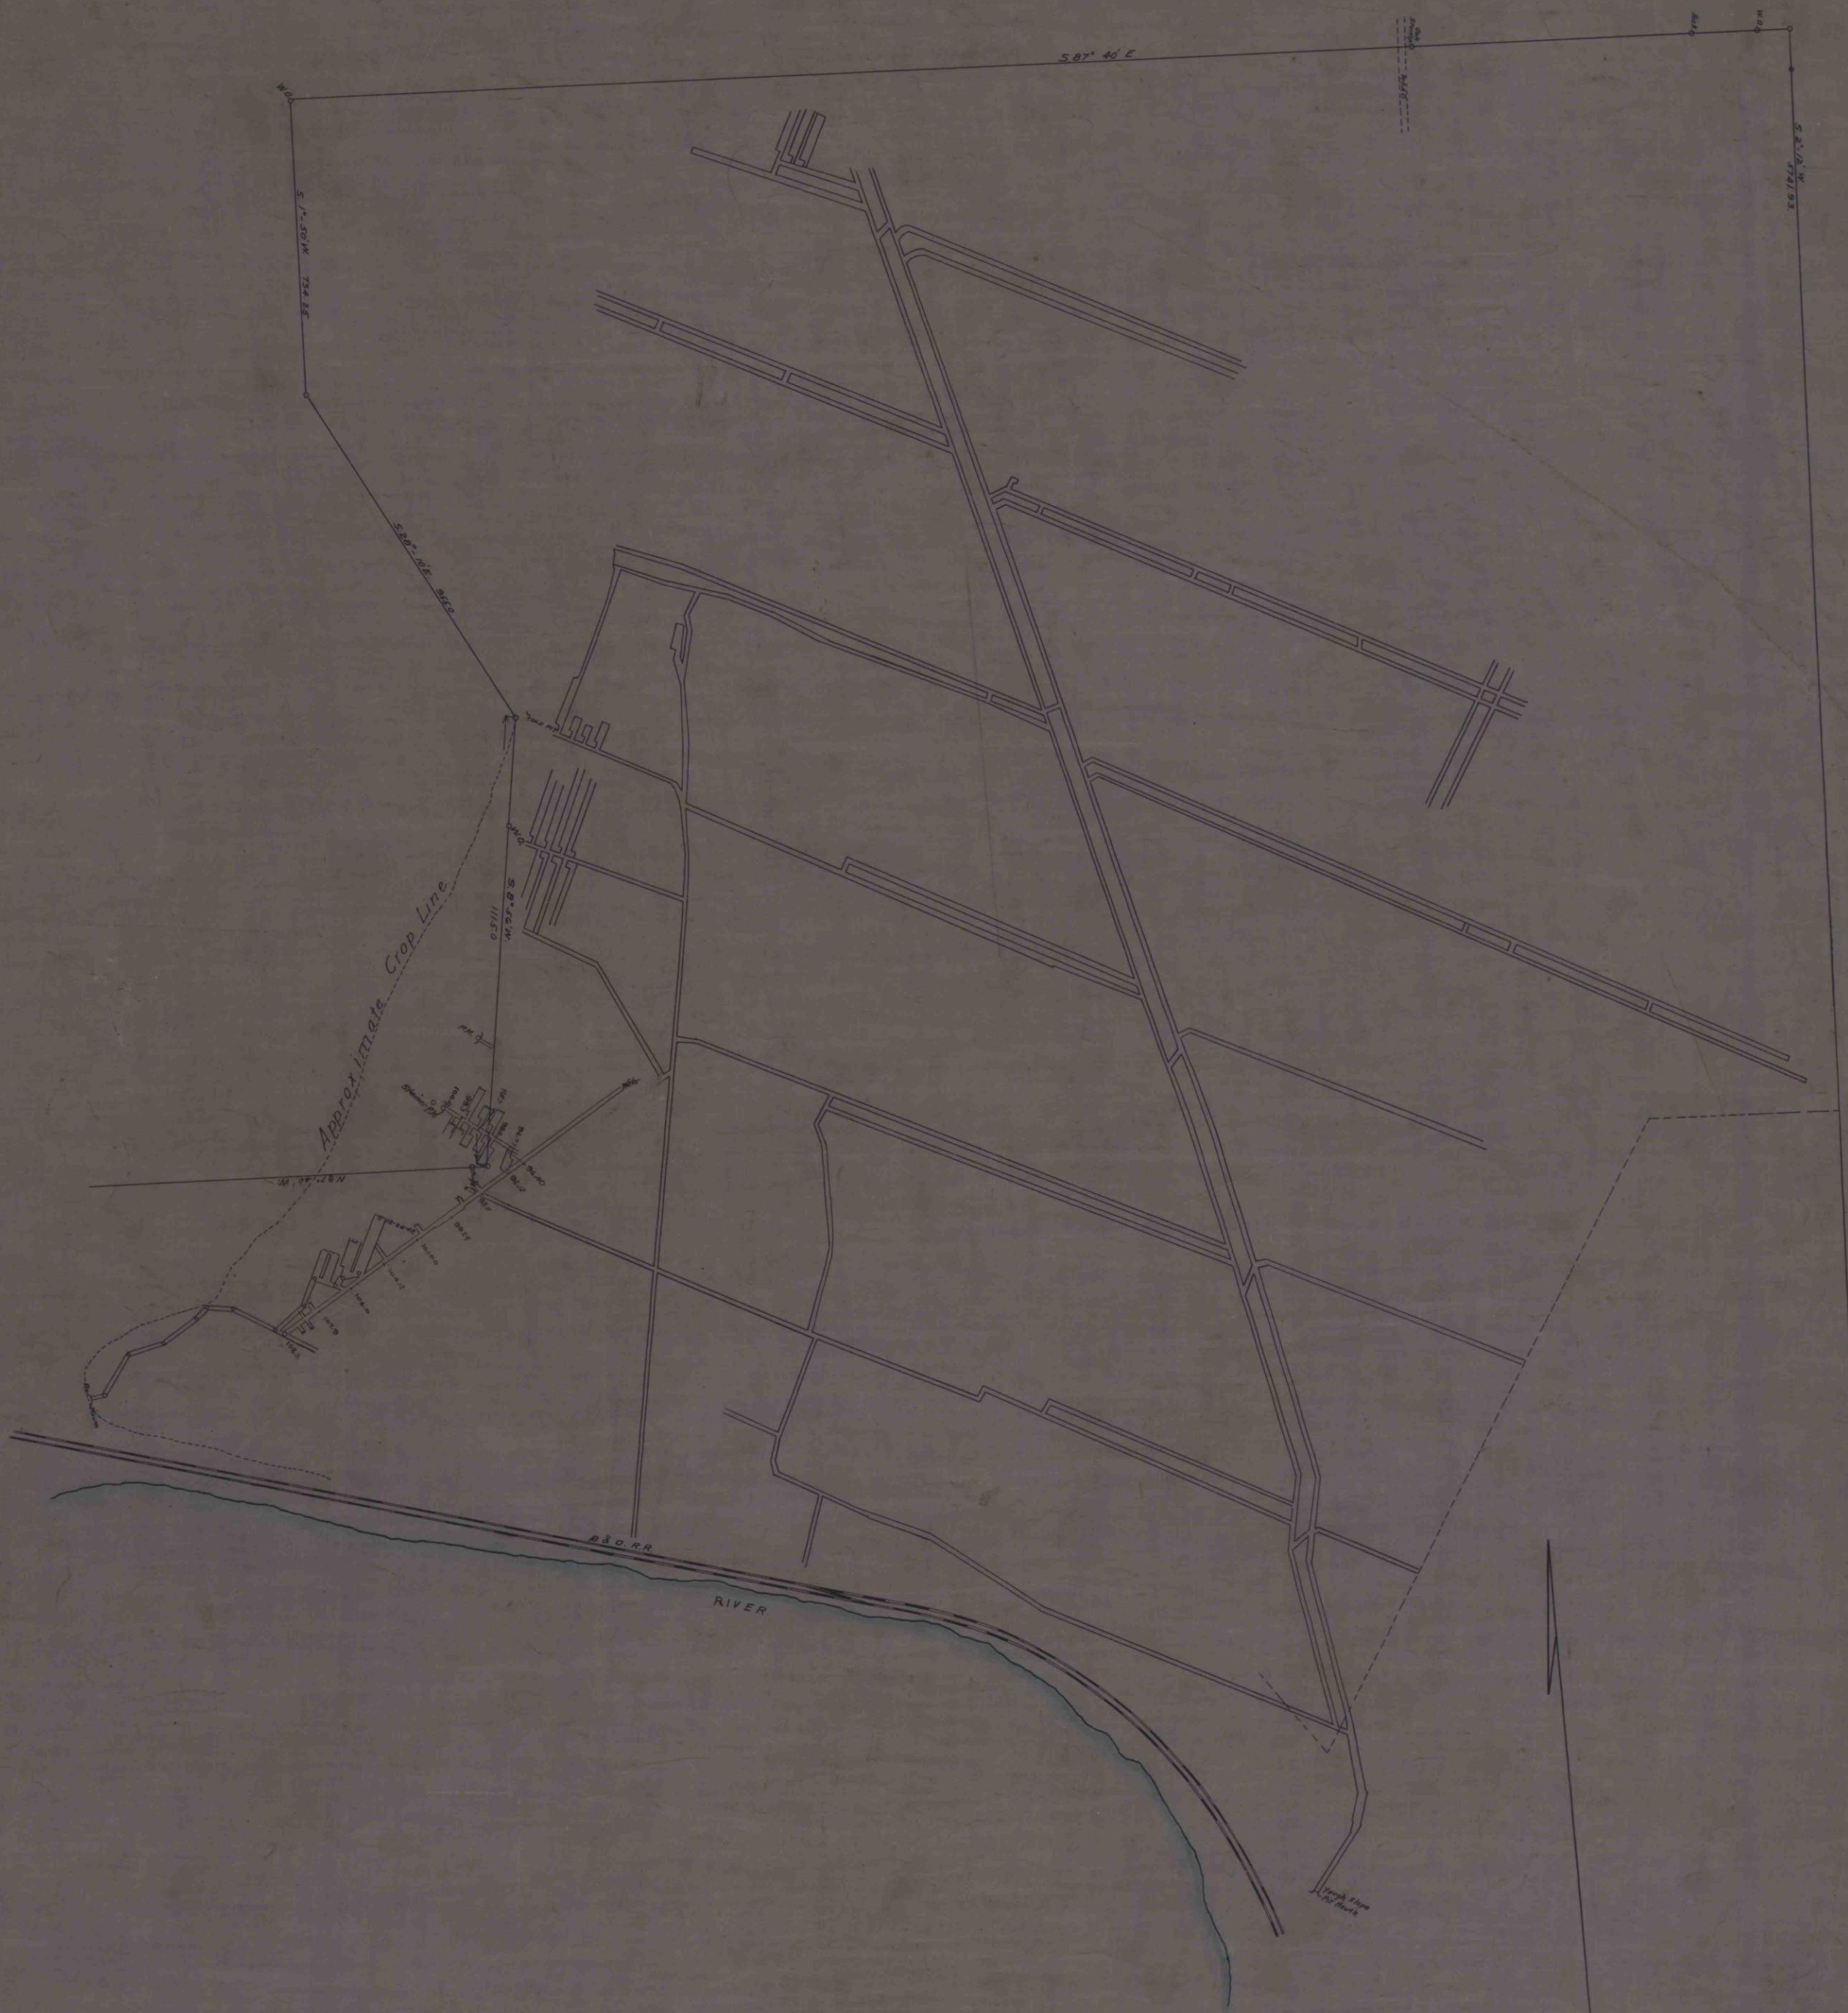

PLAN
of
PENNA MINING CO'S
YOUGH SLOPE PROPERTY

Situated in South Huntington Twp Westmoreland Co Pa.

Showing trespass by E. A. Humphries.

Scale 1"=200'

Feb. 10, 1903.

Eng. Dept.
Pitts. Coal Co.