


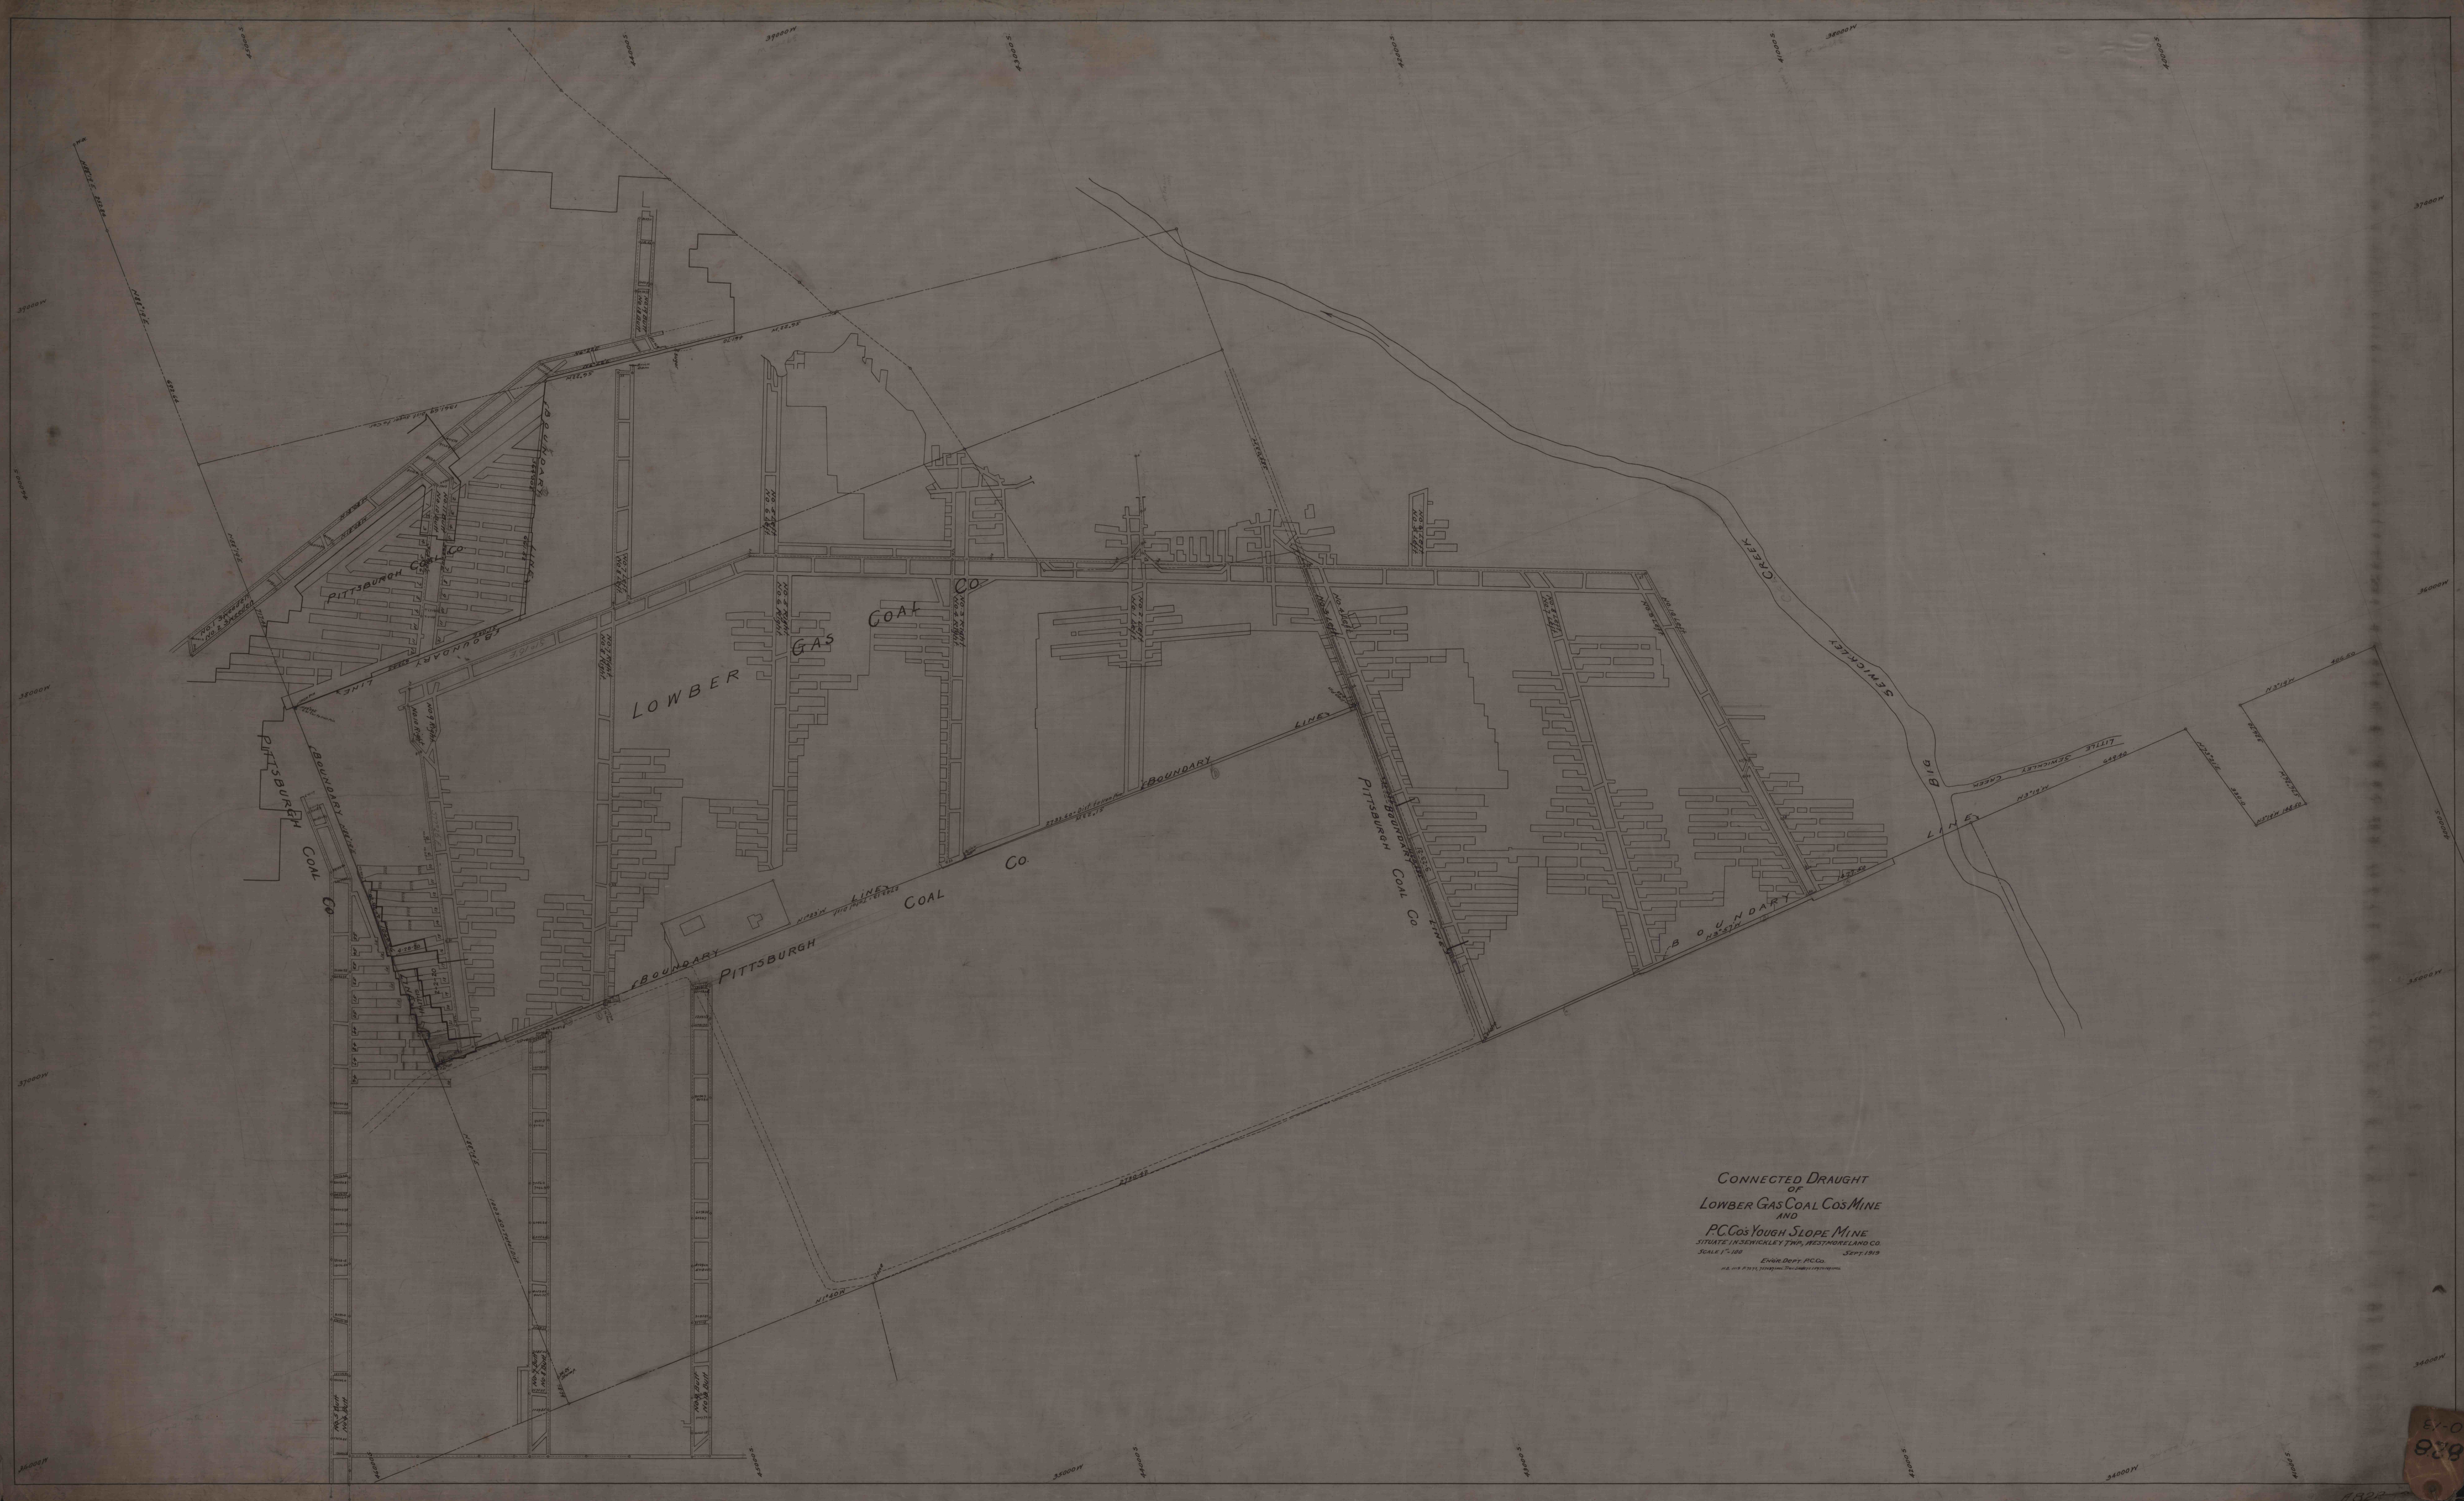

CONNECTED DRAUGHT
OF
LOWER GAS COAL CO'S MINE
AND
PCCO'S YOUGH SLOPE MINE
SITUATE IN SEWICKLEY TWP., WESTMORELAND CO.
SCALE 1"=100' Sept. 1919
P.L.S. FOR P. 217, 220, 221, 222,1000

EV-0
828