


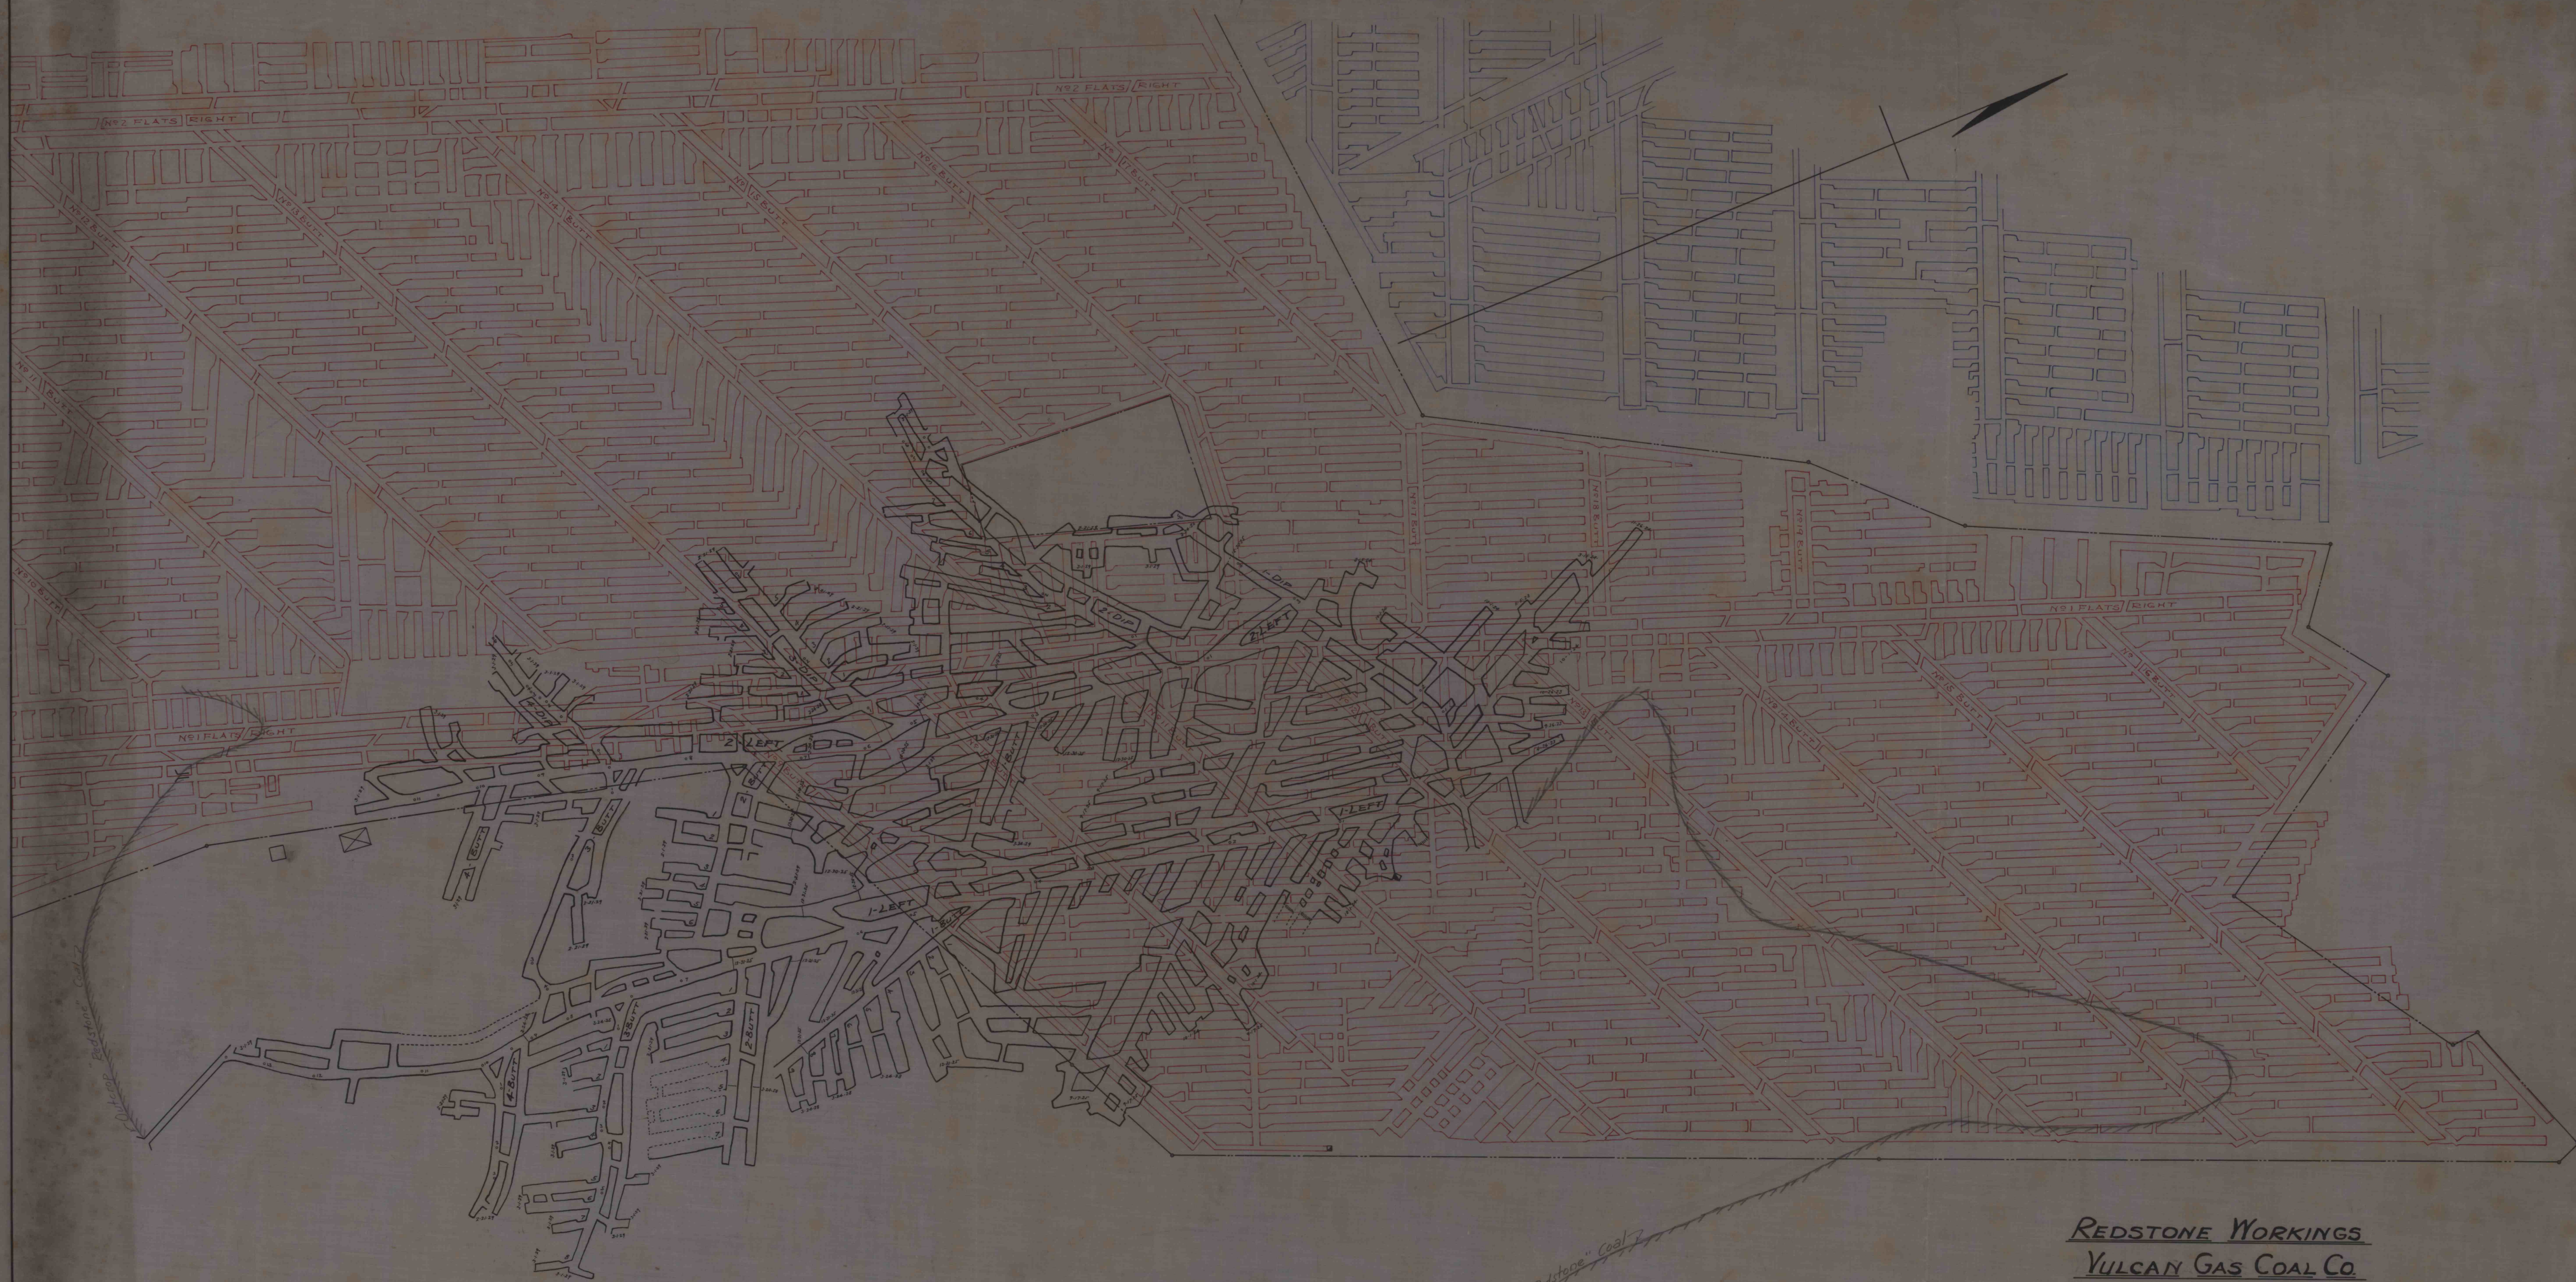

REDSTONE WORKINGS
VULCAN GAS COAL CO.
YUKON MINE Nº2
in relation to
PITTSBURG WORKINGS
WESTMORELAND COAL CO.
MAGEE MINE
Scale 1"=100' Oct. 2, 1929