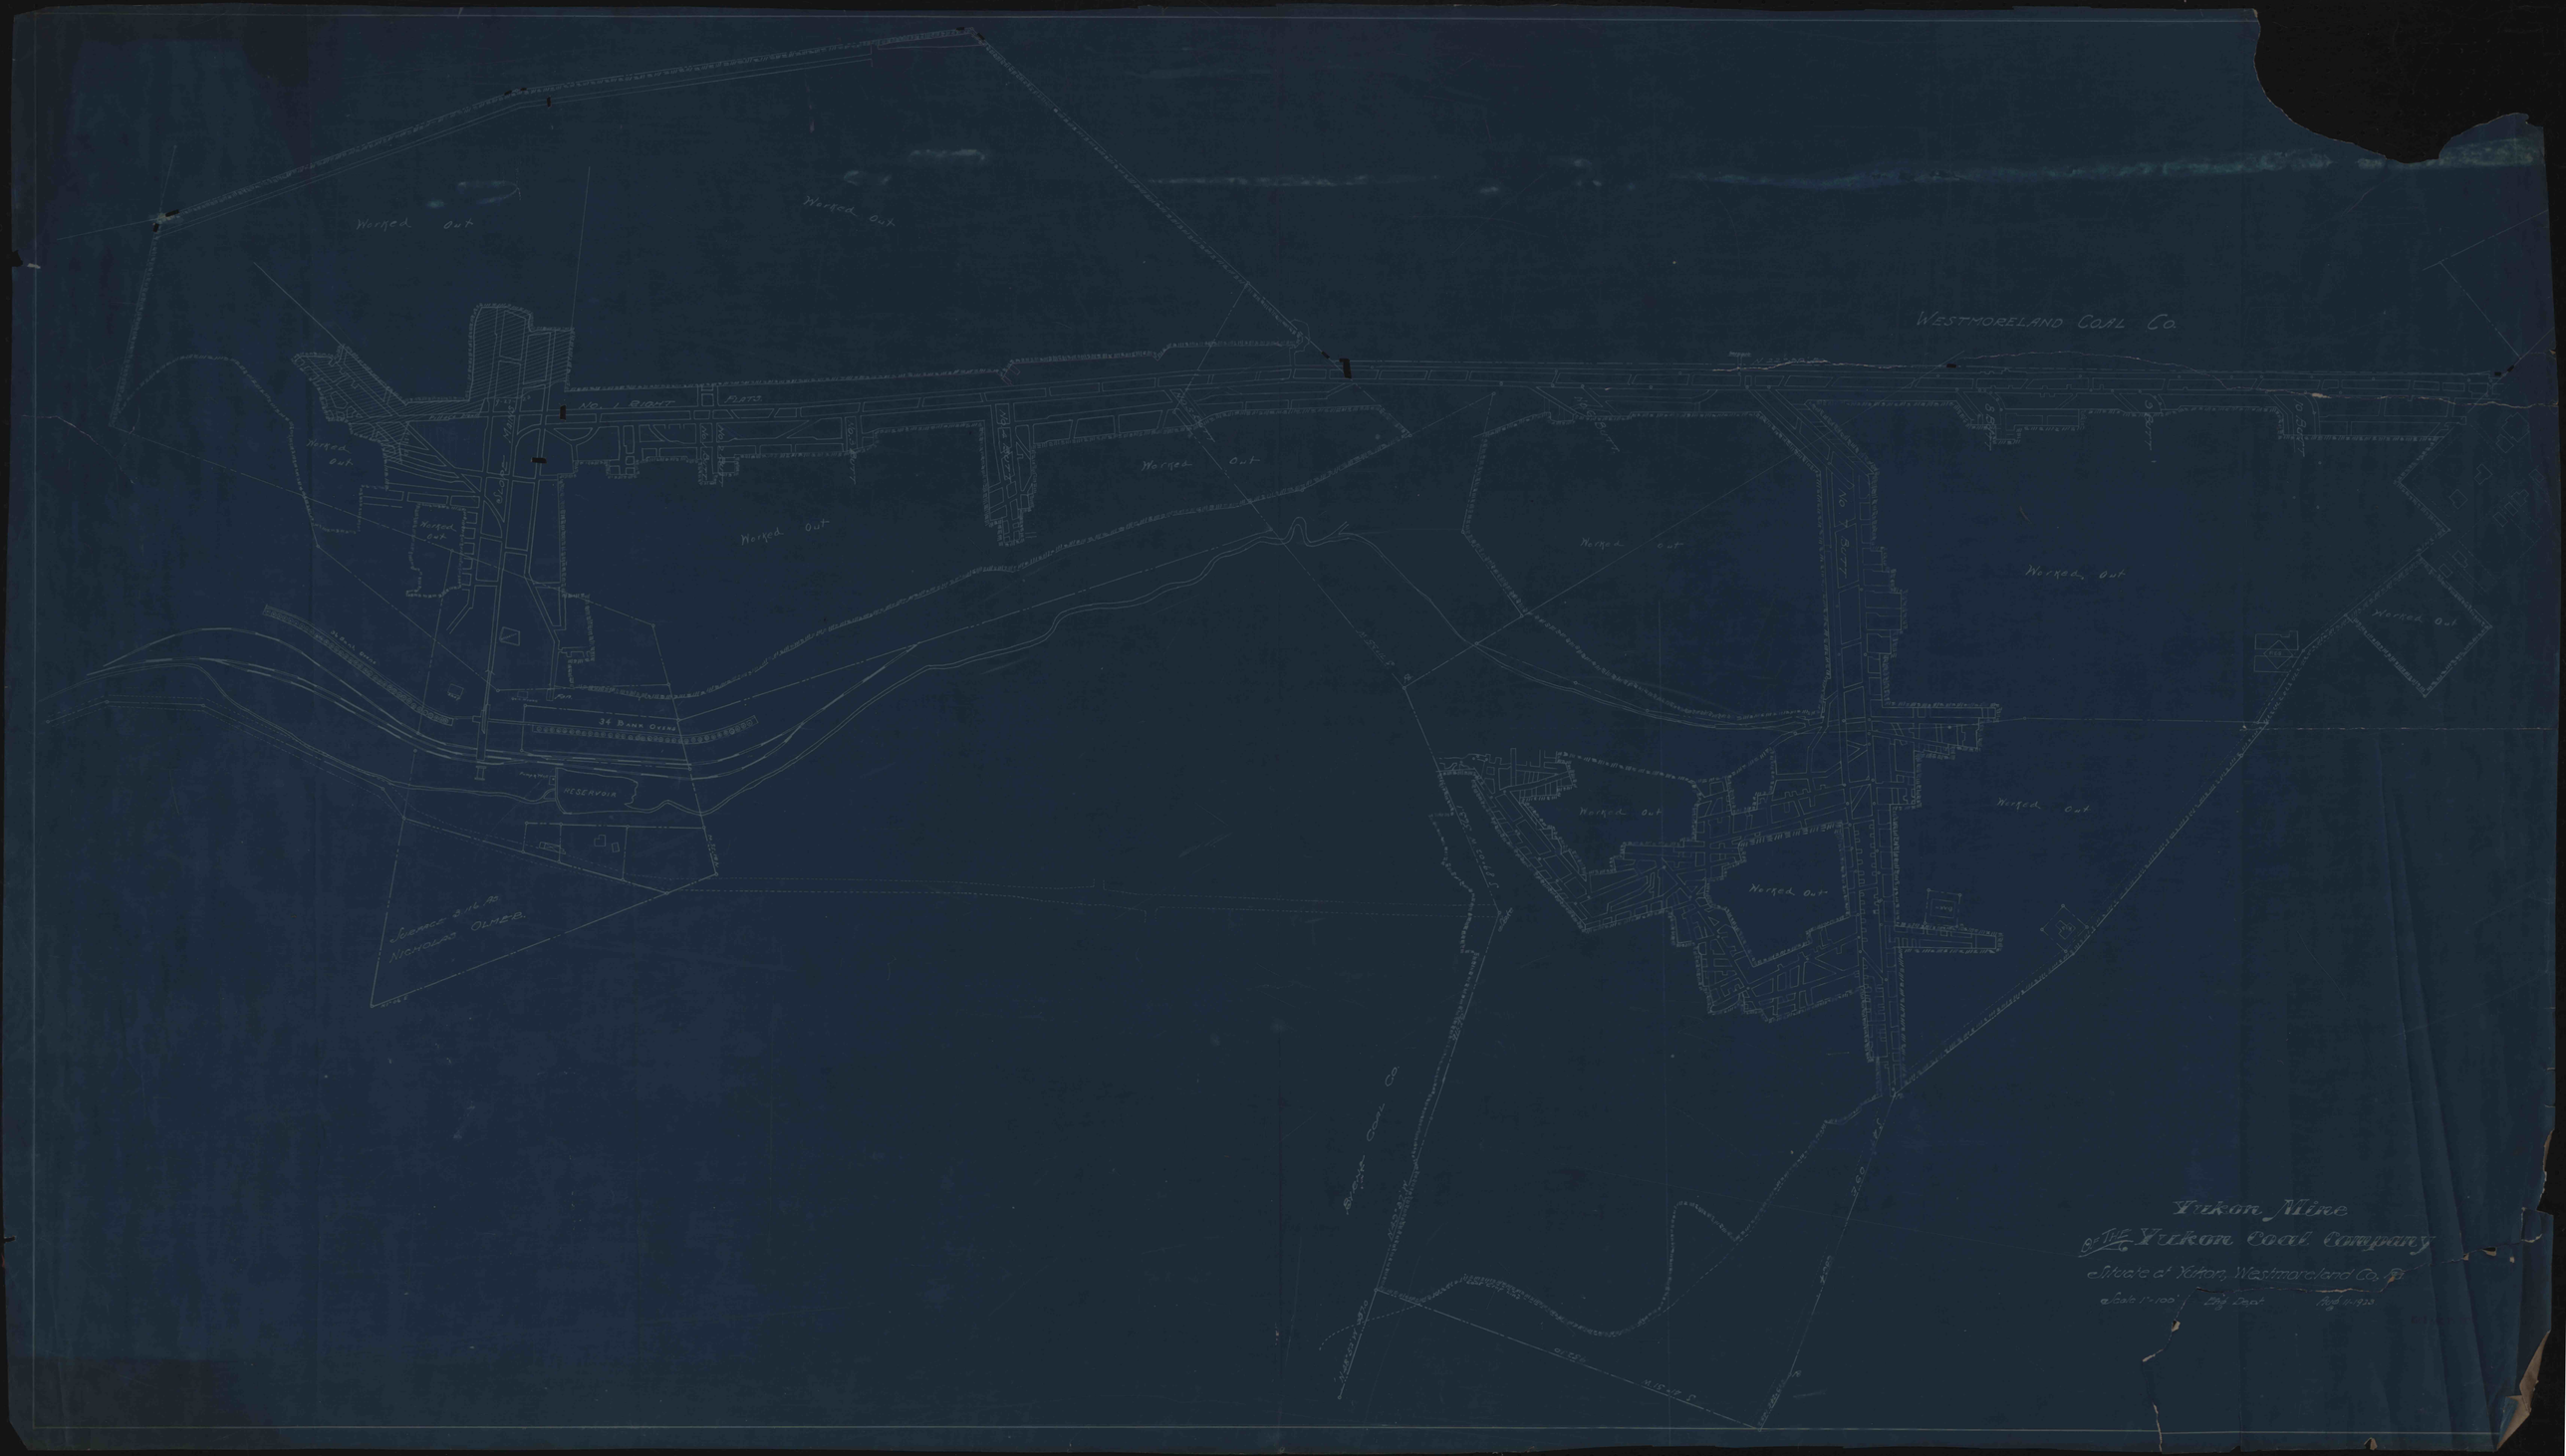
Worked out
Worked out
Worked out