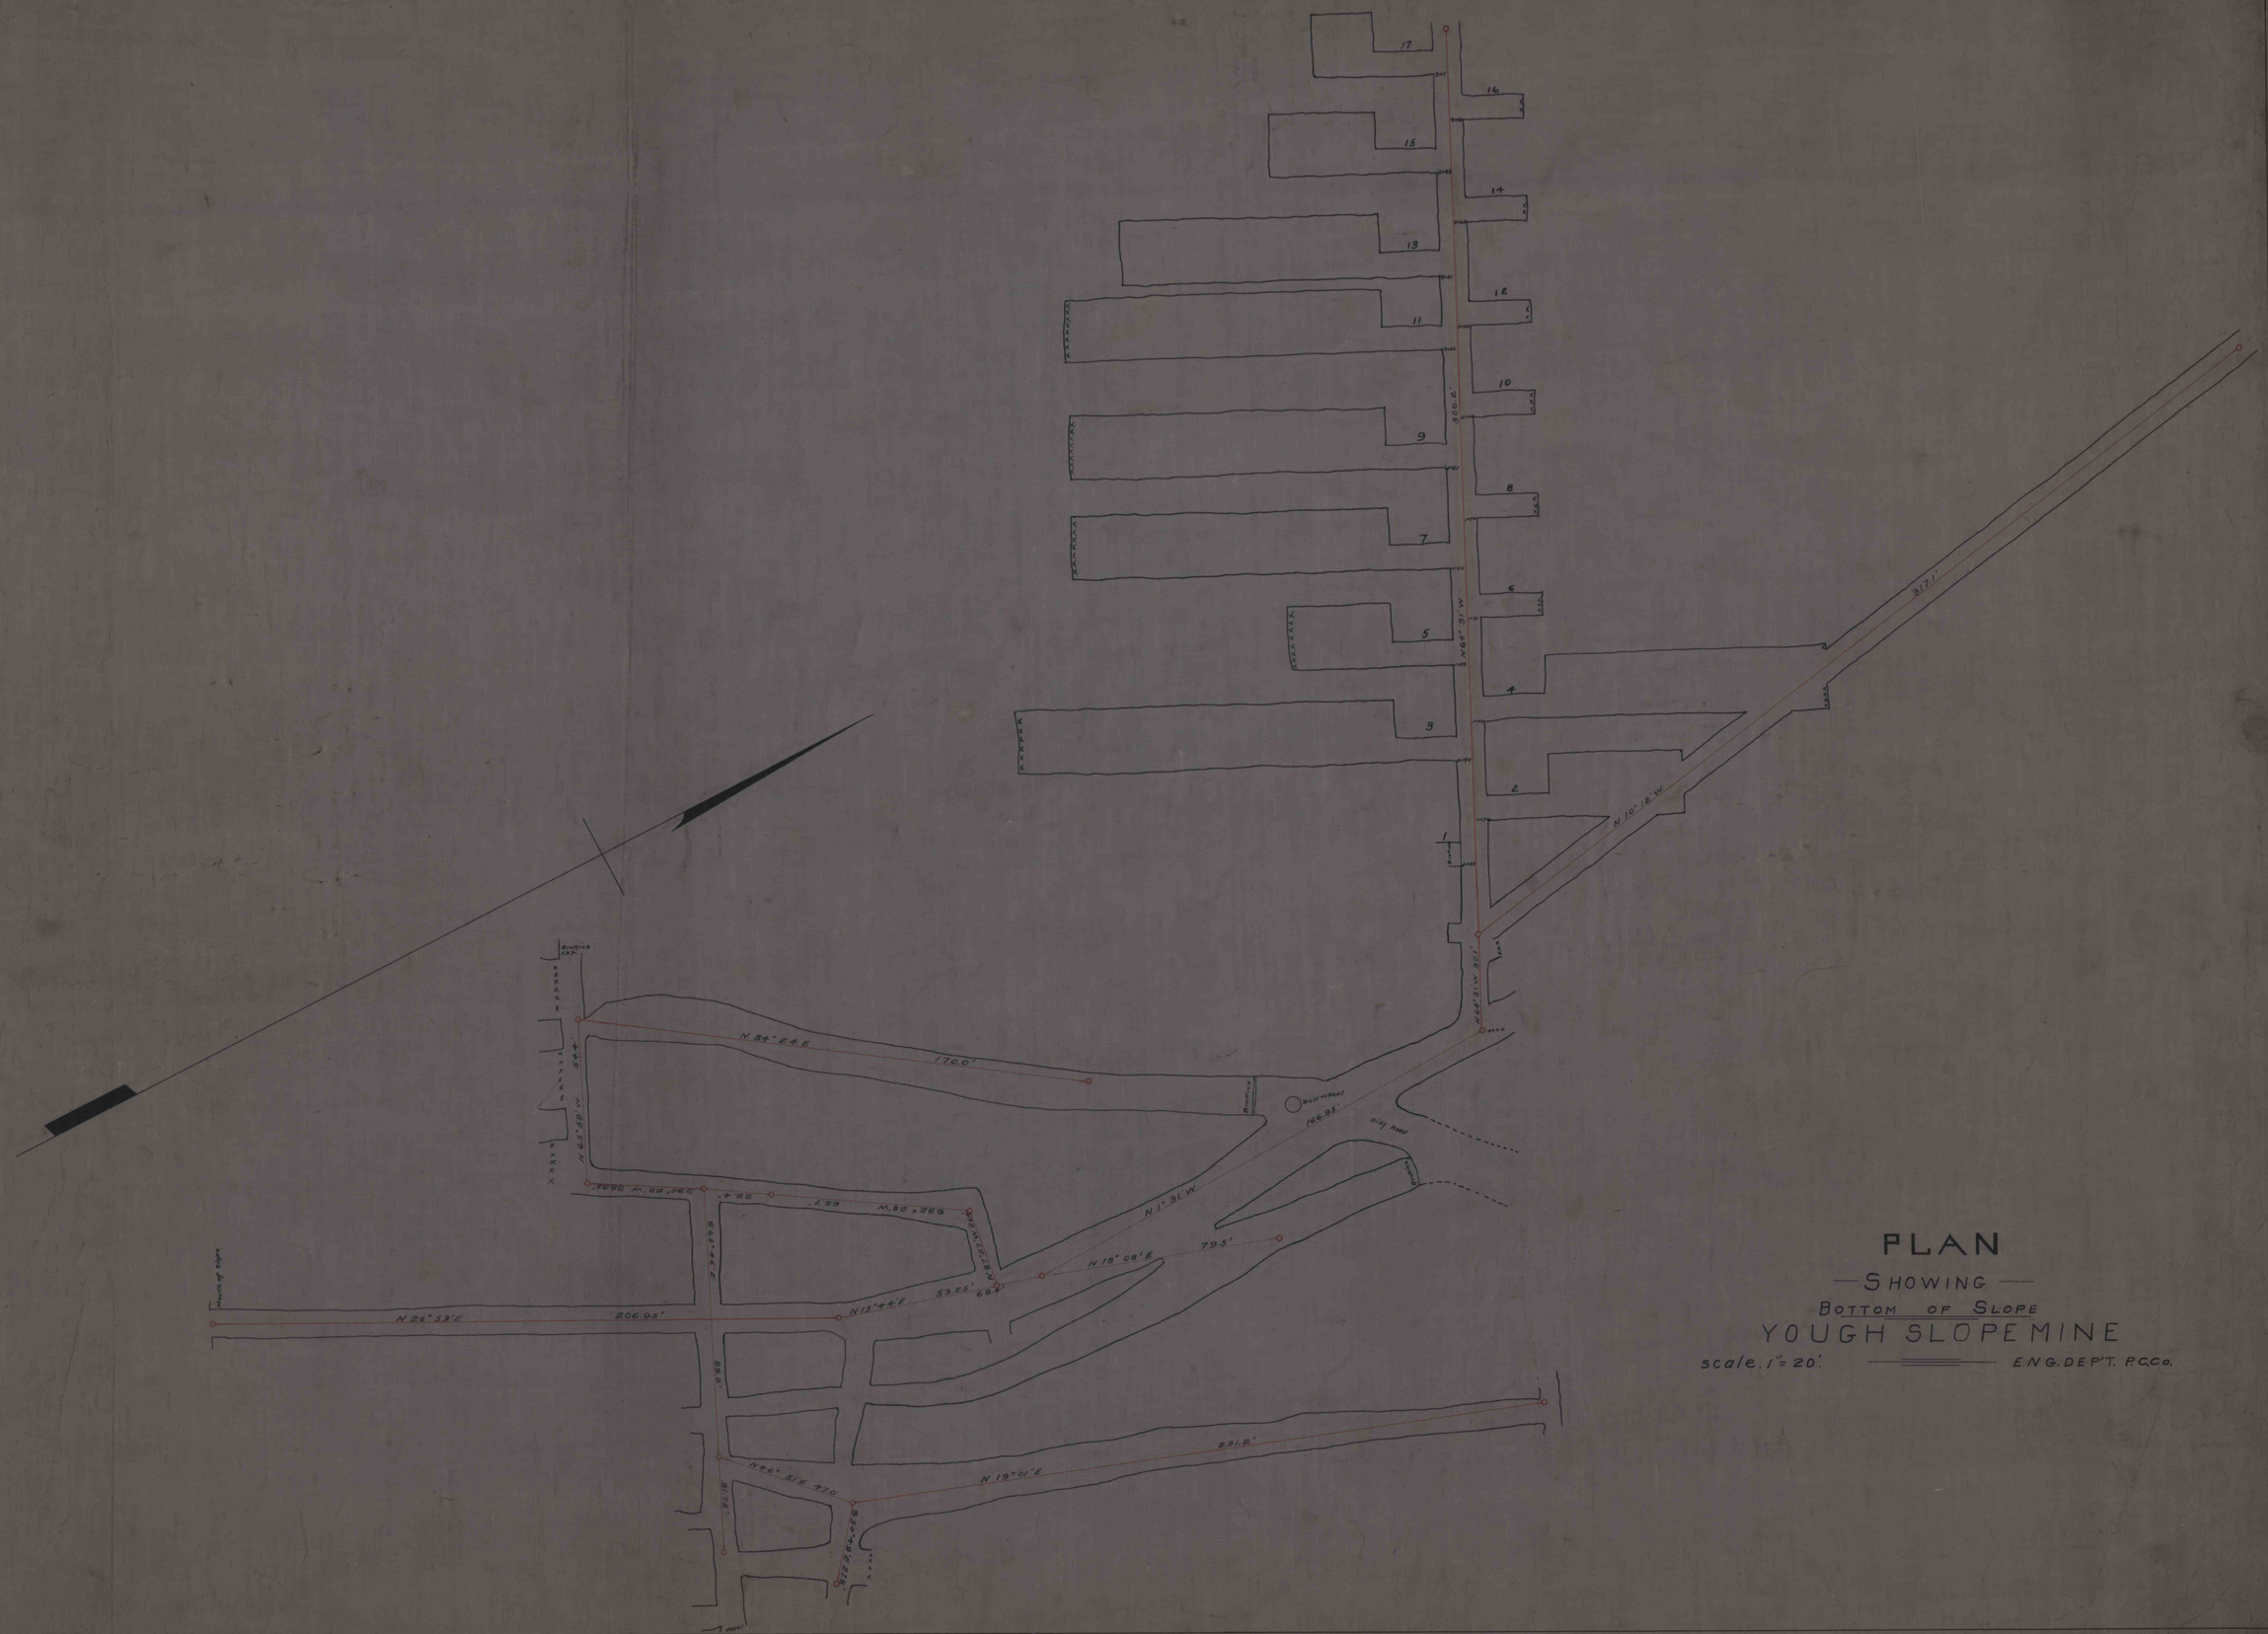

PLAN

SHOWING

BOTTOM OF SLOPE

YOUGH SLOPE MINE

scale. 1" = 20'.

ENG. DEP'T. P.C.Co.