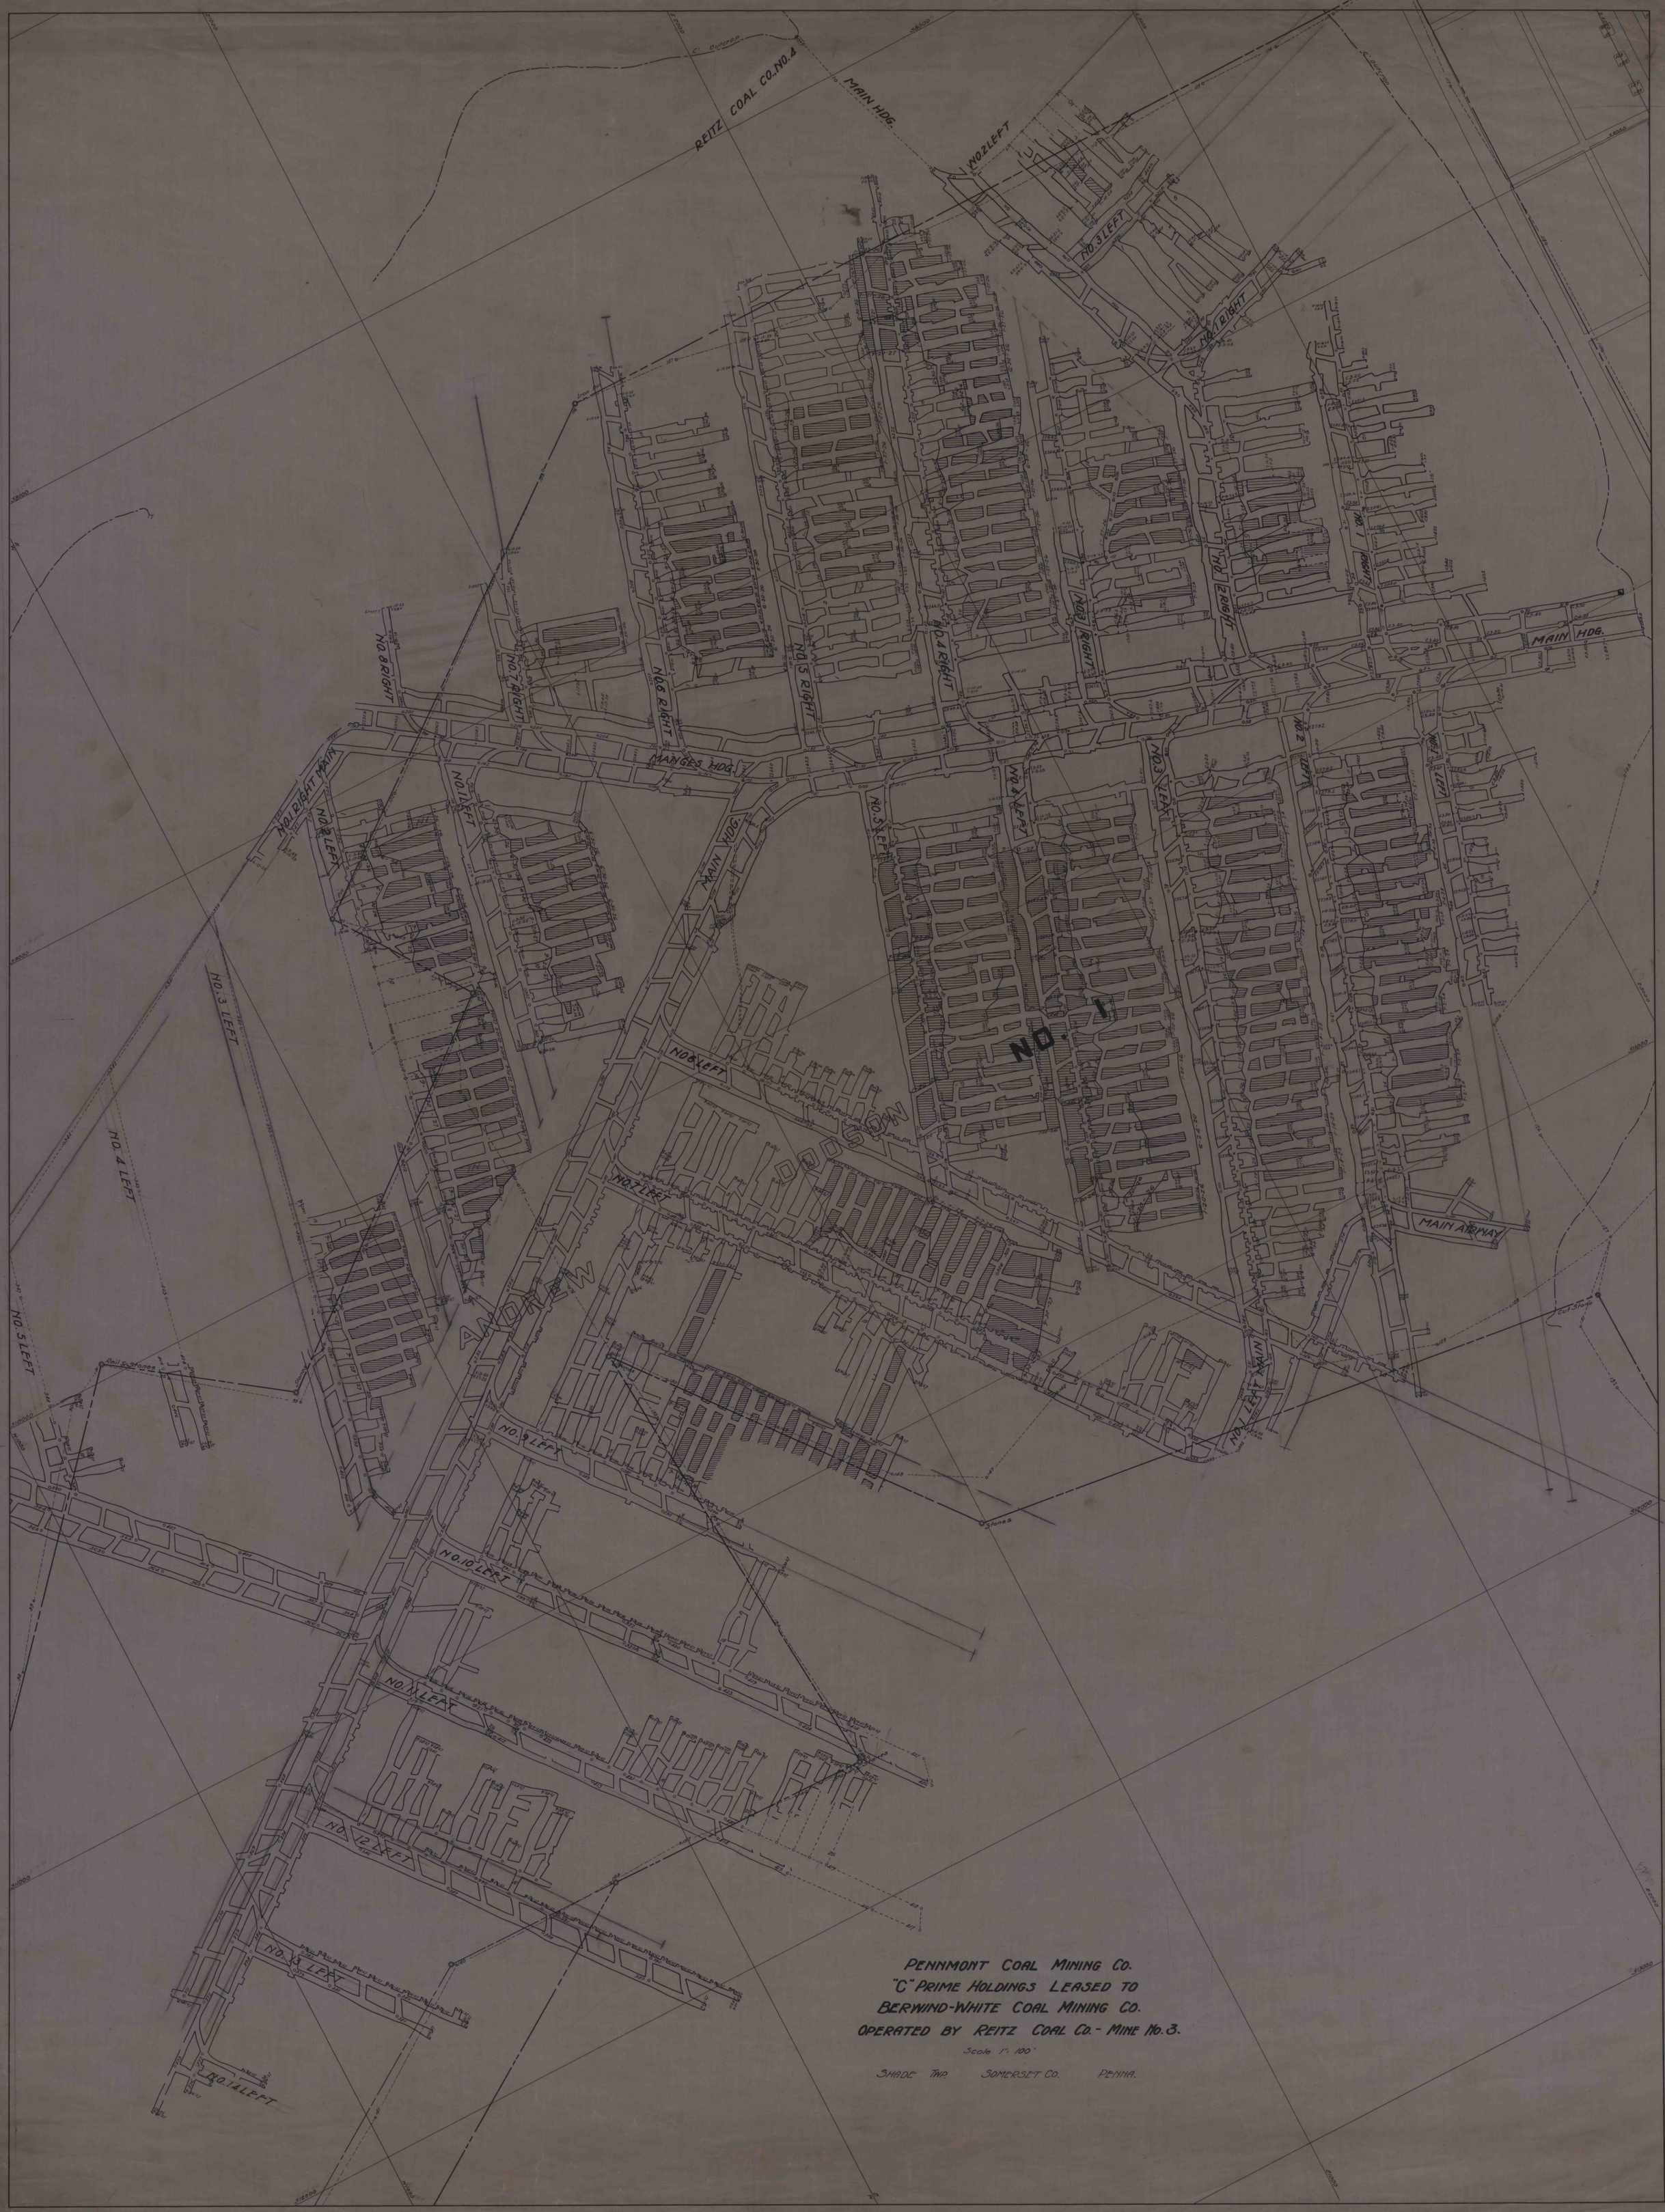

PENNMONT COAL MINING CO.
"C" PRIME HOLDINGS LEASED TO
BERWIND-WHITE COAL MINING CO.
OPERATED BY REITZ COAL CO. - MINE No. 3.

Scale 1" = 100'

SHADE TWP. SOMERSET CO. PENNA.

C-A-1