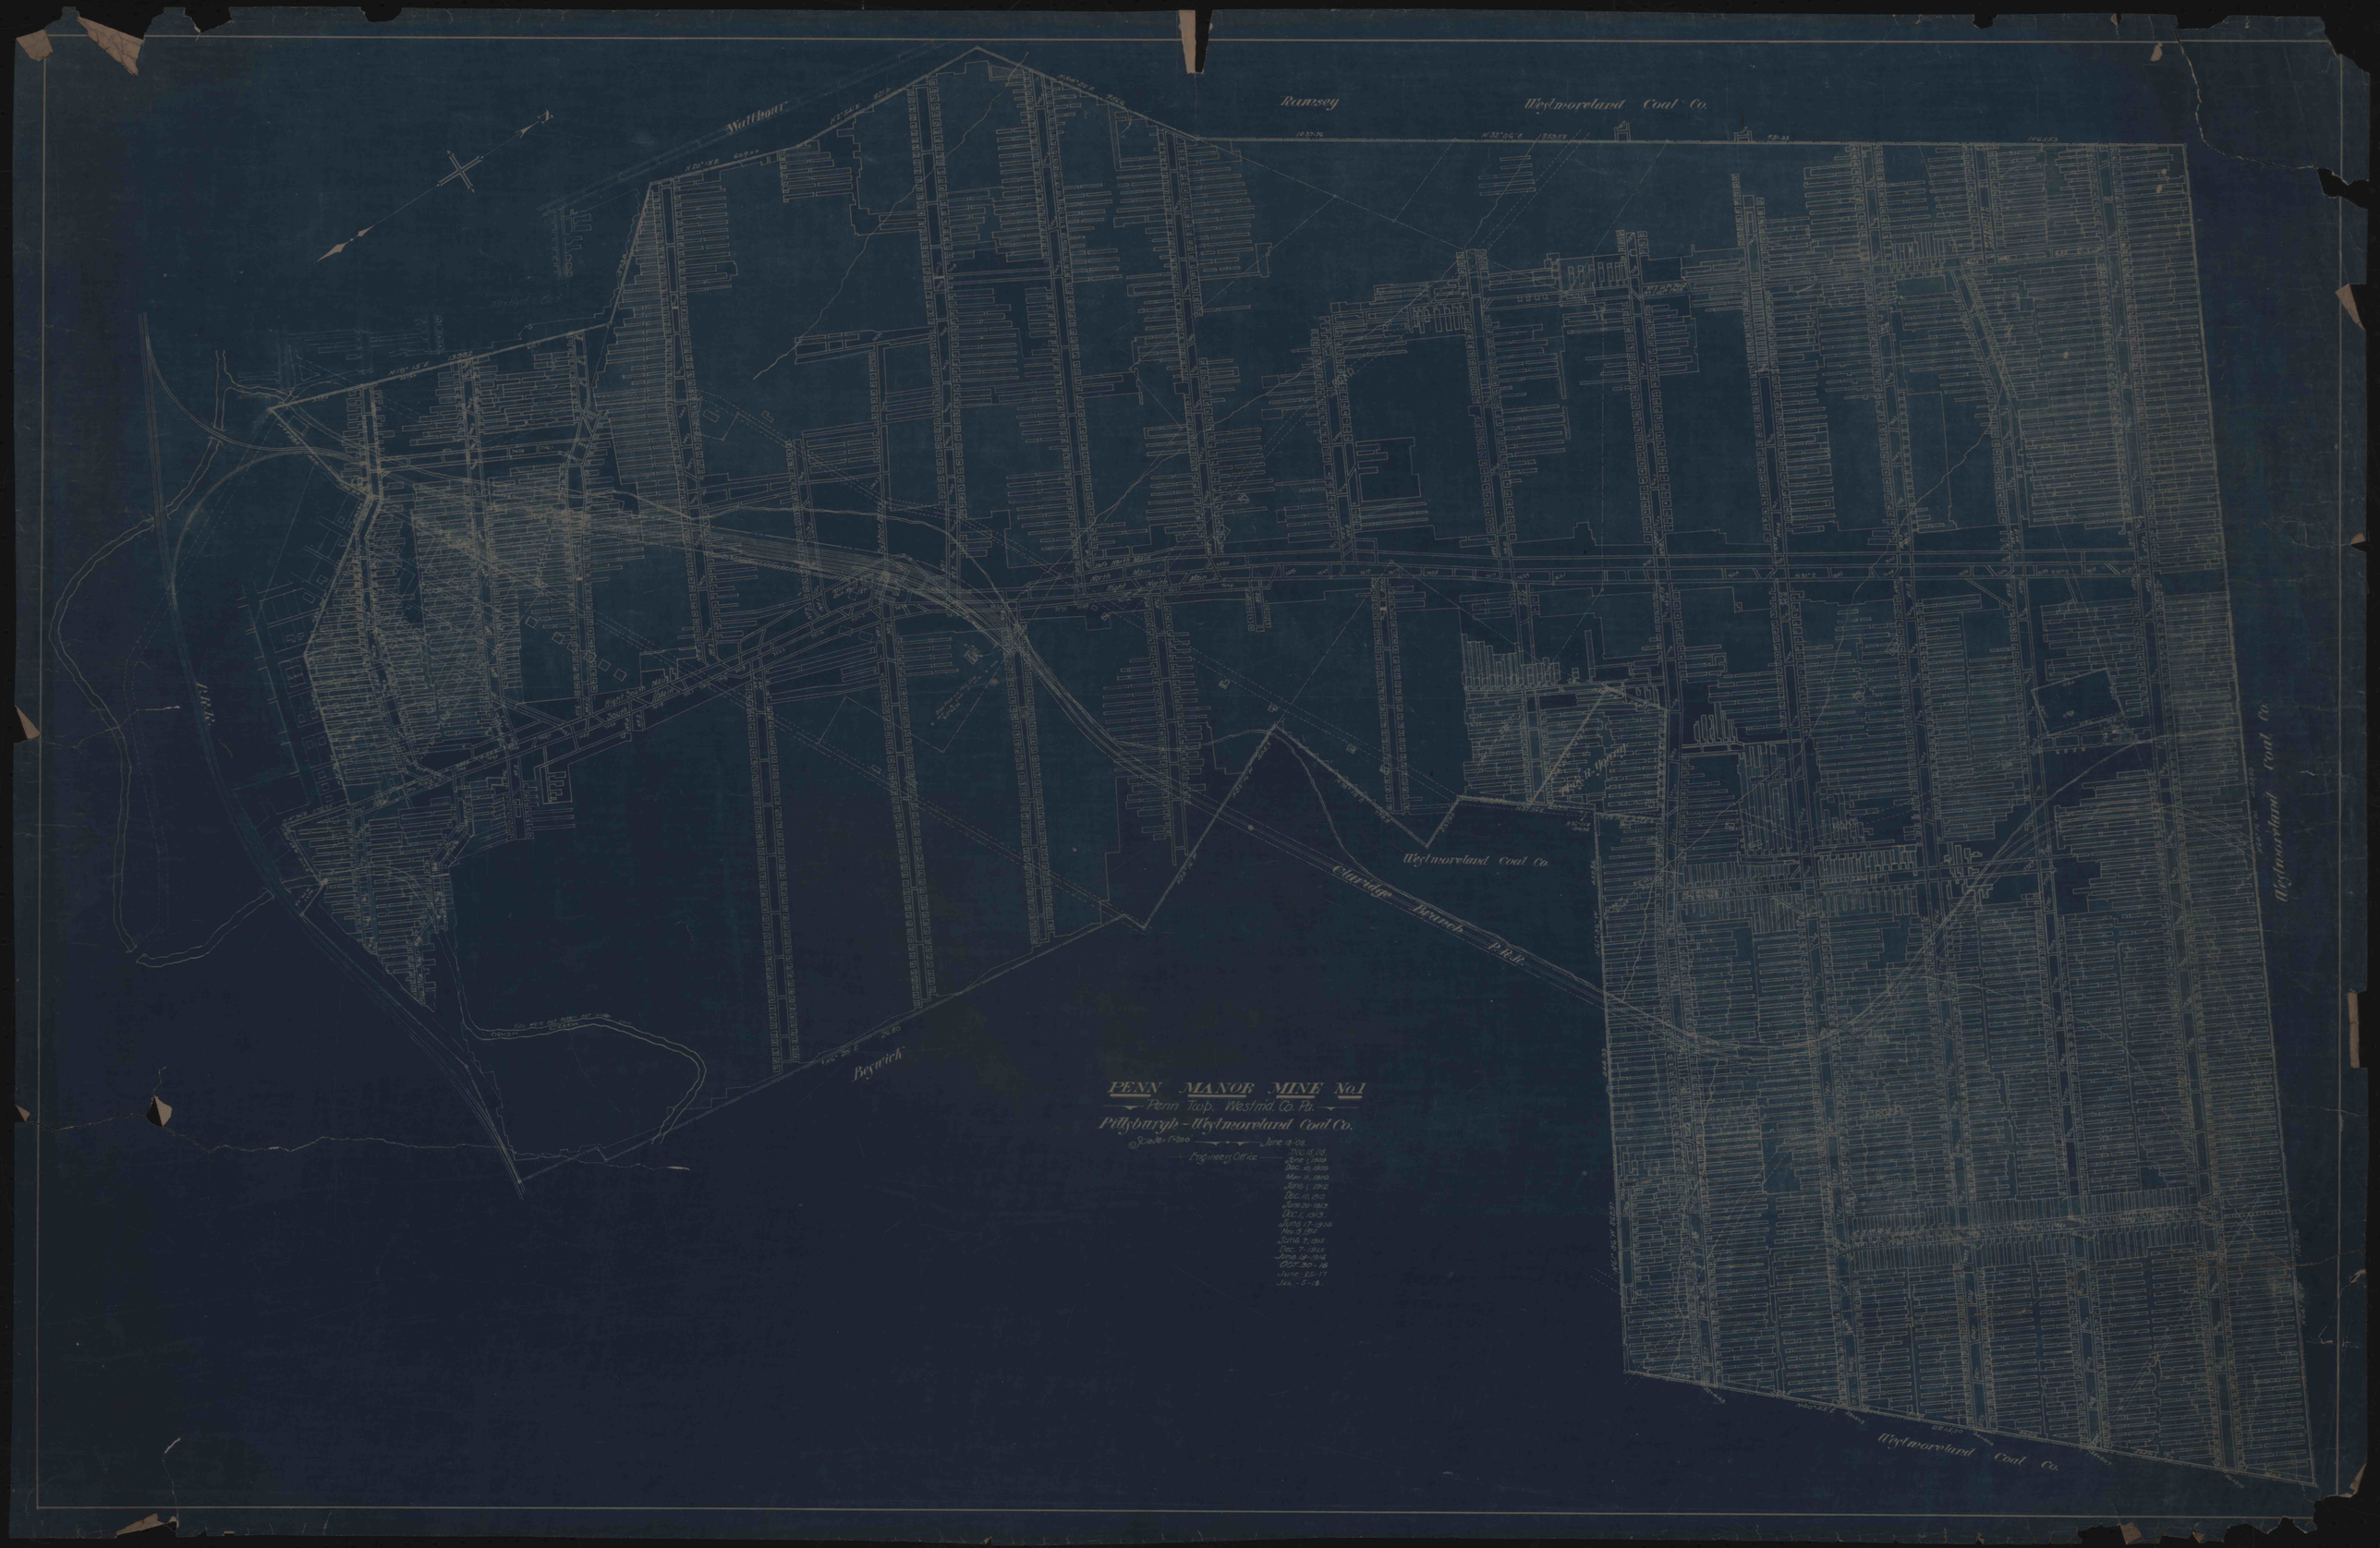
Ramsey
Westmoreland Coal Co.
Mathour
Westmoreland Coal Co.
Clarridge Branch P.R.R.
Beswick
Westmoreland Coal Co.
Westmoreland Coal Co.
PENN MANOR MINE No 1
Penn Twp. Westmd. Co. Pa.
Pittsburgh - Westmoreland Coal Co.
Scale 1"=200
June 18-08.
Engineers Office
Dec. 15-08
June 7, 1909
Dec. 10, 1909
Mar. 11, 1910
June 1, 1912
Dec. 10, 1912
June 20-1913
Oct. 1-1913
June 17-1914
Nov. 3 1914
June 7, 1915
Dec. 7-1915
June 19-1916
Oct. 30-18
June - 25-17
Jan. - 5-18.