


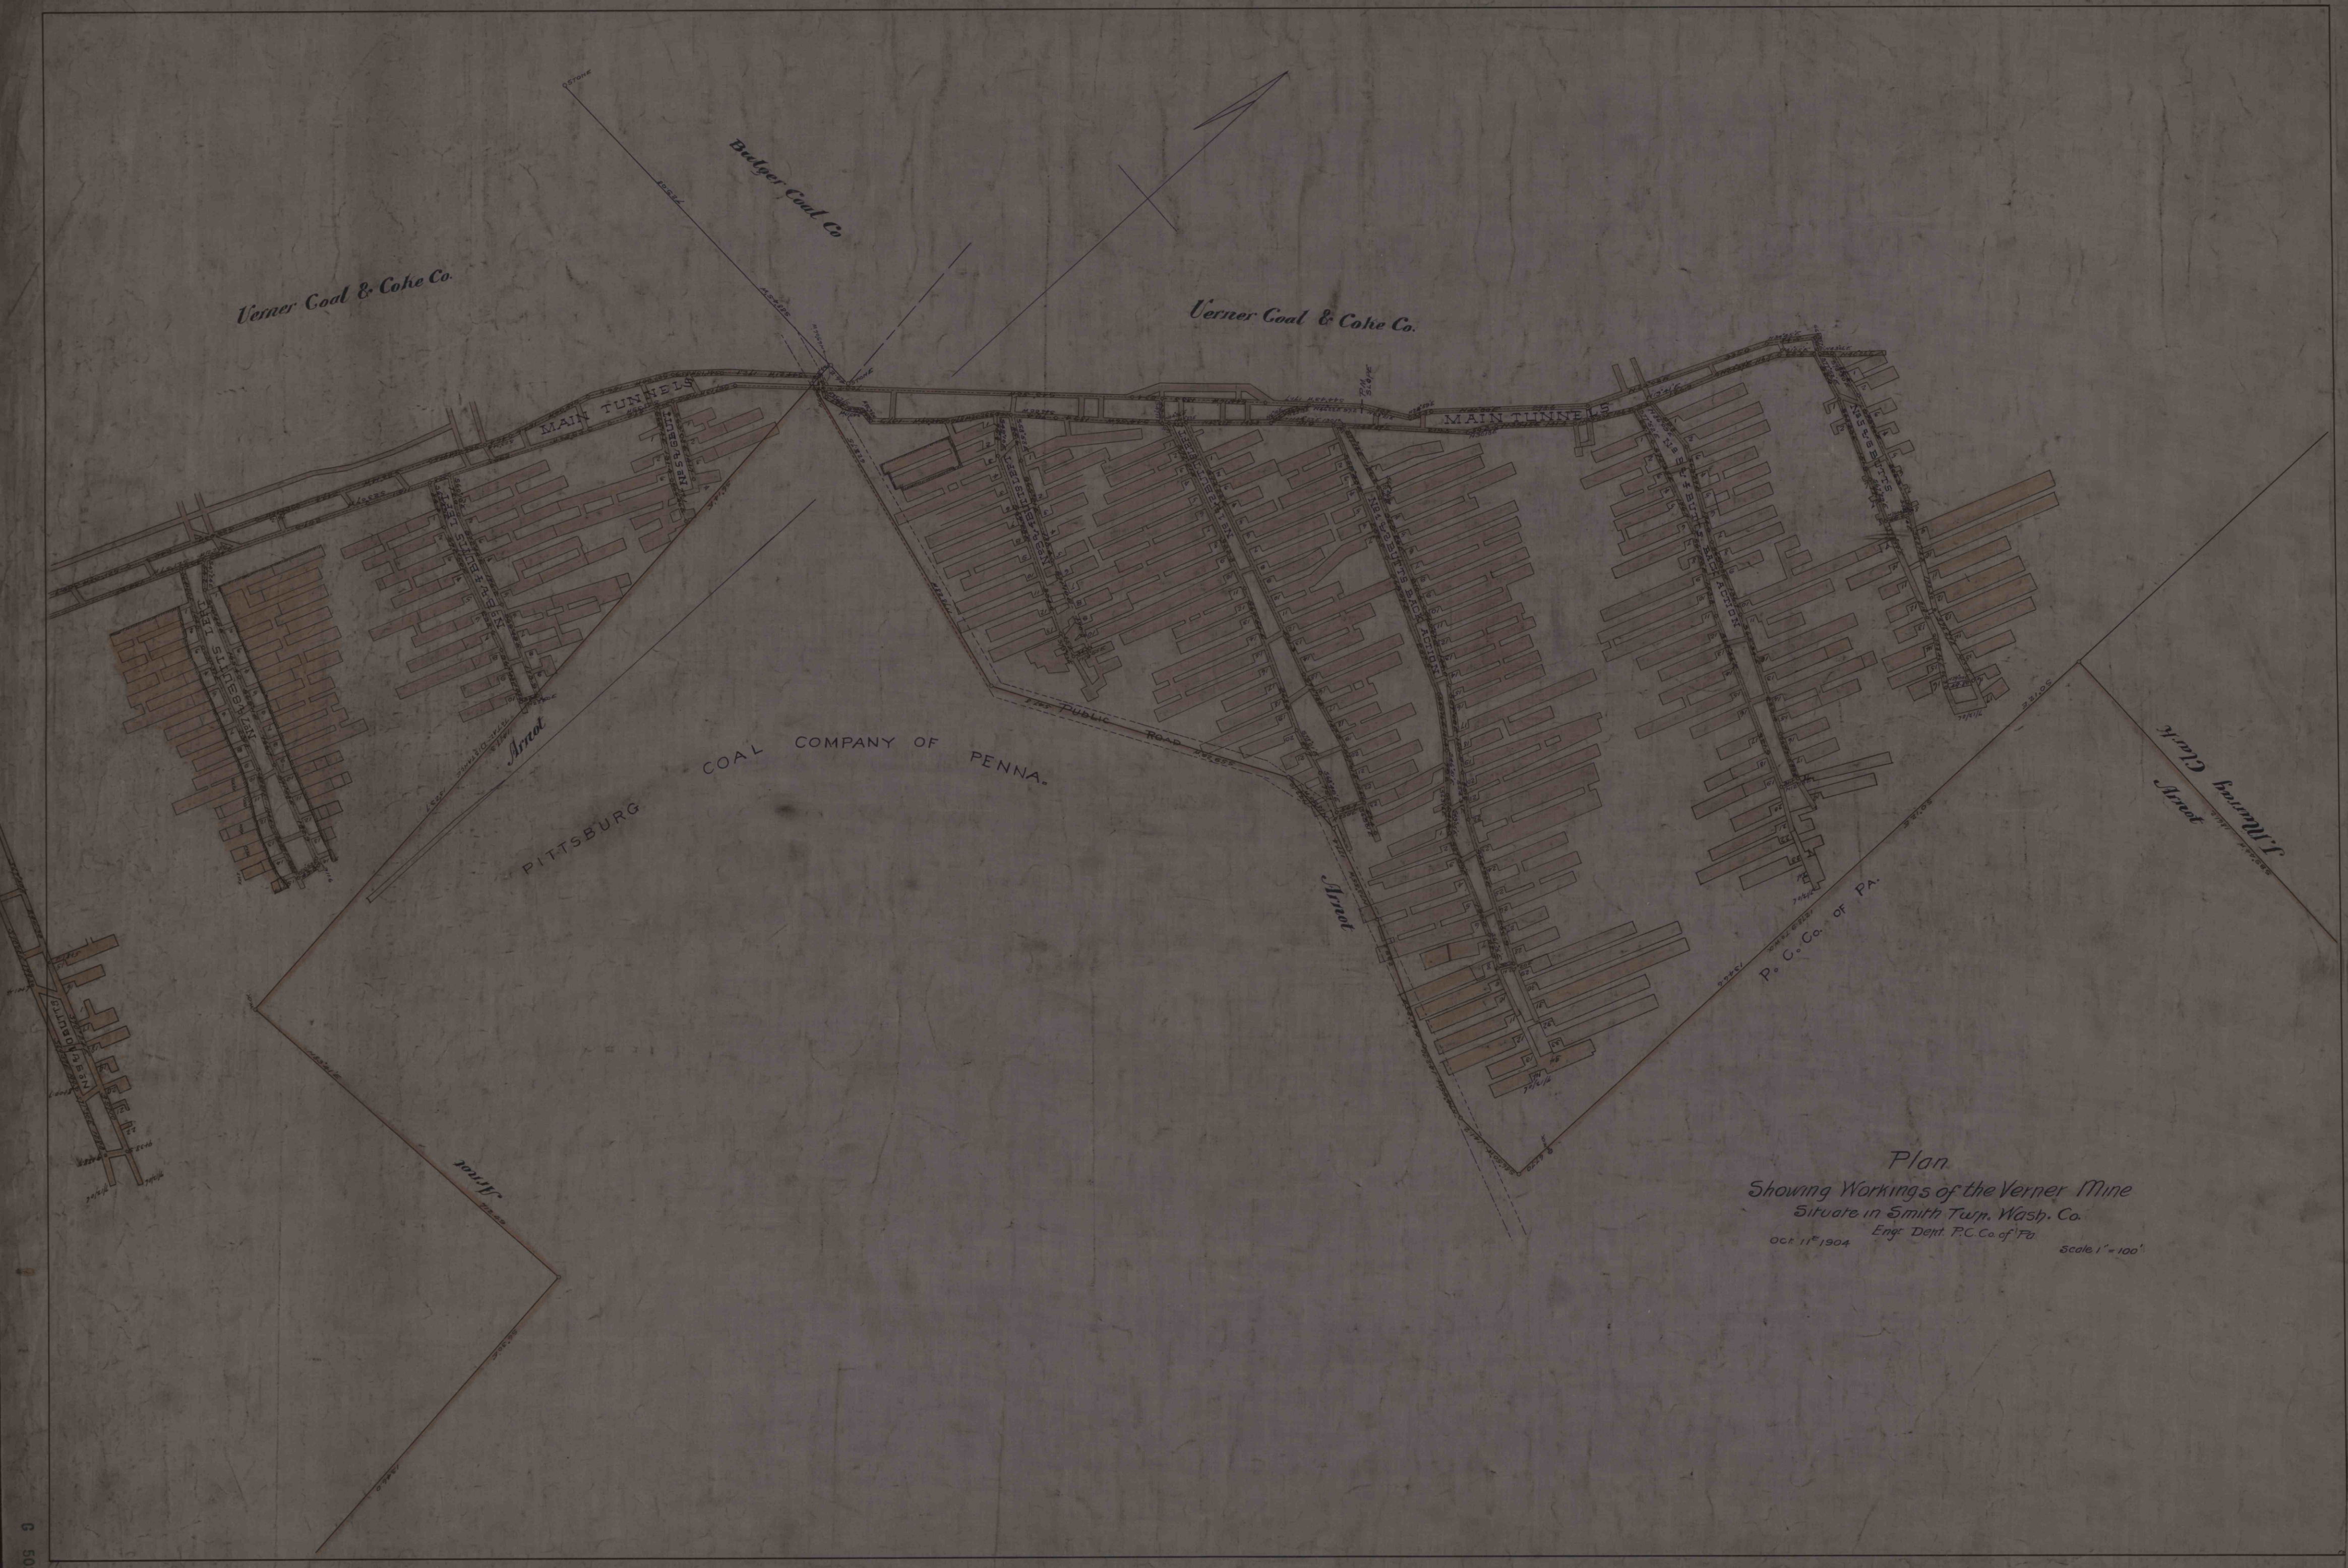

Plan
Showing Workings of the Verner Mine
Situate in Smith Twp. Wash. Co.
Eng. Dept. P.C. Co. of Pa.
Oct. 11th 1904
Scale 1" = 100'