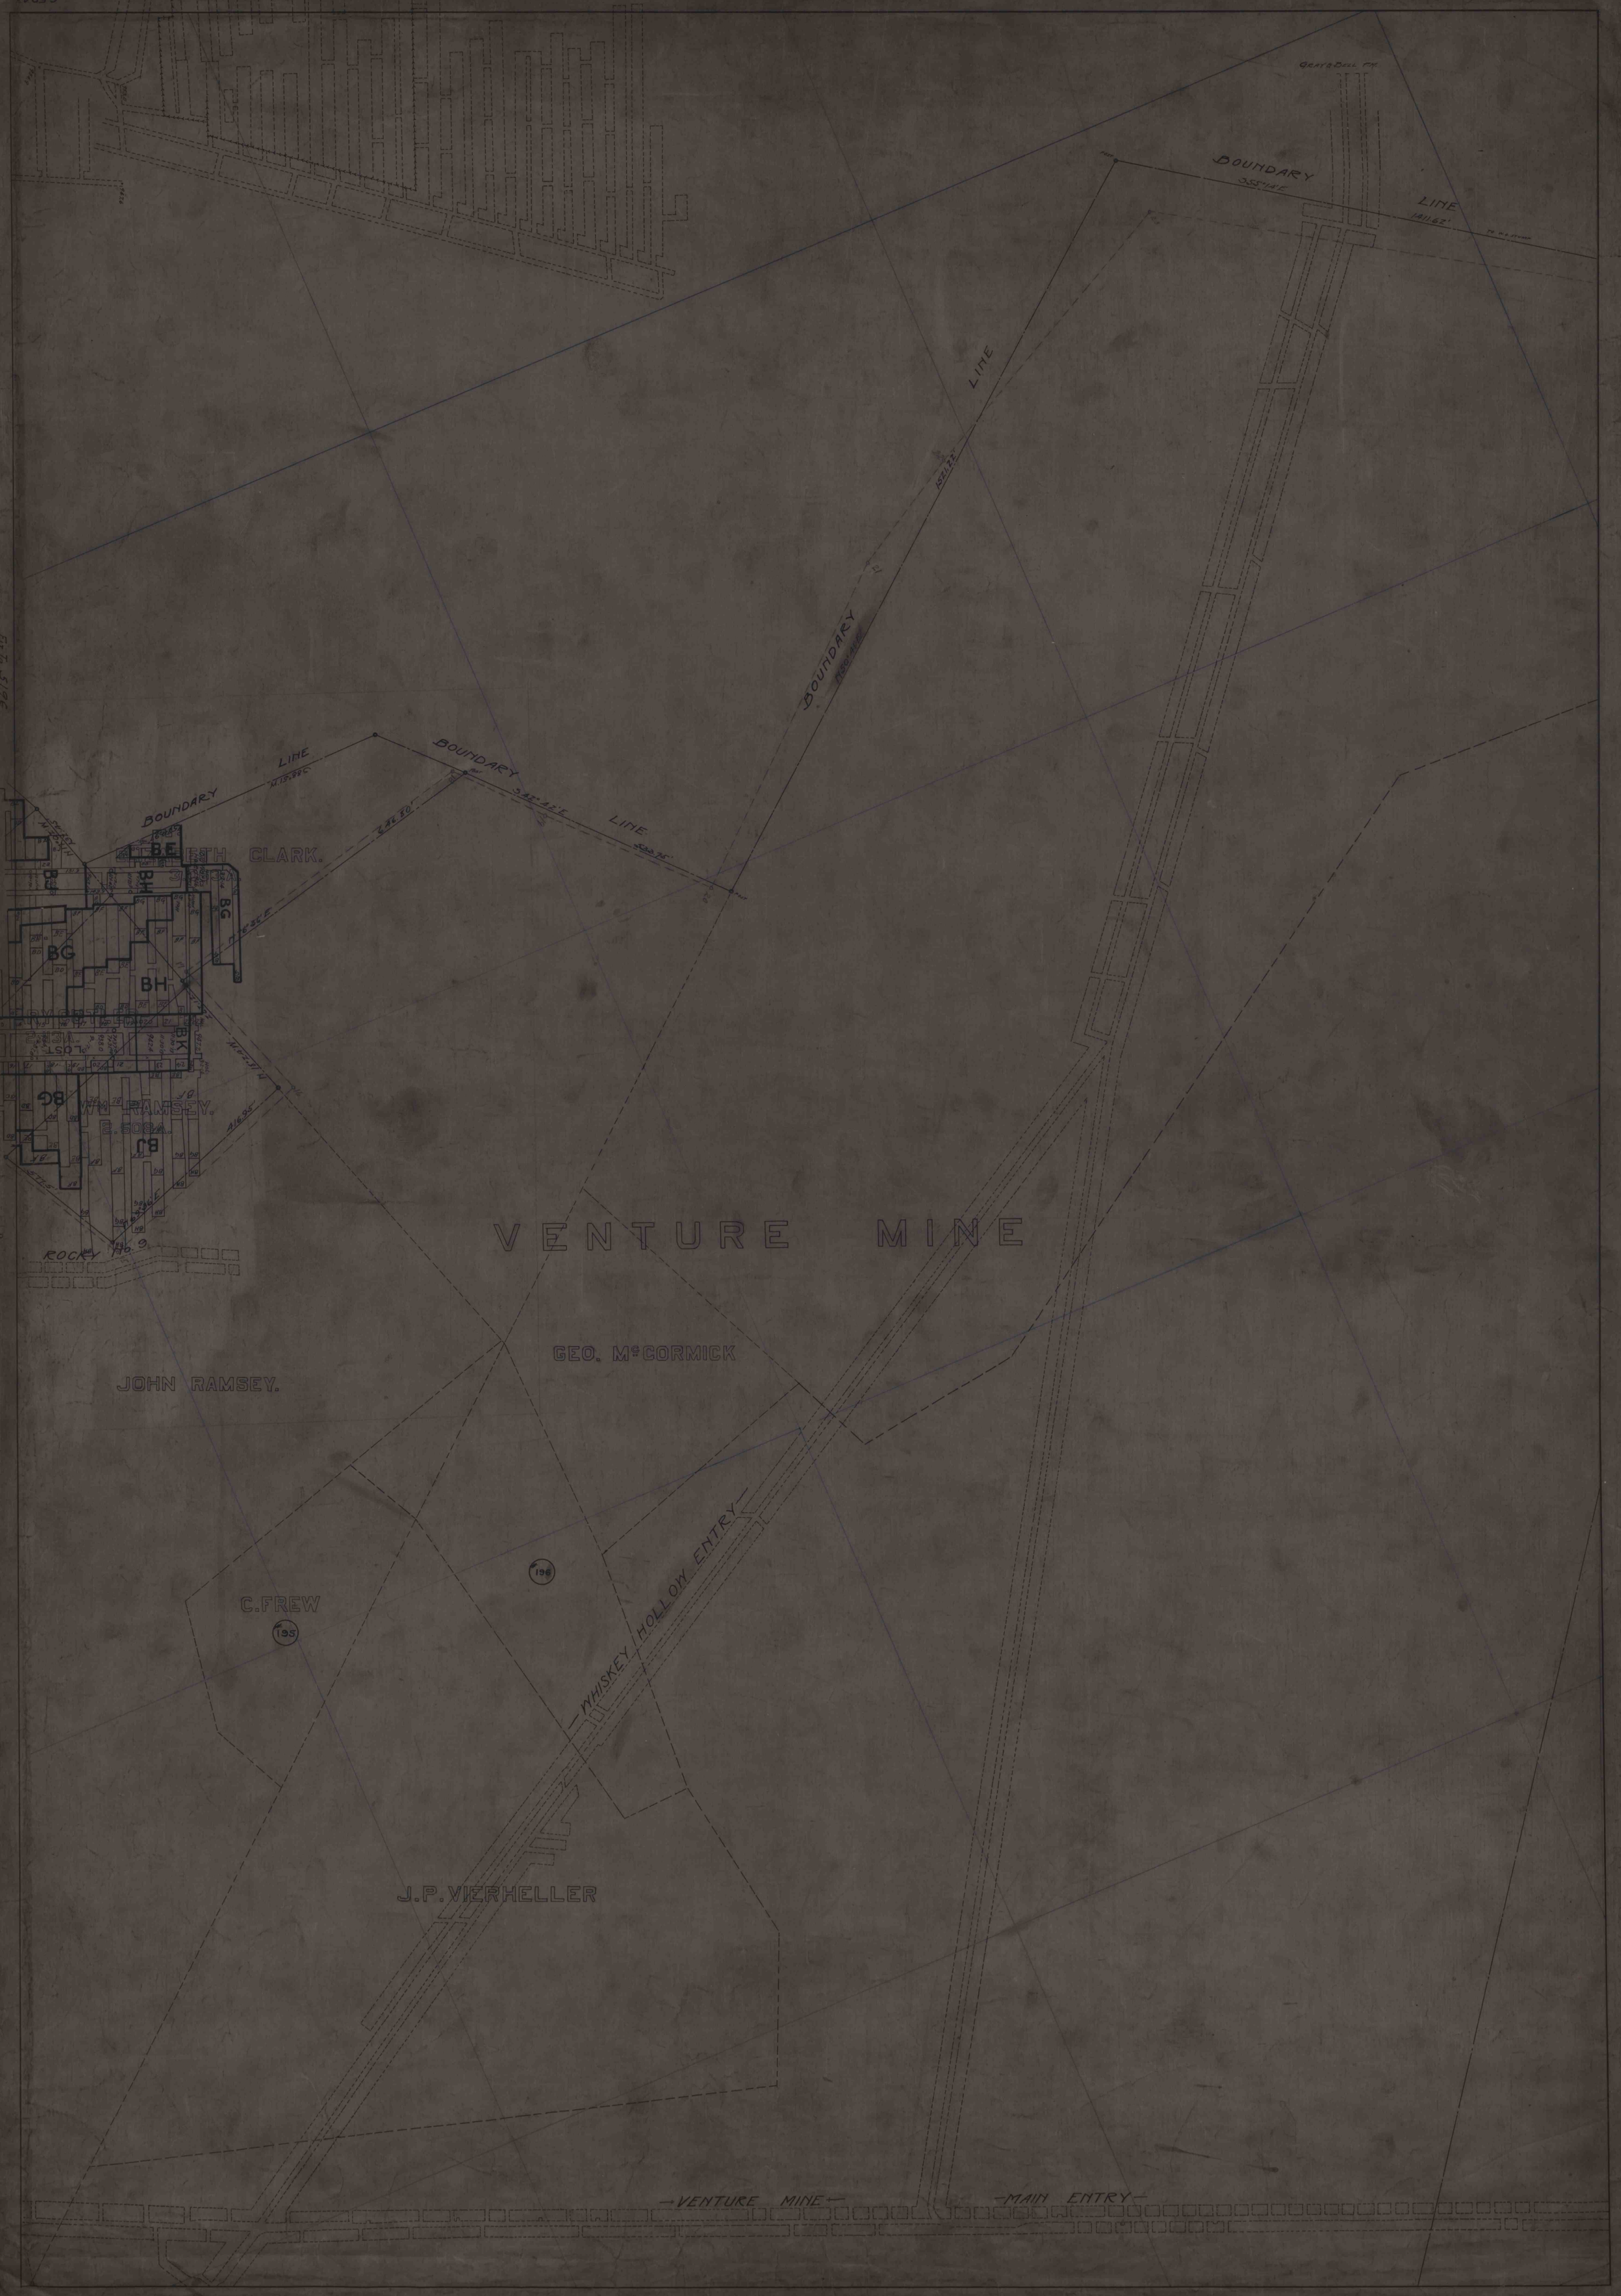
GRAY & DELL FM
BOUNDARY
LINE
BOUNDARY
LINE
BOUNDARY
LINE
BOUNDARY
LINE
BE
BH
BG
BG
BH
BK
BG
BJ
ROCKY No. 9
VENTURE MINE
GEO. McCORMICK
JOHN RAMSEY.
C.FREW
196
195
WHISKEY HOLLOW ENTRY
J.P. VIERHELLER
VENTURE MINE
MAIN ENTRY