


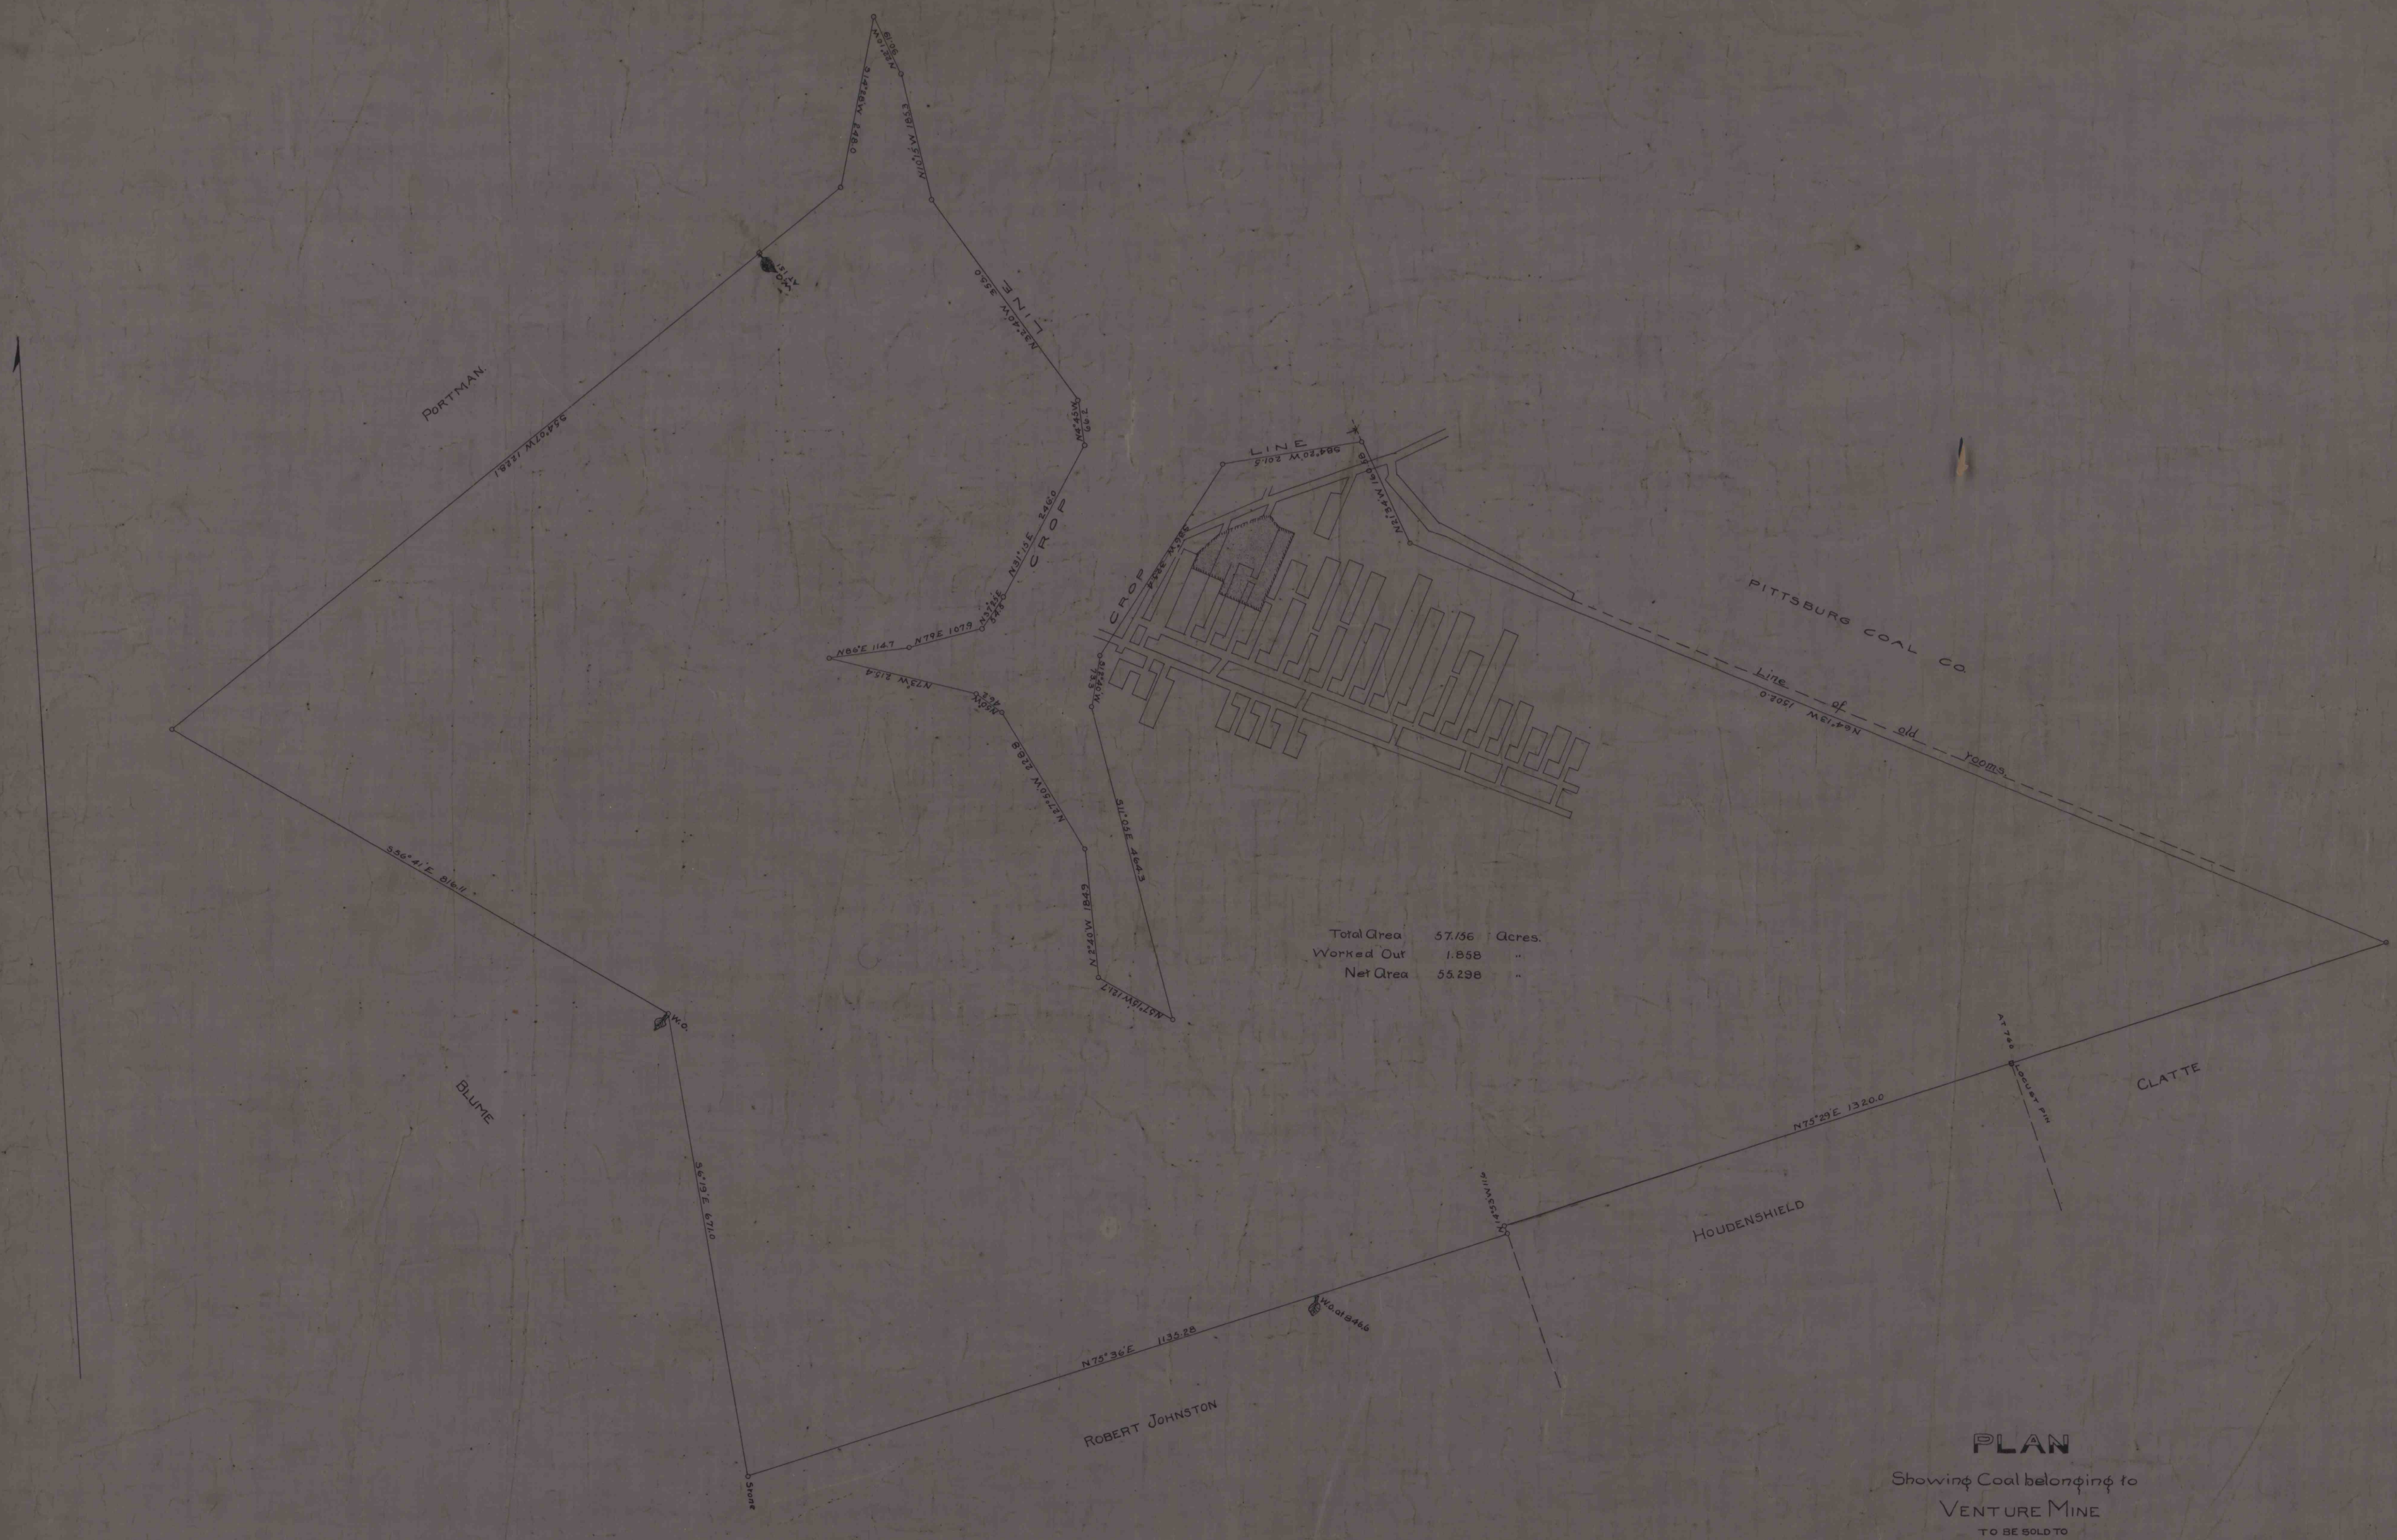

Worked Out	1.858	"
Net Area	55.298	"

PLAN

Showing Coal belonging to
VENTURE MINE
TO BE SOLD TO

MANSFIELD COAL & COKE CO.
Scale 1"=100' or Aug. 1902
Submitted by South Dept. & Greenhouse Dept.
Chas. H. Hays, Sec. Treas.

Approved for A. W. Mellon
Per C 206 E 13