


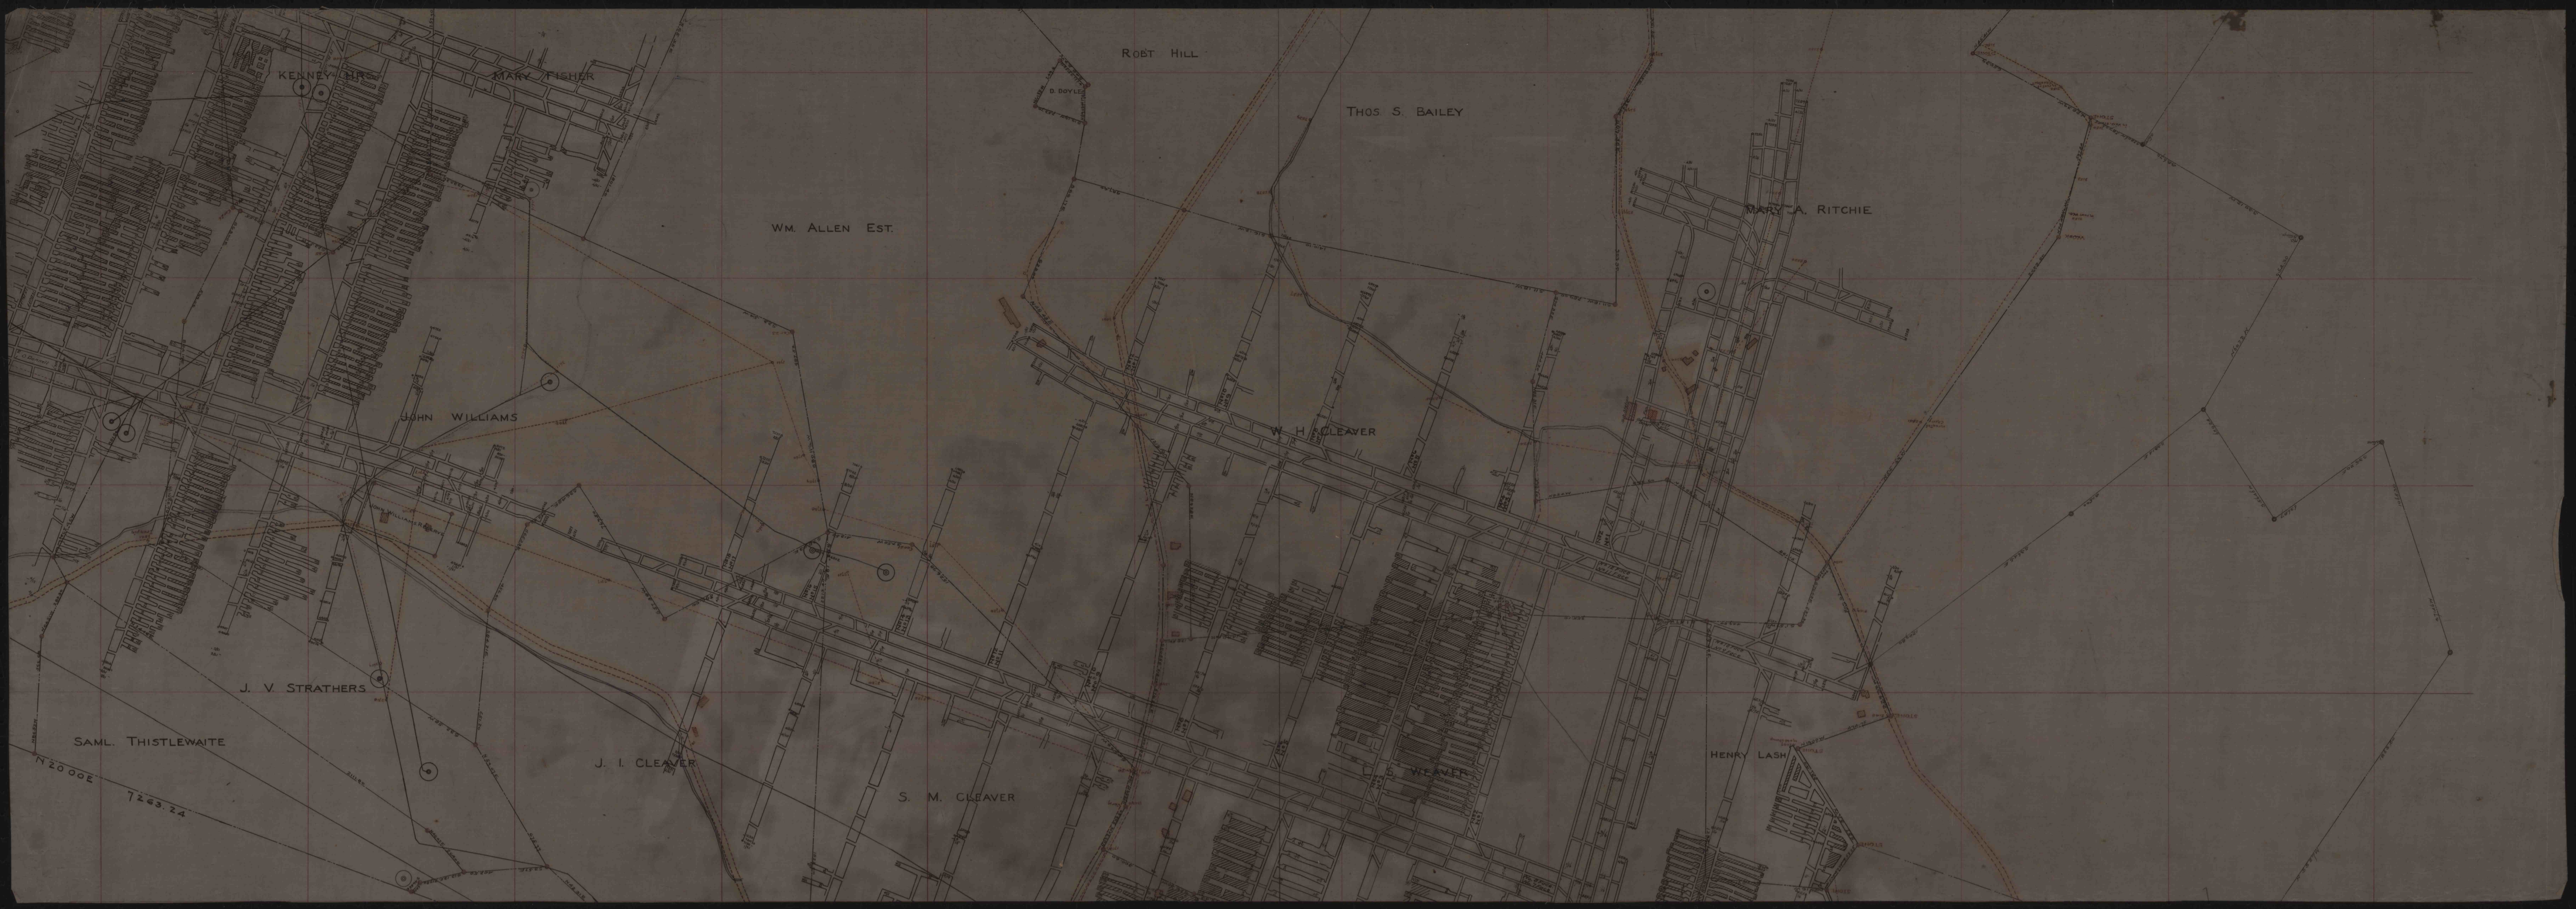

ROBT HILL

THOS S. BAILEY

MARY A. RITCHIE

WM. ALLEN EST.

JOHN WILLIAMS

W. H. CLEAVER

J. V. STRATHERS

J. I. CLEAVER

S. M. CLEAVER

SAML. THISTLEWAITE

HENRY LASH

N 20 00 E
7263.24