


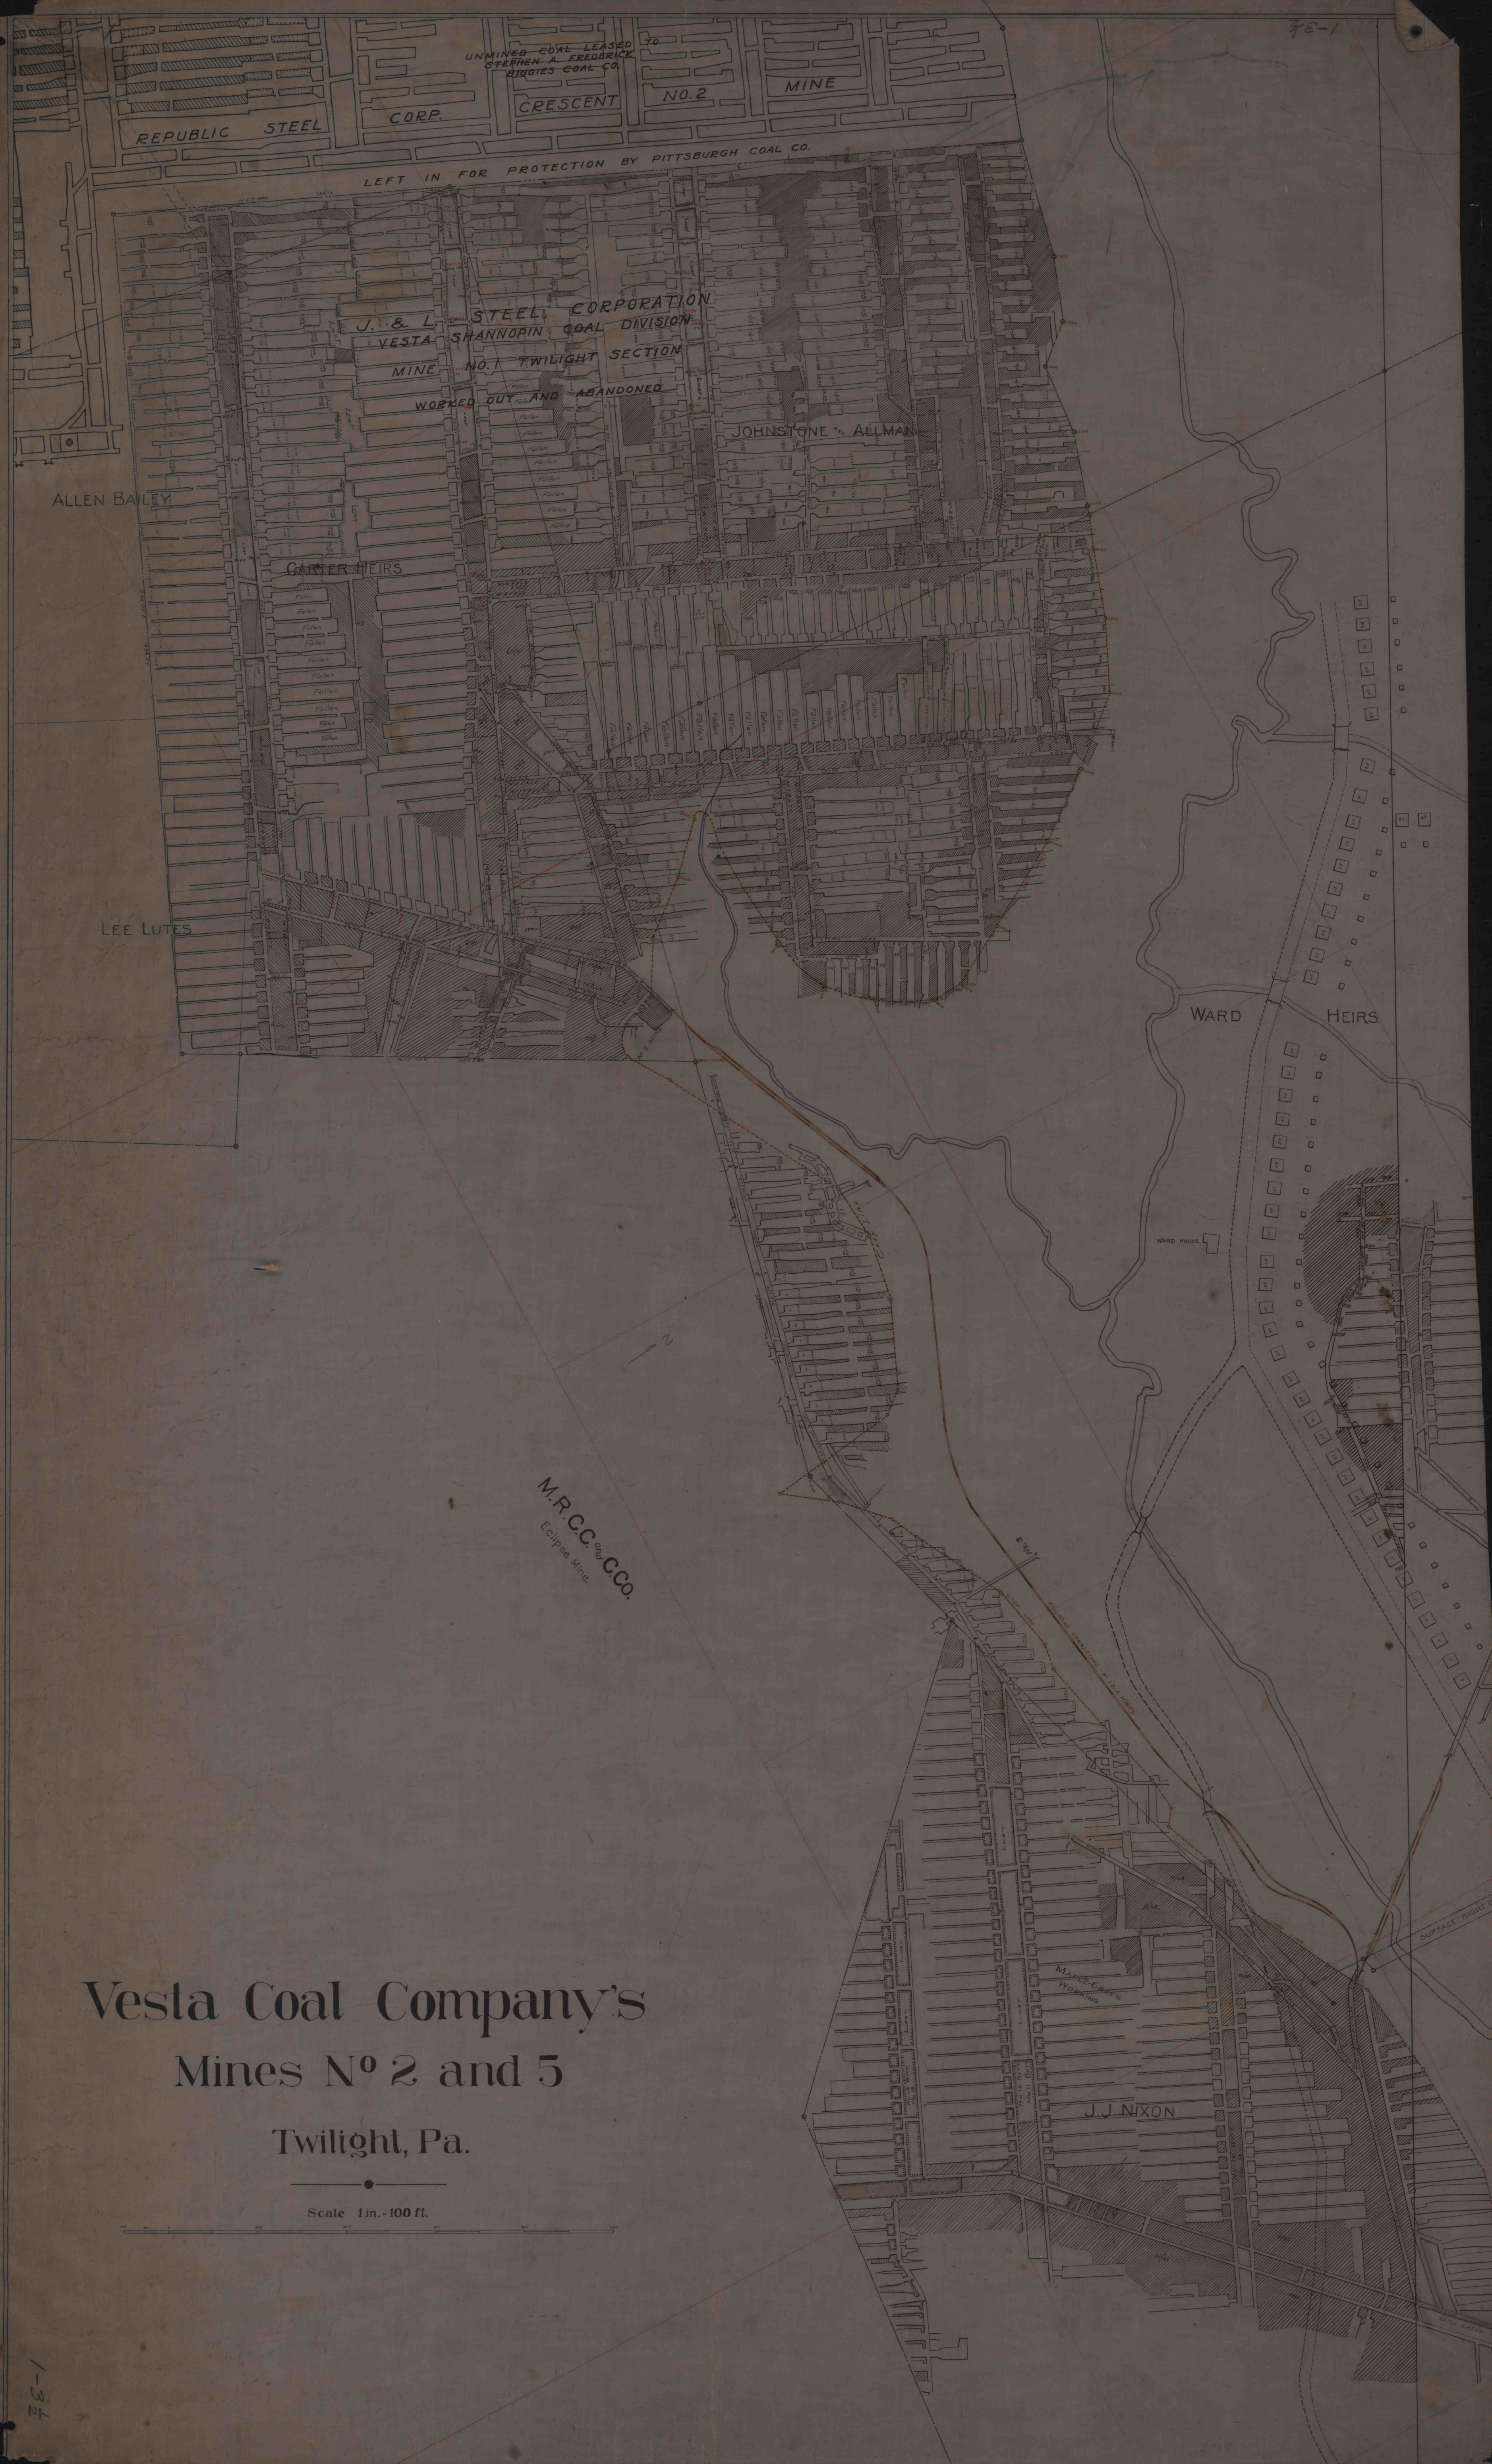

Vesta Coal Company's
Mines N° 2 and 5
Twilight, Pa.

Scale 1 in. = 100 ft.