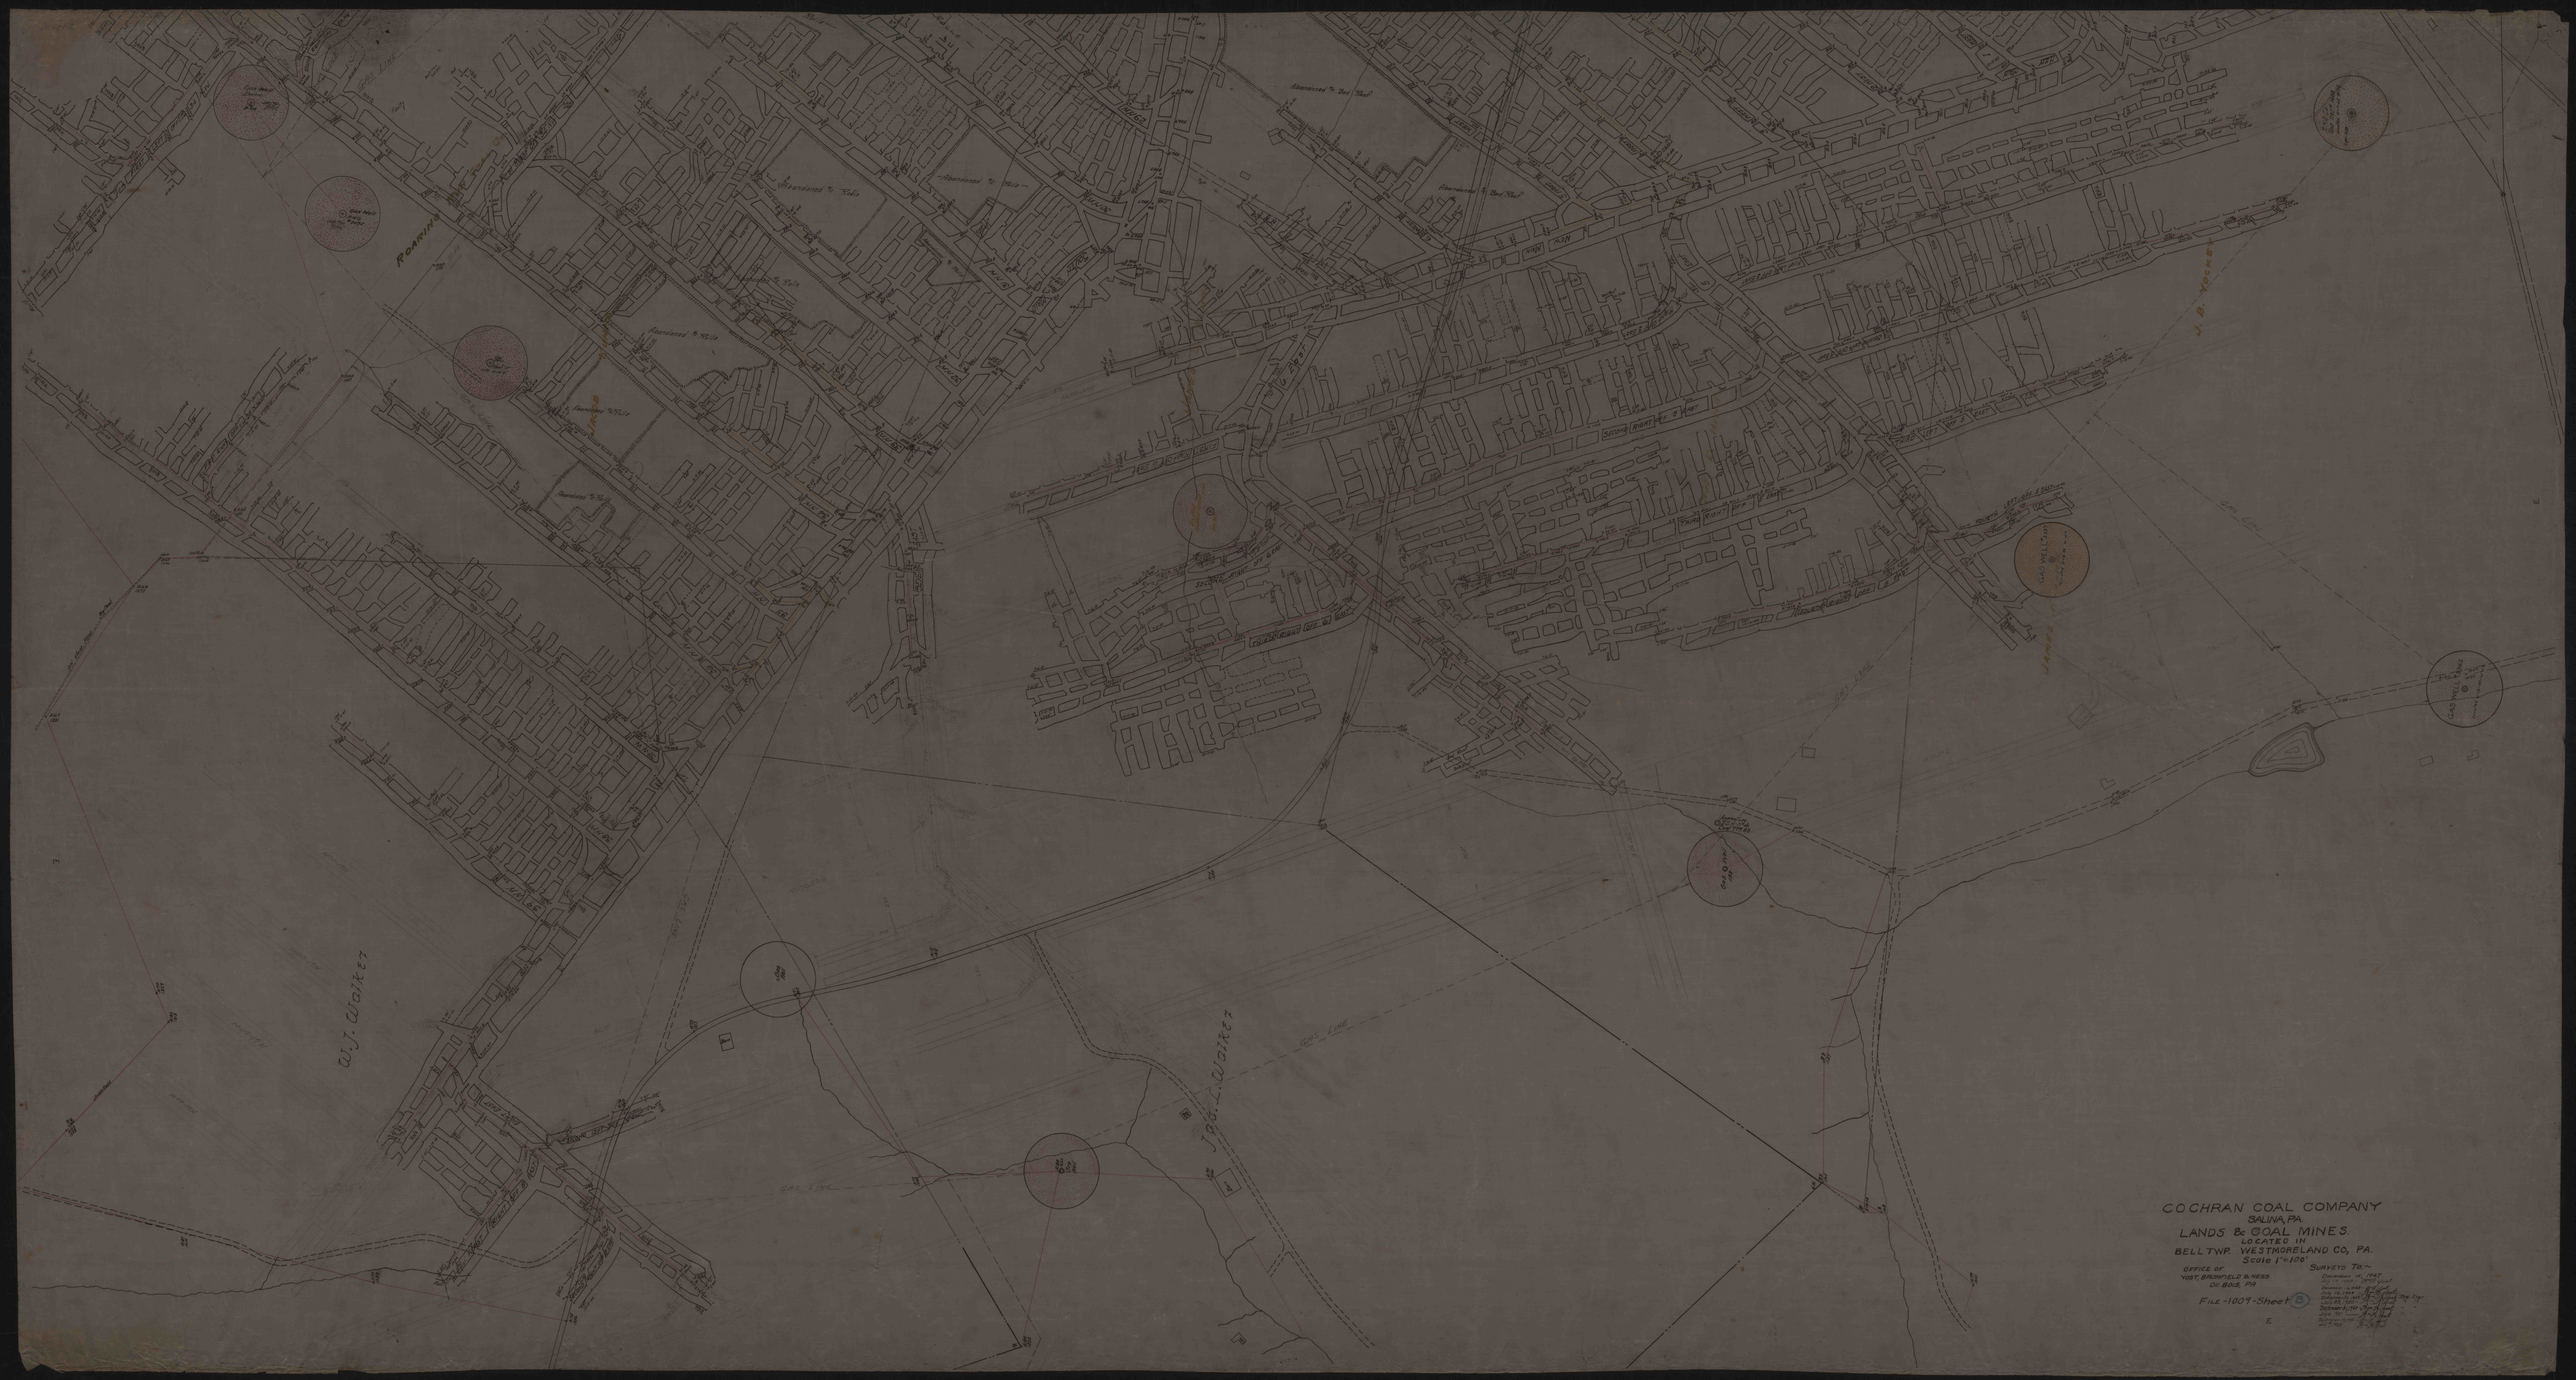
COCHRAN COAL COMPANY
SALIVA, PA.
LANDS & COAL MINES
LOCATED IN
BELL TWP. WESTMORELAND CO, PA.
Scale 1"=100'
OFFICE OF
VOST, BRAINFIELD & HESS
CO. BLDG. PA
SURVEYS TO:-
FILE-1009-Sheet 8
E
W.J. Walker
Jas. L. Walker
J. B. Yocum
Lands of
Abandoned 5" Tile
Abandoned 8" Tile
Abandoned 3" Tile
Abandoned 6" Tile
Abandoned 4" Tile
Abandoned 3" Tile
Abandoned 5" Tile
Abandoned 3" Tile
Abandoned 3" Tile
Abandoned 3