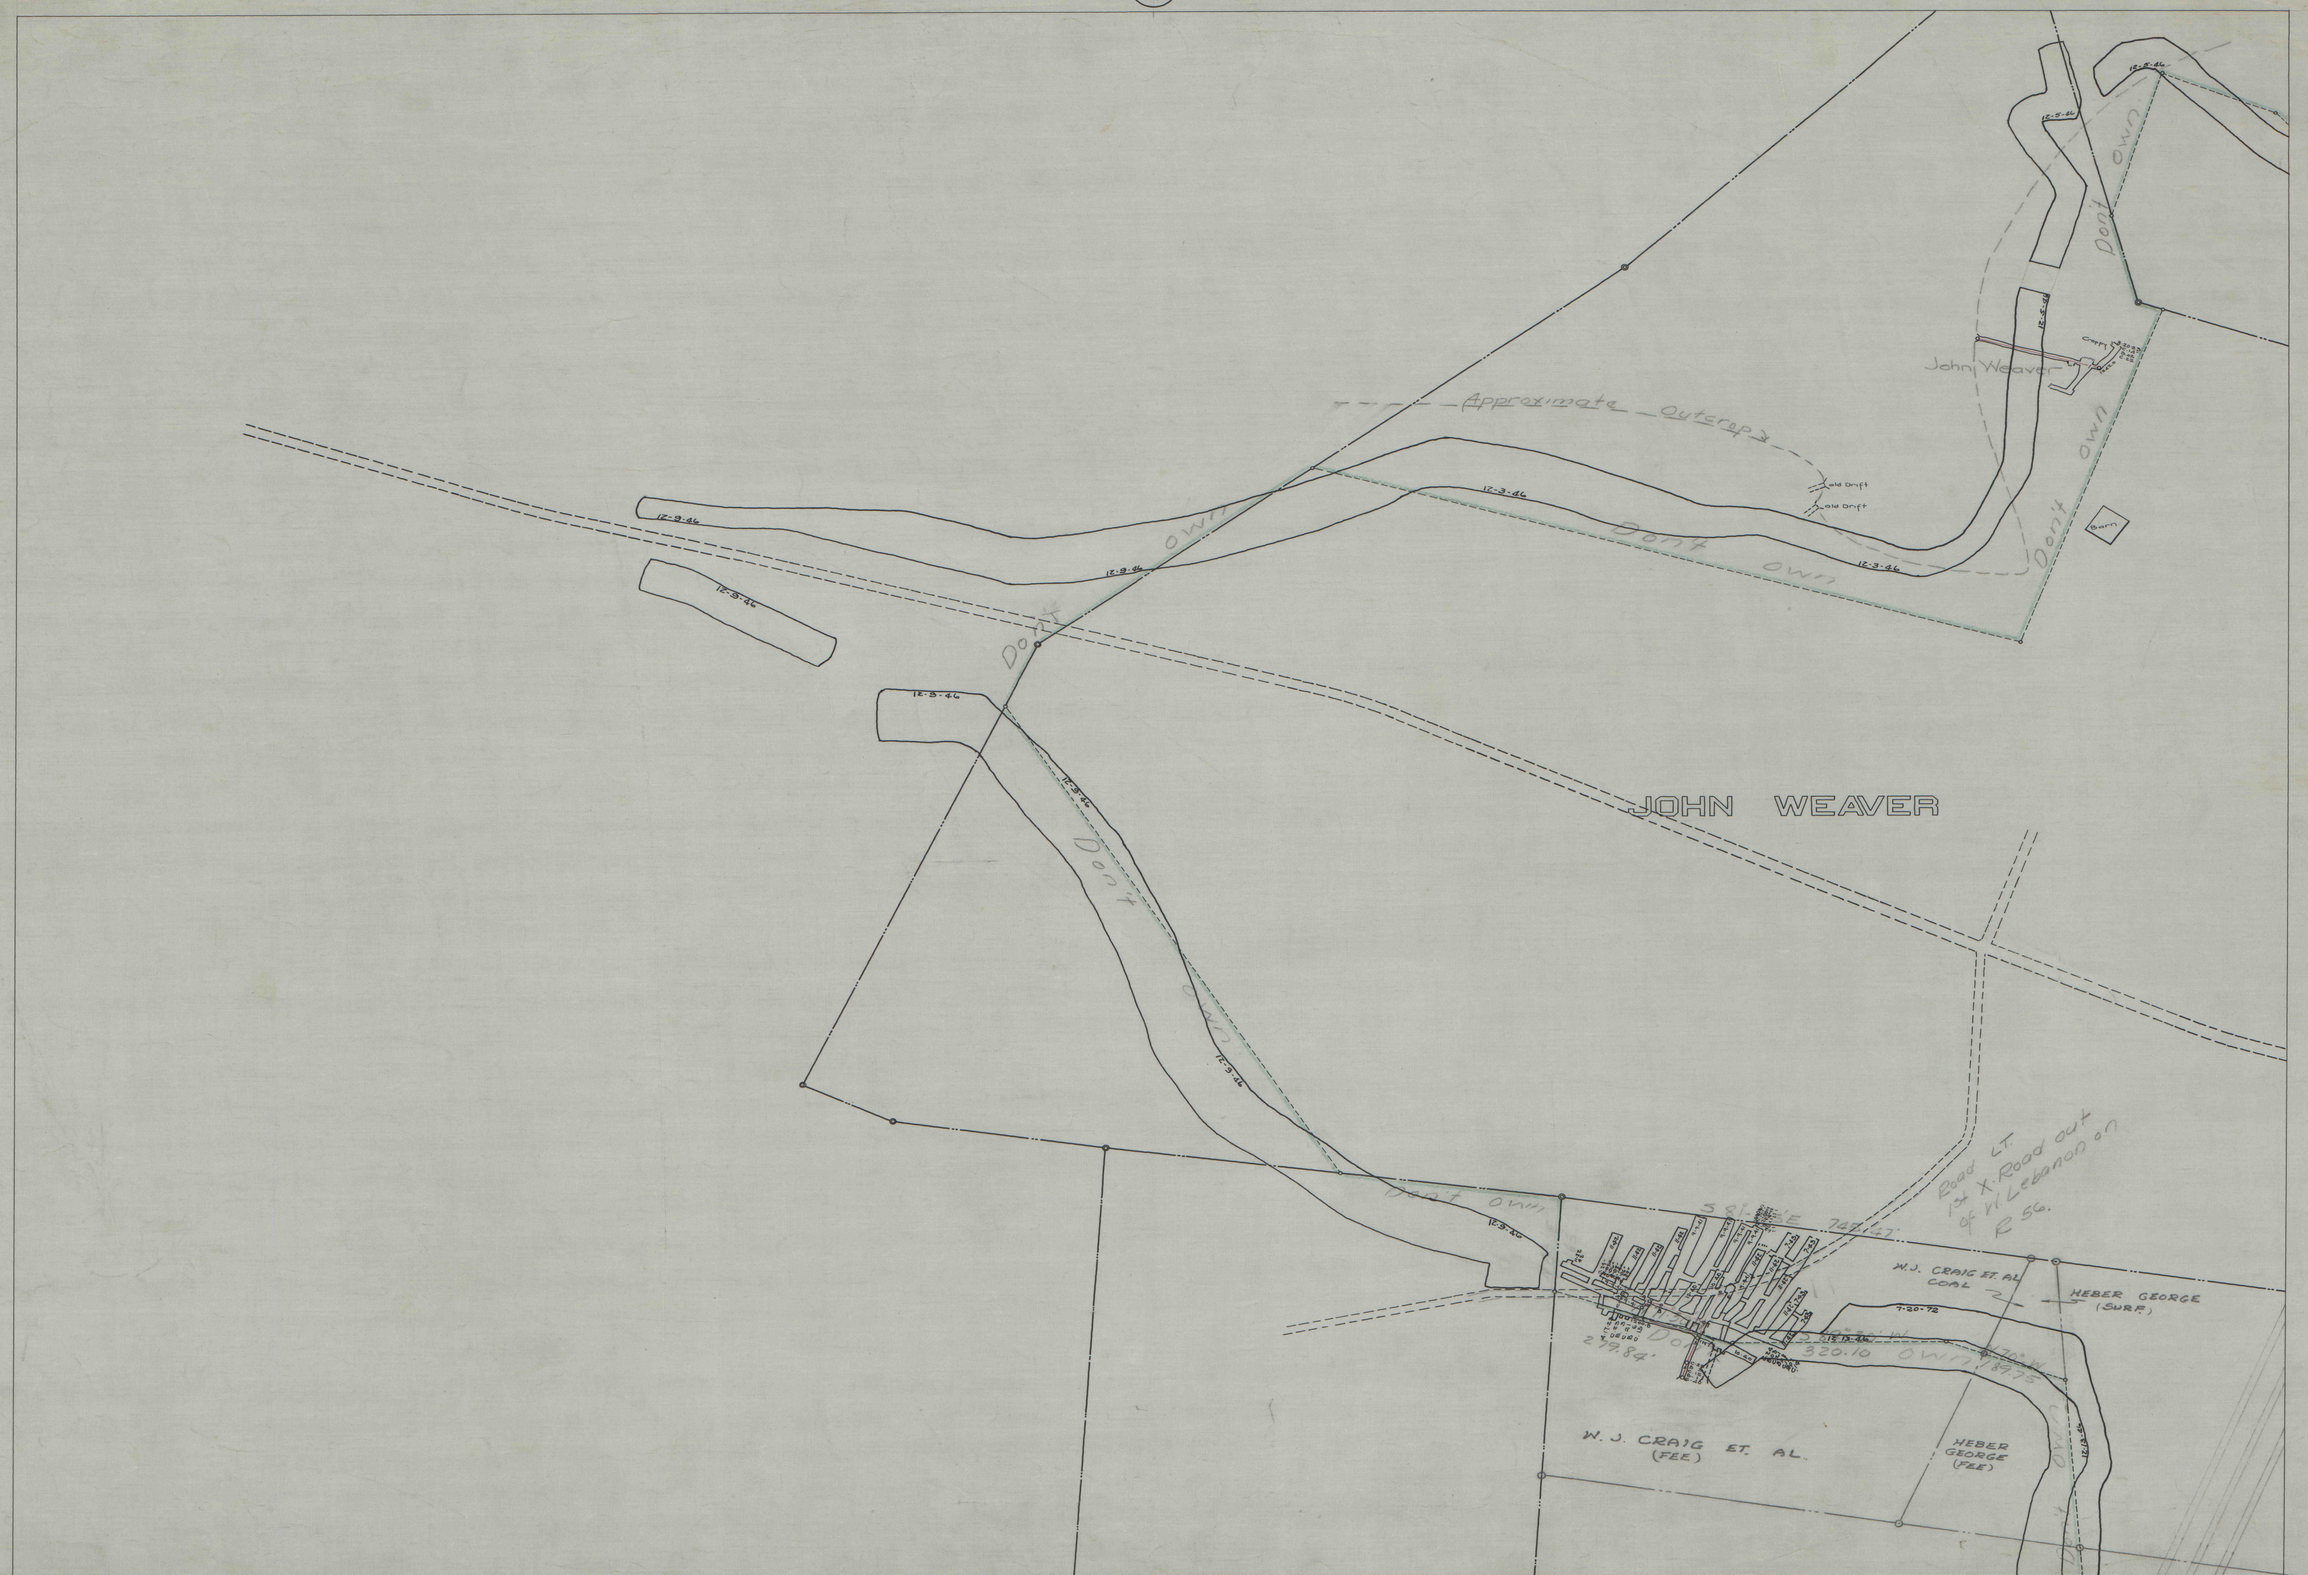

"P" Seam

BASEMENT FILE MICROFILM