


01

A. WILSON & F. CRAIG
(SURF.)

R. B. R. COAL
COAL

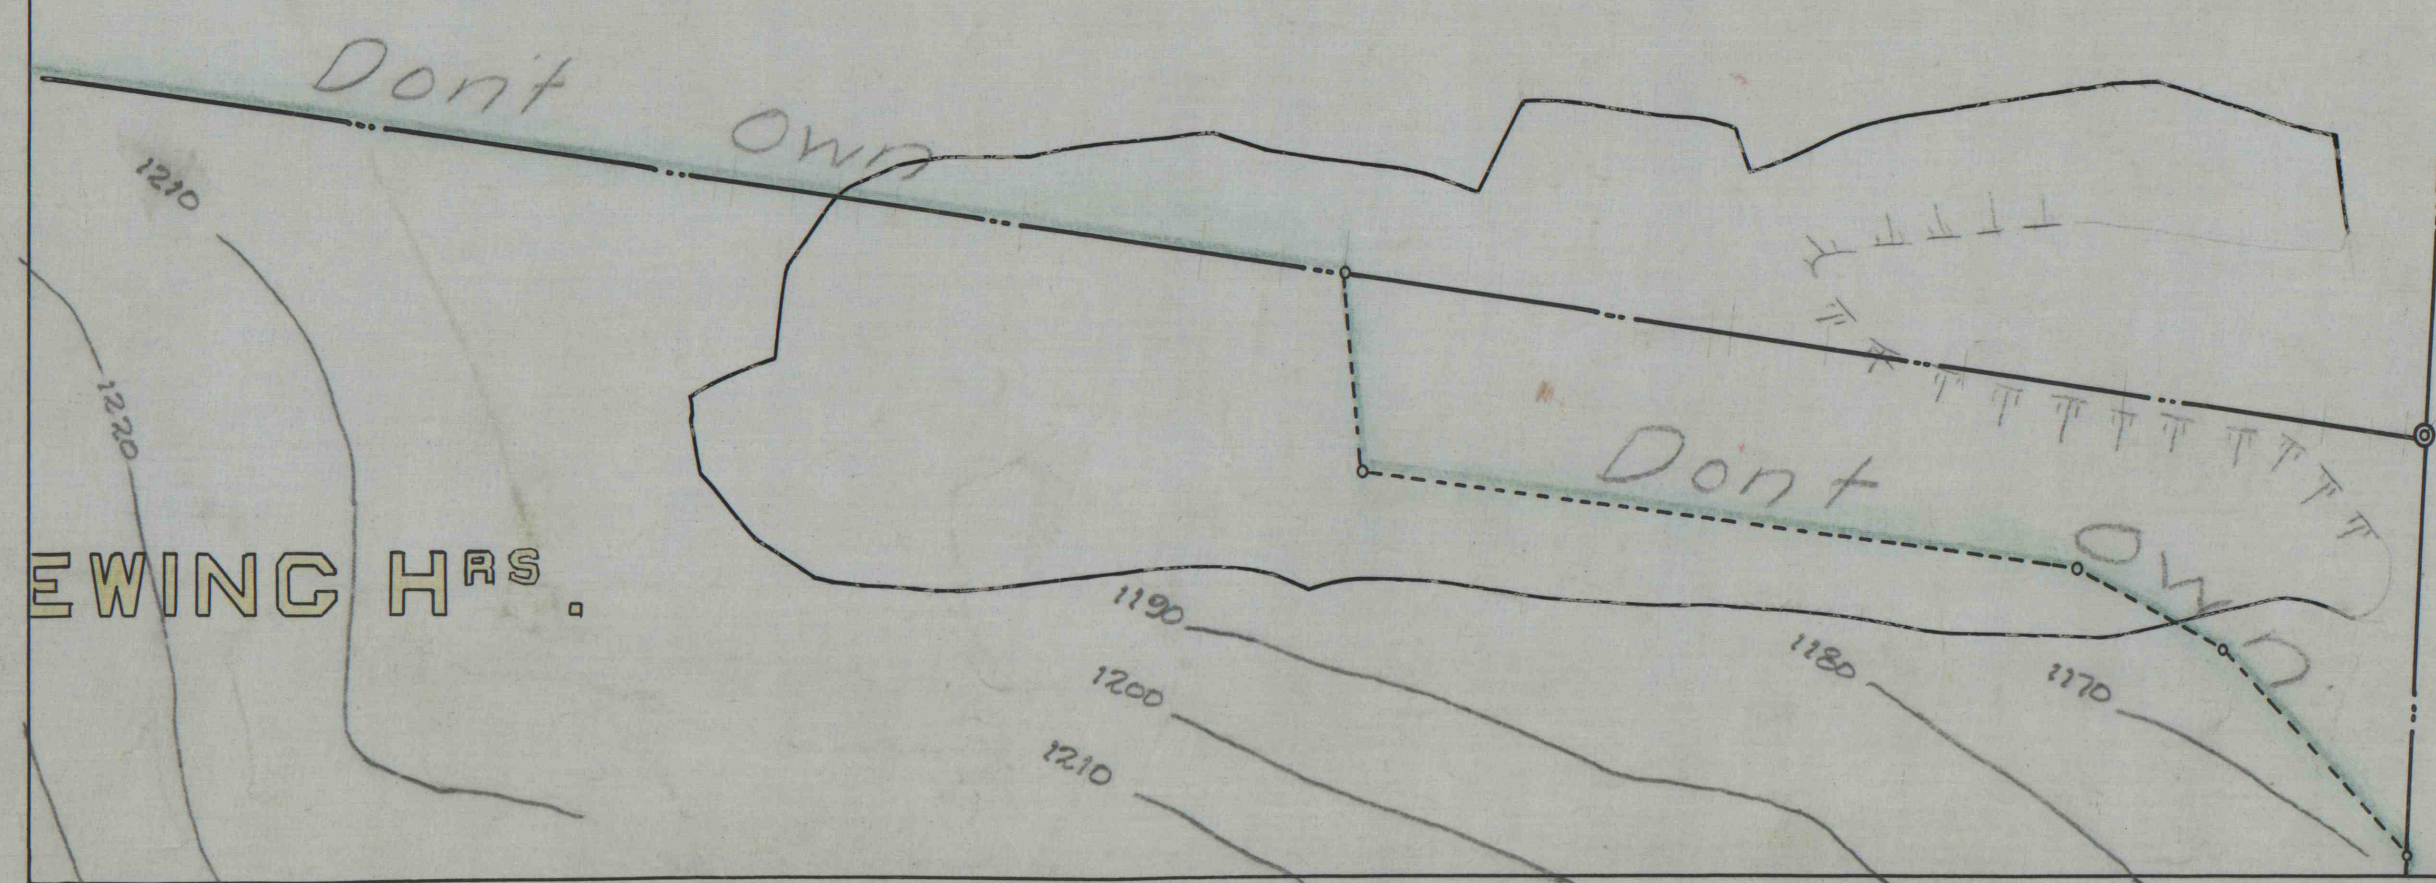

10

"P" Seam

BASEMENT FILE

MICROFILM