


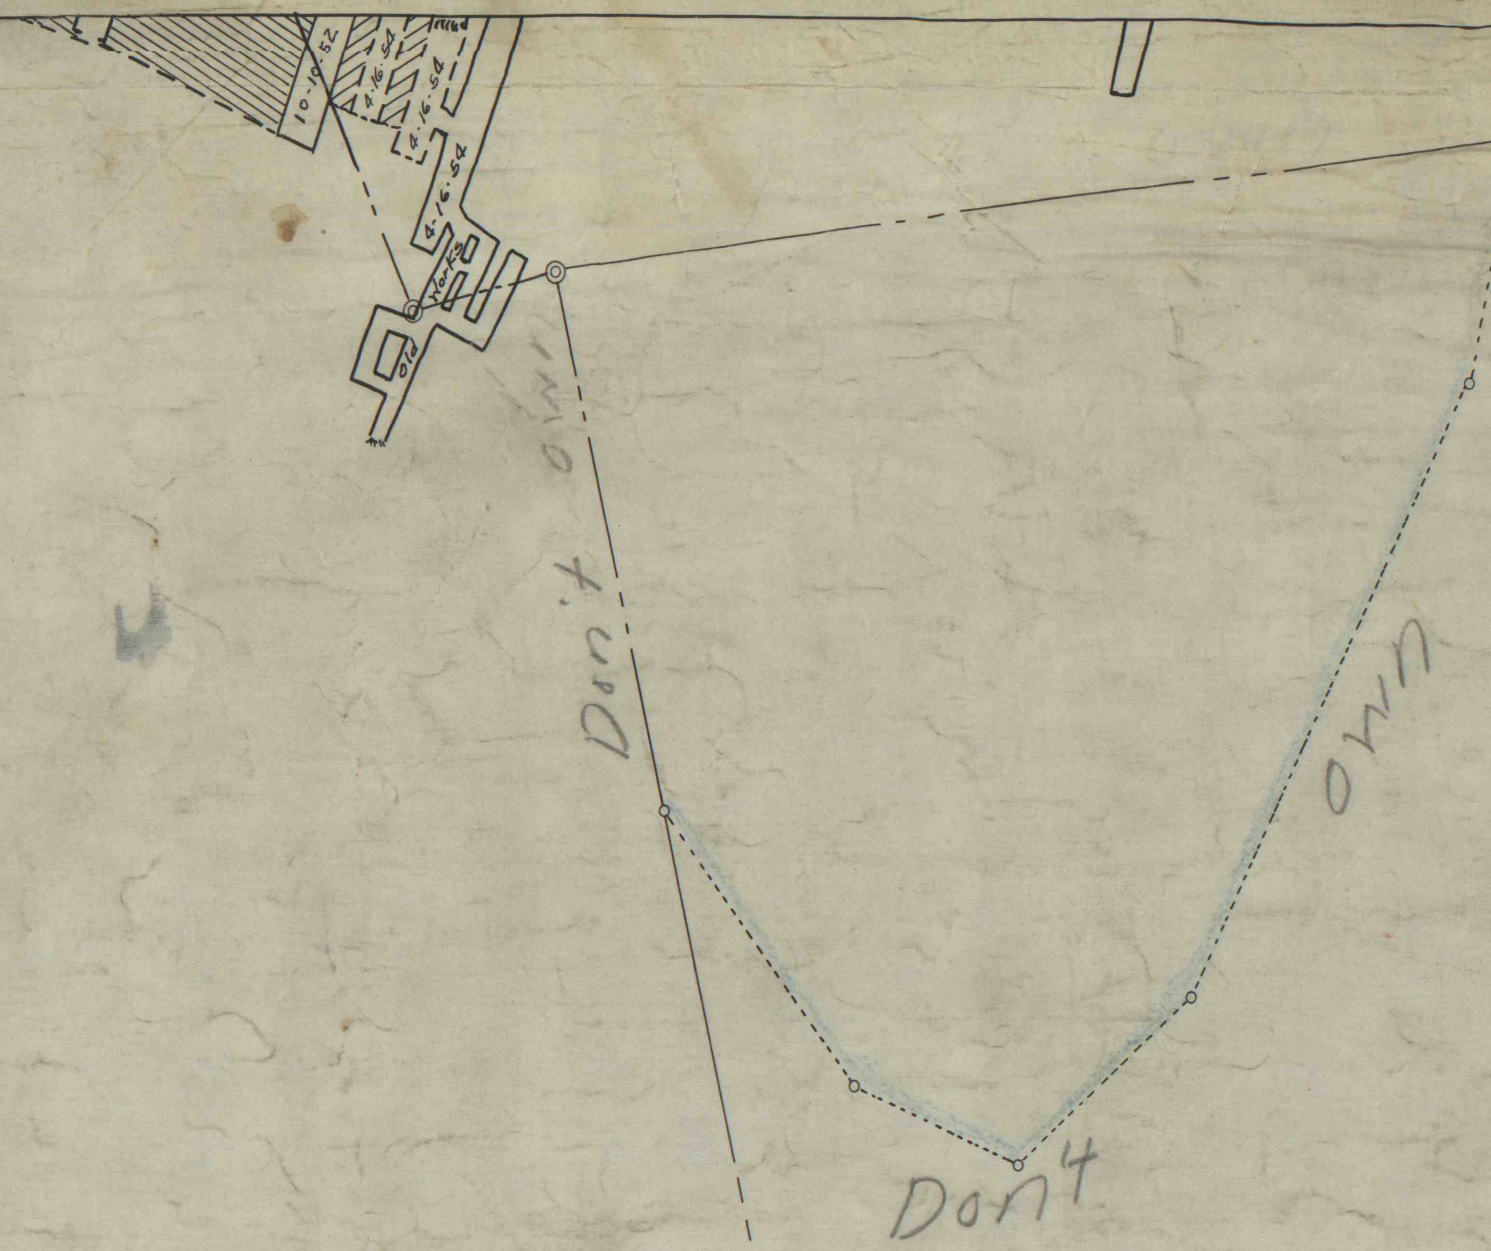

157

158


161

162

8°

160

JAS. CRAWFORD
DONT OWN

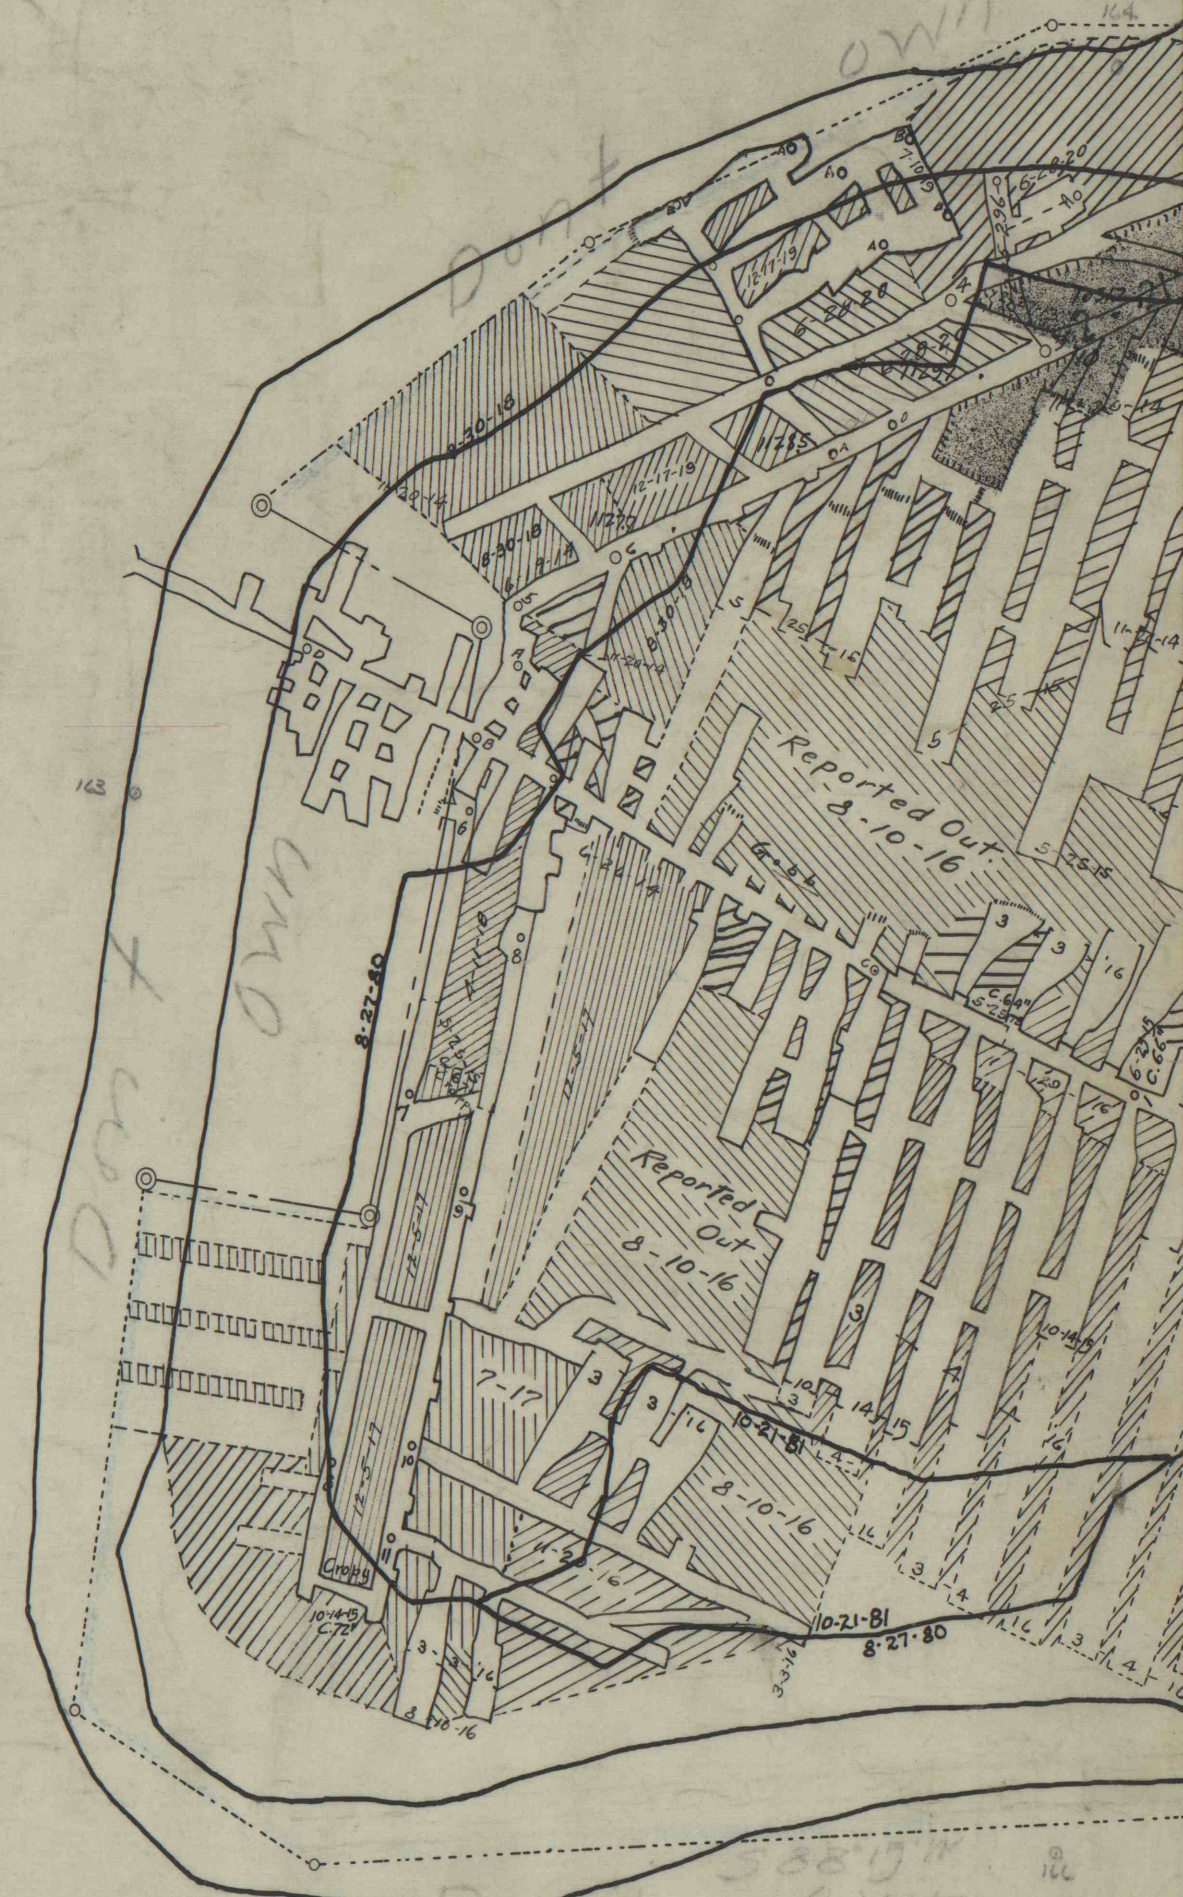

NEELY COAL CO
SALTSBURG PA.
TD. 360645

8-4-60

DRAWN BY
112

(61)

BASEMENT FILE MICROFILM "p" Seam

Iselin #1 Sec. 1

Dr. 5