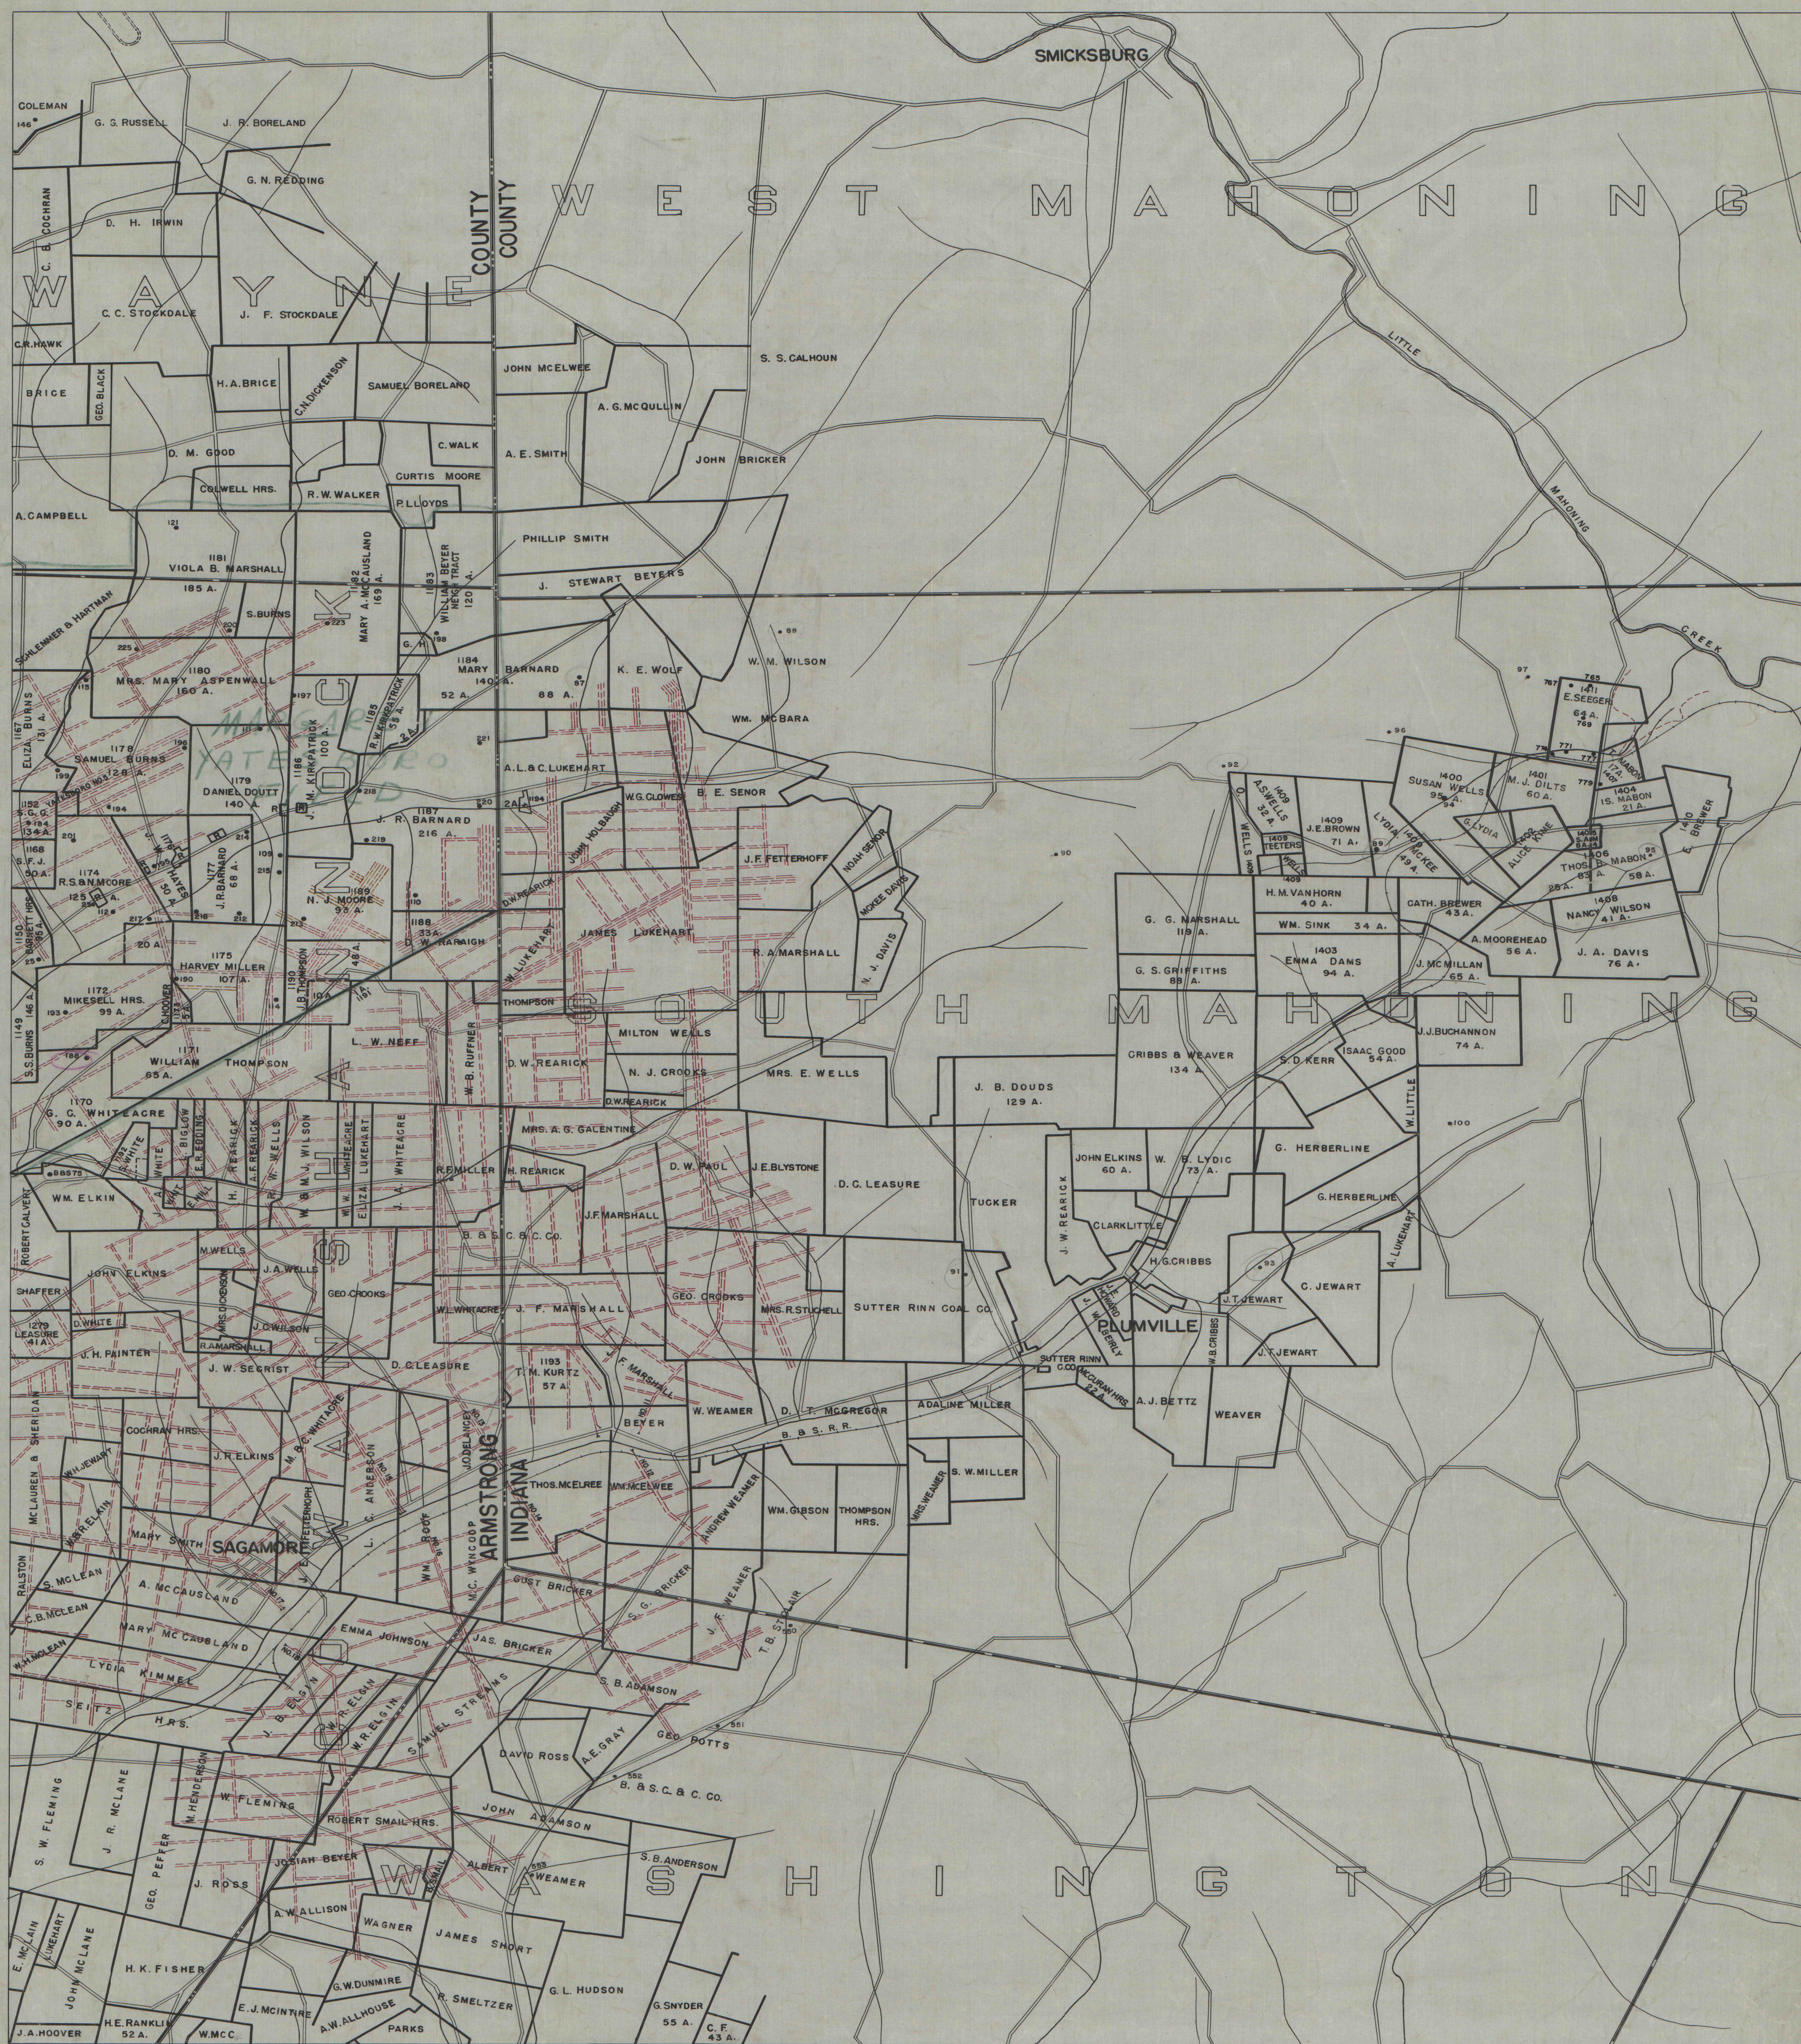



$$1'' = 1320'$$