


77

77

KENT E SEAM DRAWER 109

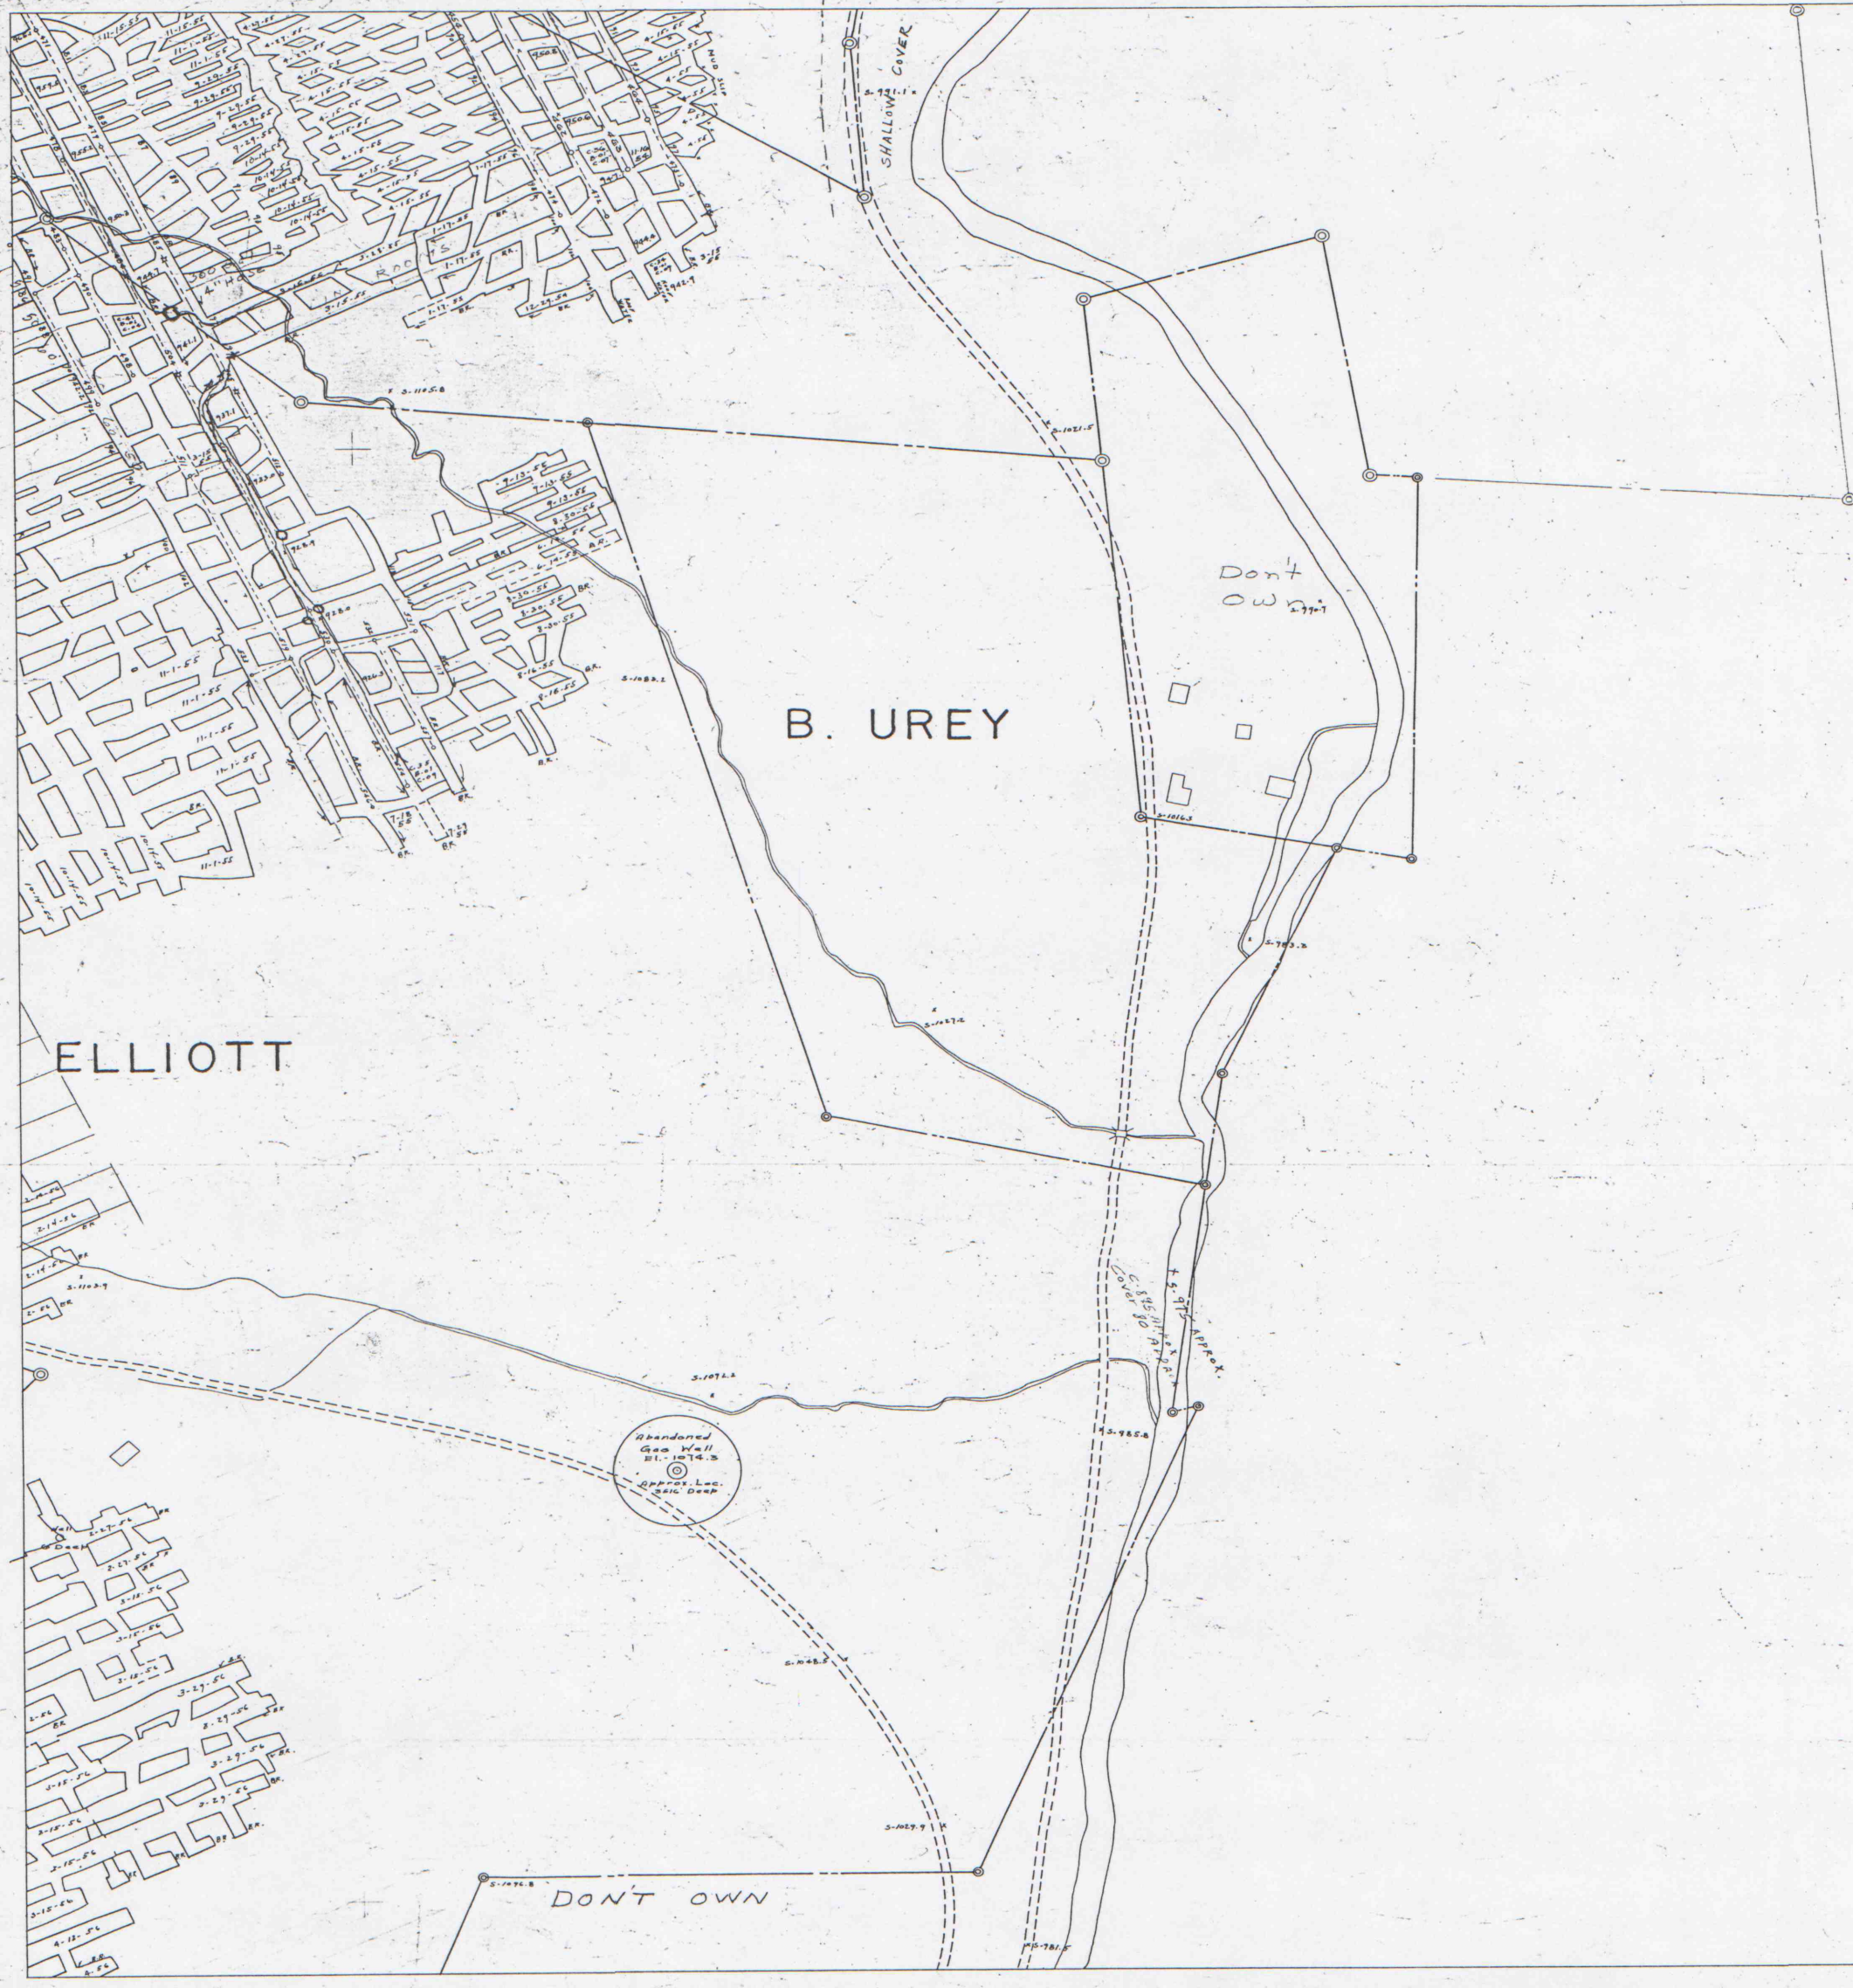

KENT E SEAM DRAWER 109 BASEMENT FILE

77

HELVETIA COAL COMPANY
CLARKSBURG, INDIANA COUNTY, PA.
Scale 1" = 200 Date 11-9-25

13205 BASEMENT 109