


80

KENT E SEAM DRAWER 109

80

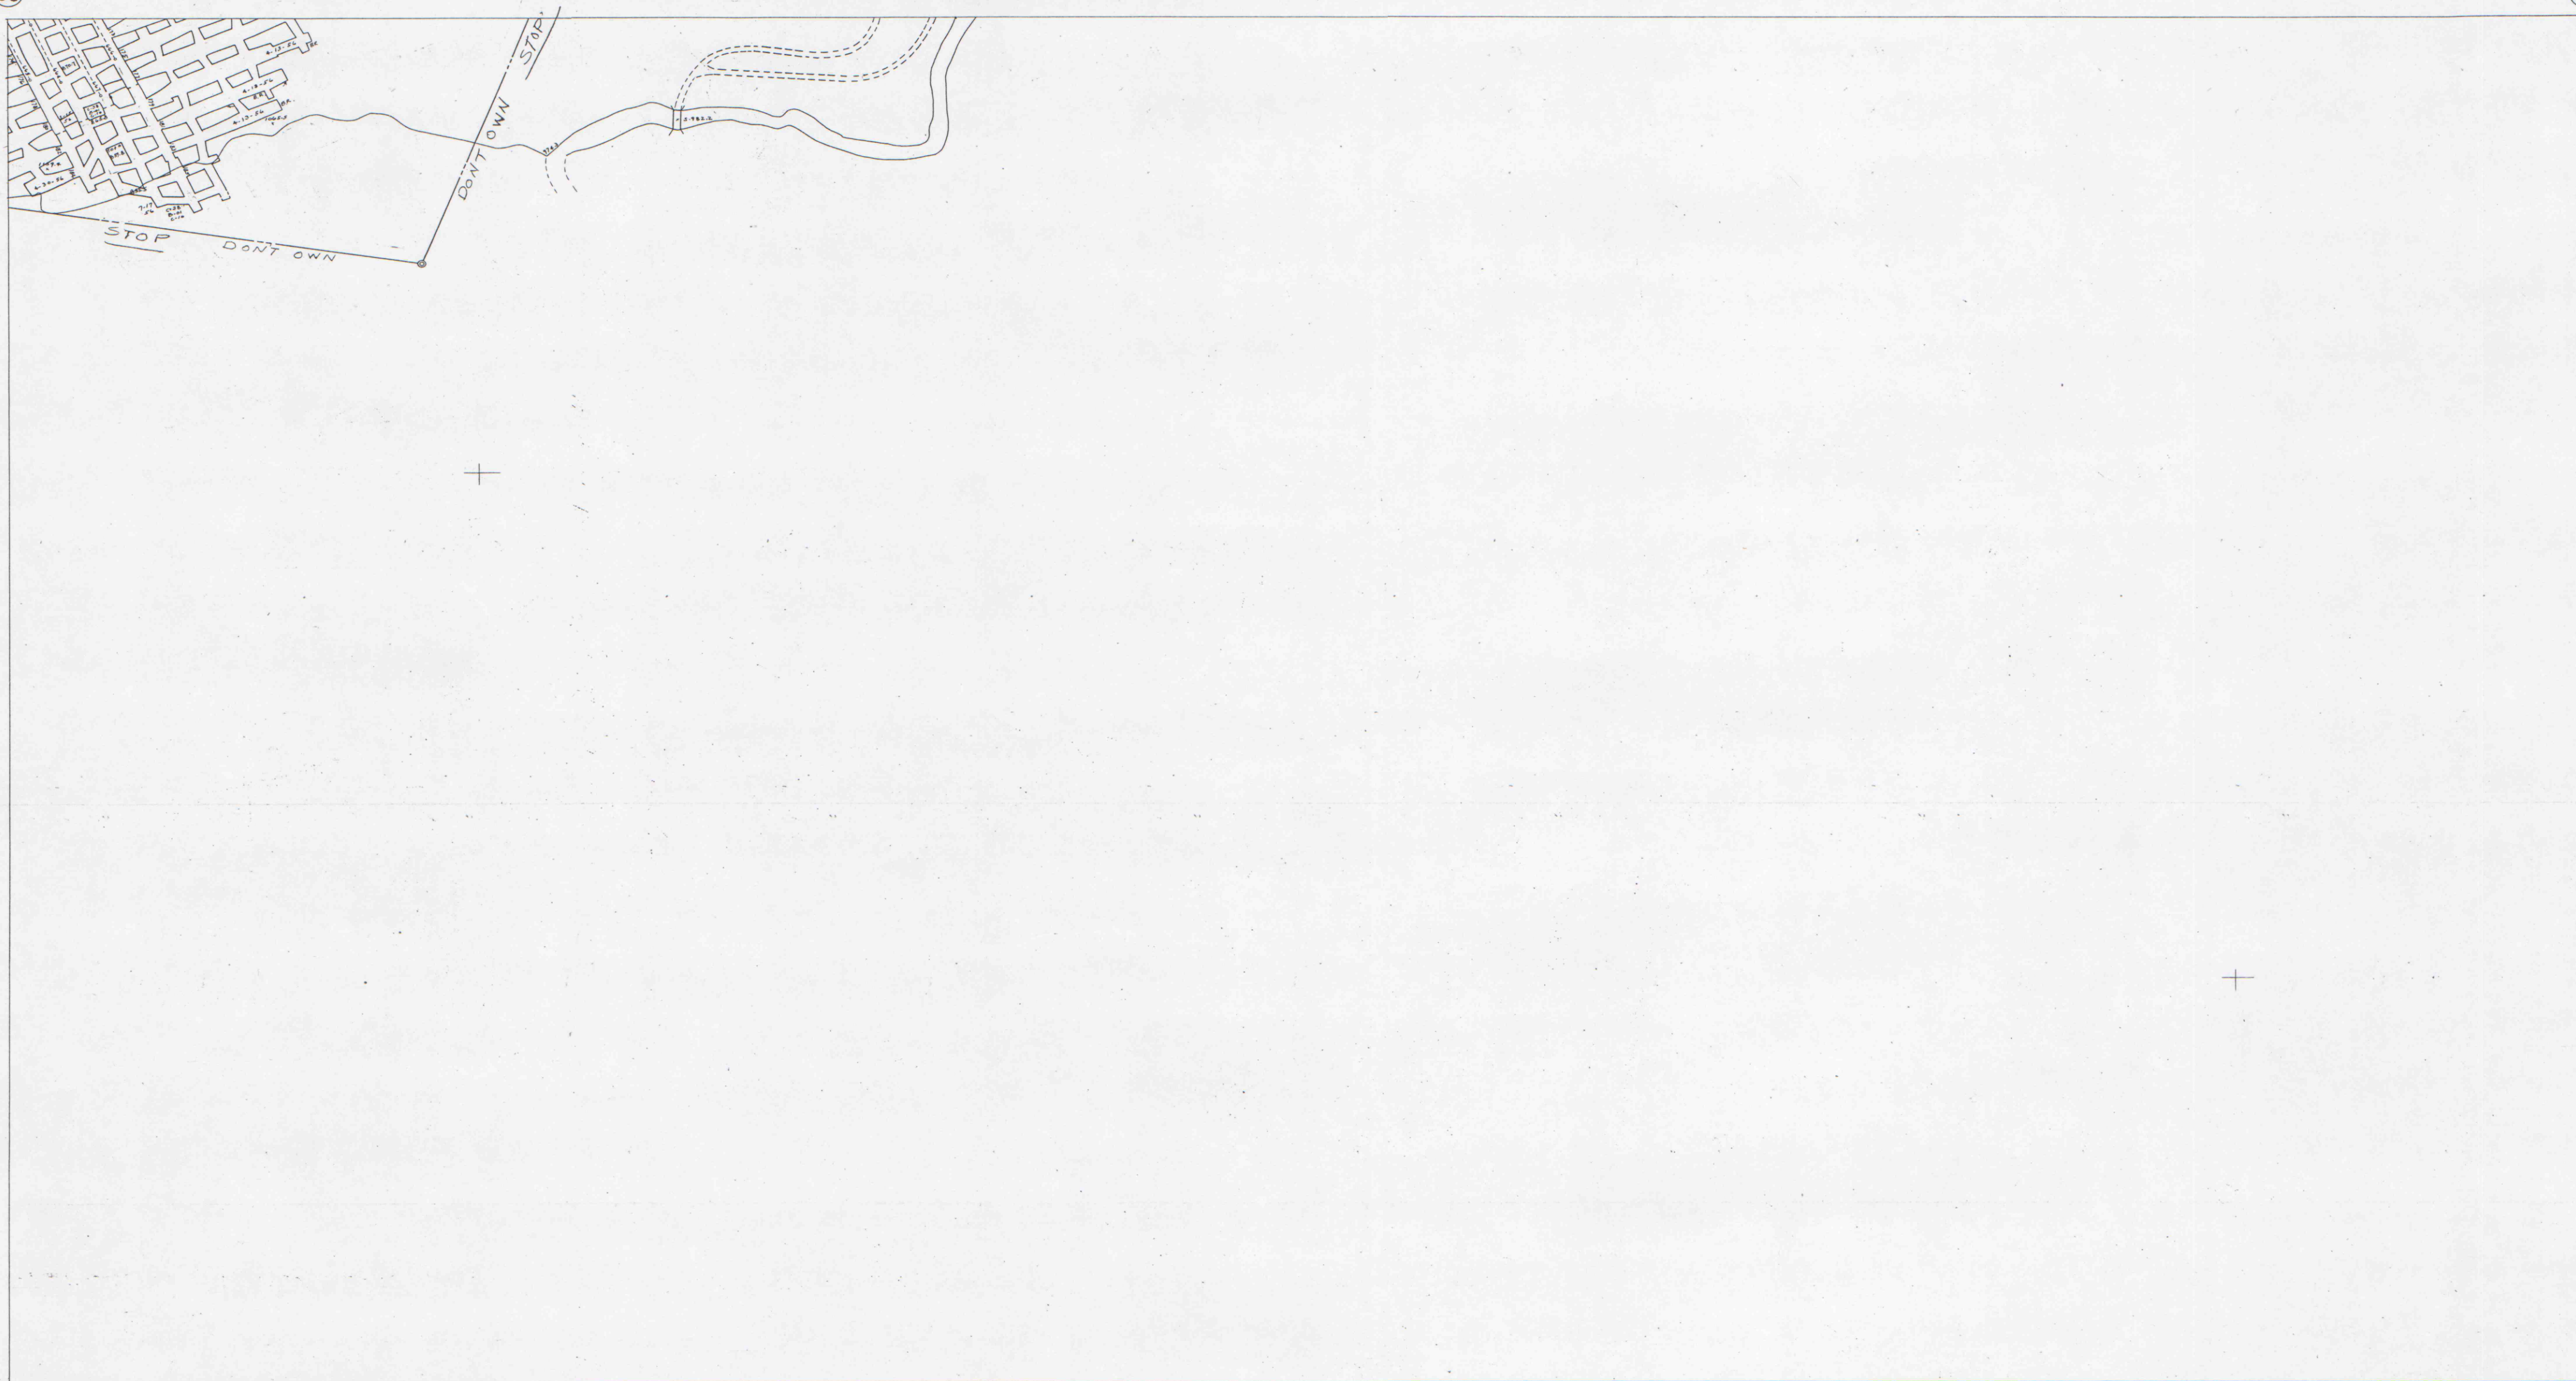

80

KENT E SEAM DRAWER 109 BASEMENT FILE

80

HELVETIA COAL COMPANY
CLARKSBURG, INDIANA COUNTY, PA.
Scale 1" = 200 Date 11-9-95

13205 BASEMENT 109