


8045-7

MICHAEL STOCK HEIRS

JOHN D. GARMAN TRACT

4,800 SQ. FT.
12-11 A.

HENRY LEIKERT TRACT

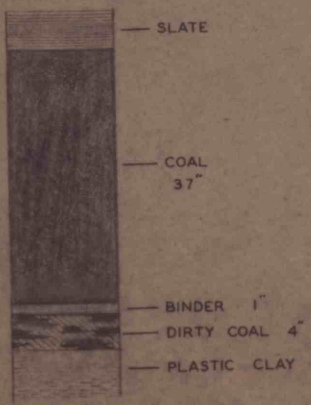

TYPICAL COAL SECTION

MAP OF THE
BERNINI MINE -
BURRELL TWP., INDIANA CO.
PREPARED FOR WALTER LYDA
SCALE 1"=100' JANUARY, 1949
THOMAS PEALER, REG. ENGR., LIC. 17

BOOK 2062

82 $\frac{3}{A}$

SEE REPORT OF JAN. 15, 1949

8045-68

8045-68