


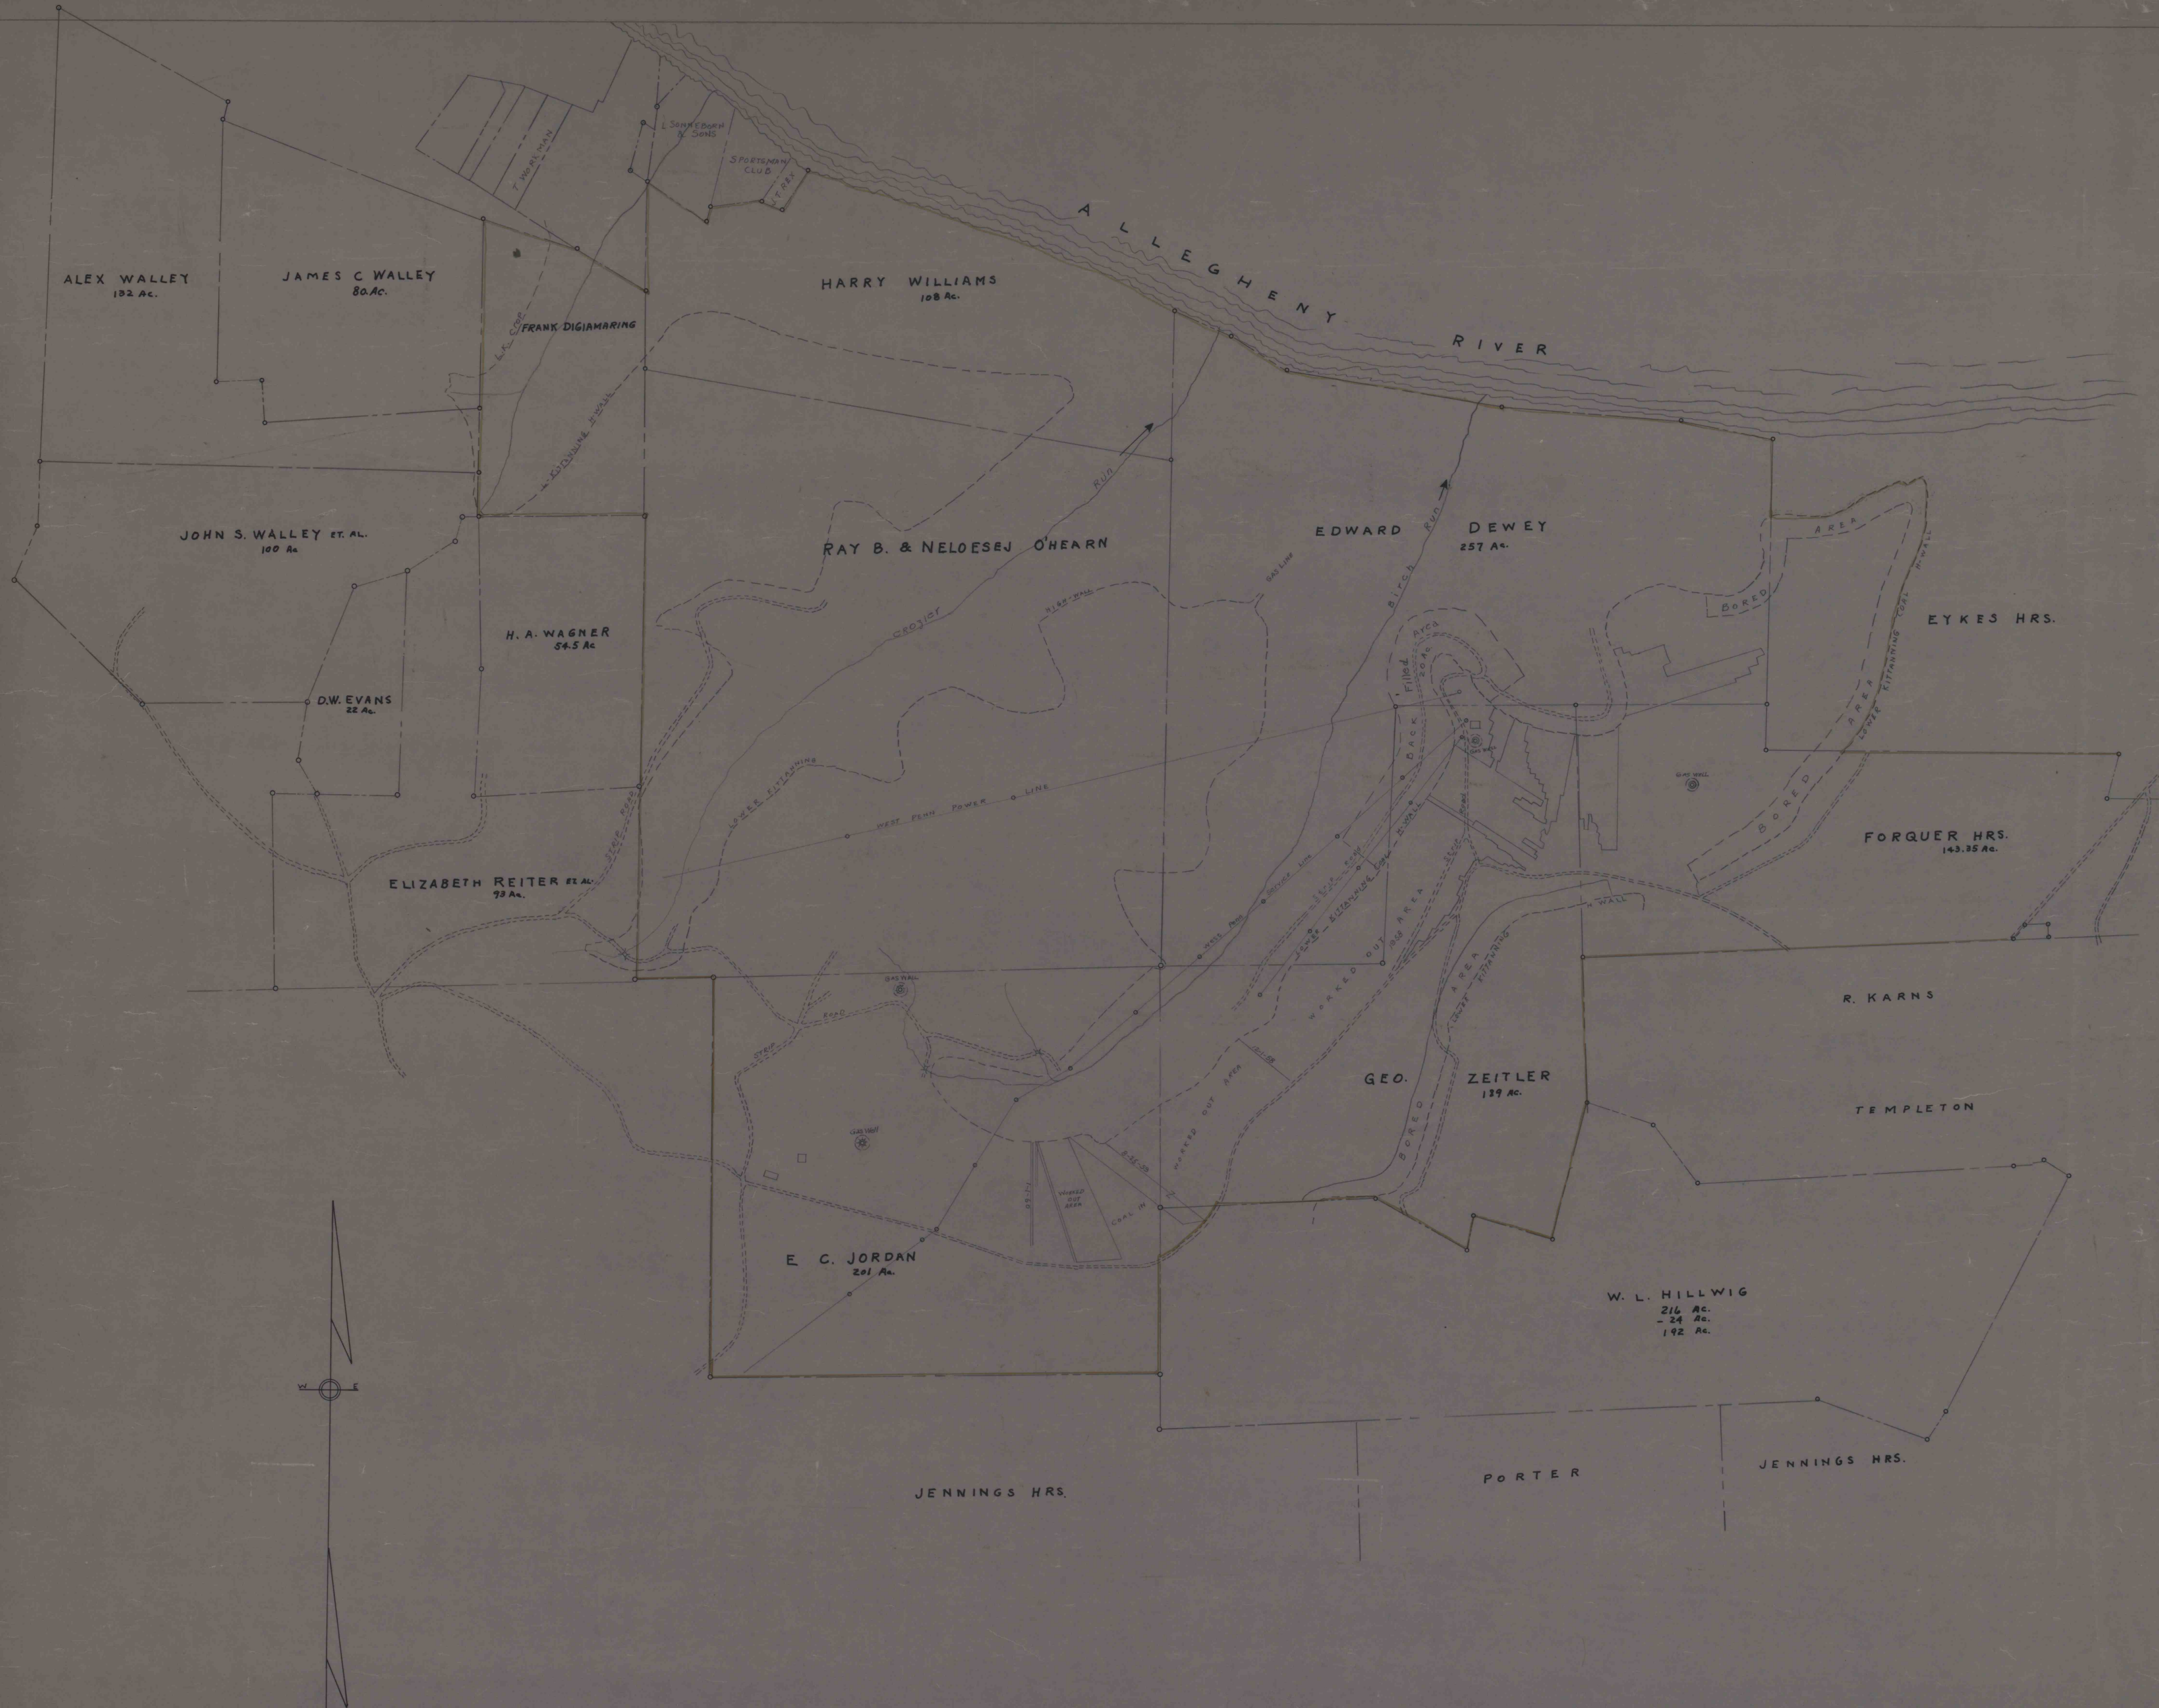

HARCLIFF COAL COMPANY
PERRY TWP. - ARMSTRONG CO. - PA.

MECHANICAL - HIGH-WALL MINING - LOWER-KITTANNING COAL SEAM
SCALE 1" = 400' DATE 1958 - EXTENDED - 1-1-1960
R. L. Pfaff, Reg. Eng. 9785 COAL LEASED - ☐