


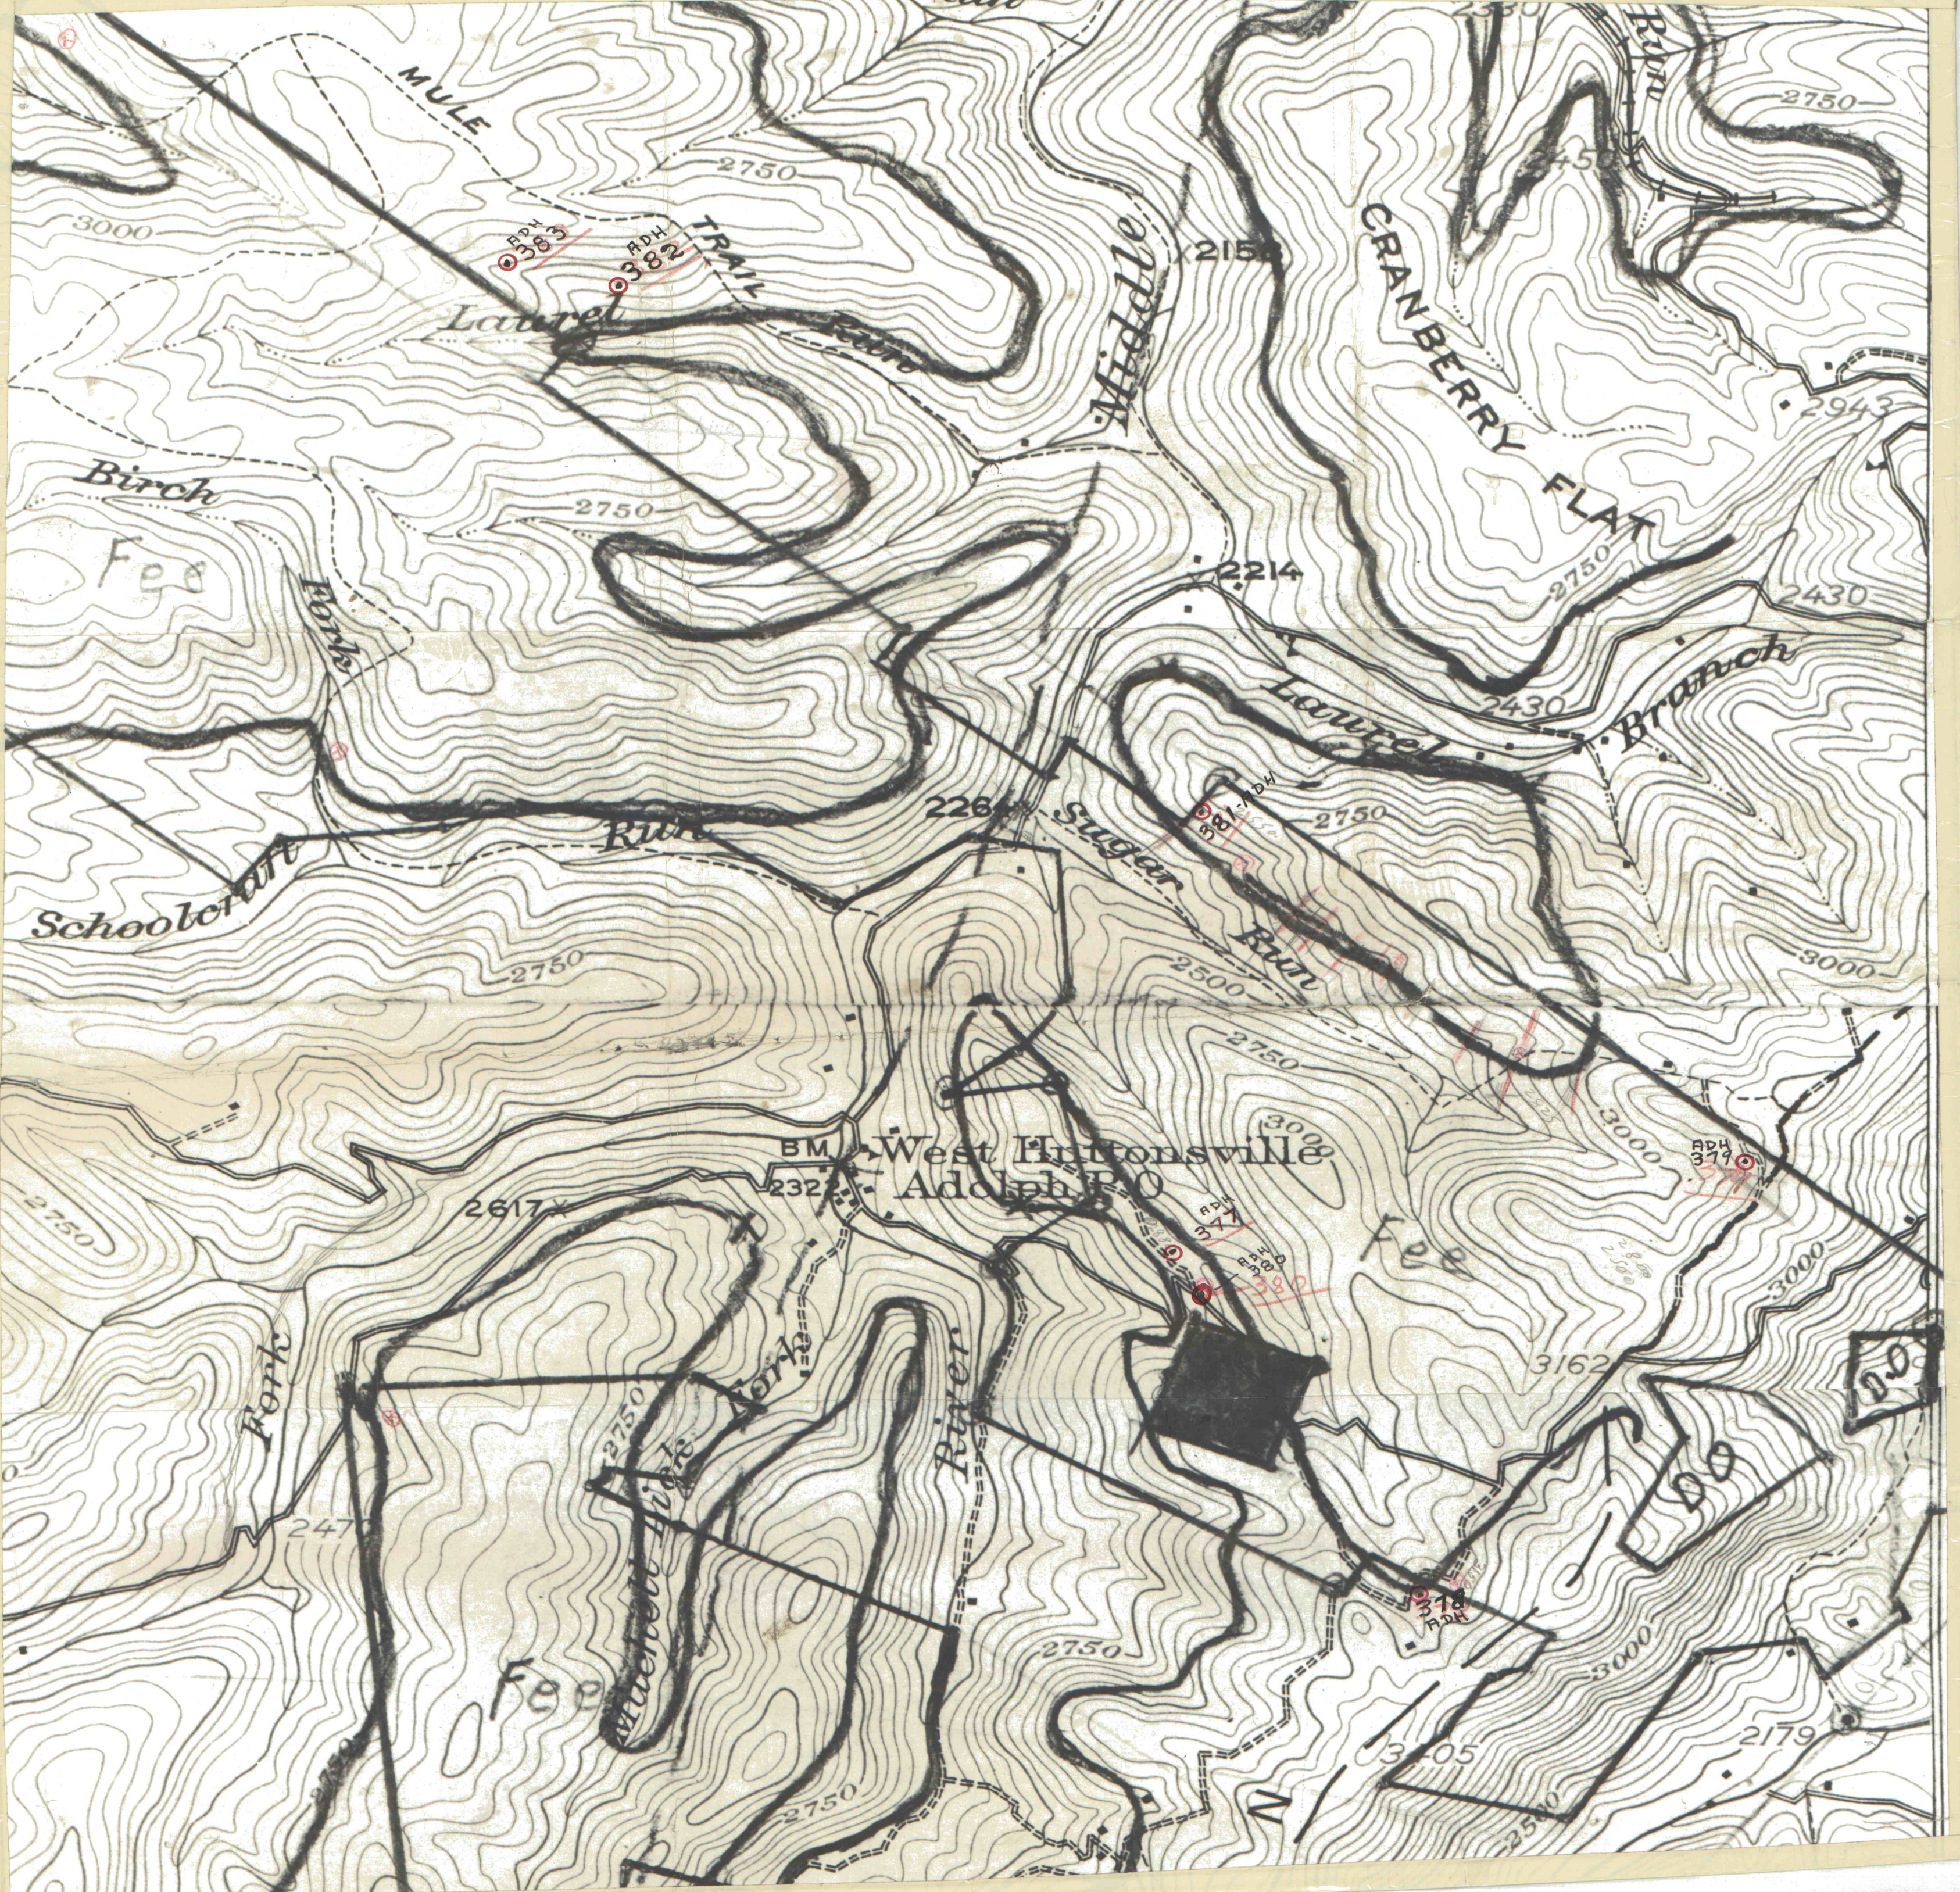

MULE

2750

ADH 383
ADH 382

TRAIL

Laurel

Middle

2150

CRANBERRY

FLAT

2750

2943

Birch

Fee

2750

2214

2750

2430

2430

Branch

Laurel

2264

Sugar

ADH 381

2750

Run

2750

Run

Schoolcraft

Fork

2617

BM 2322

West Huttonsville
Adolph P.O.

ADH 377

3000

ADH 379

3000

3000

3162

Fork


River

2750

Fee

3105

2179

N