


49-EE/4

MATCH LINE

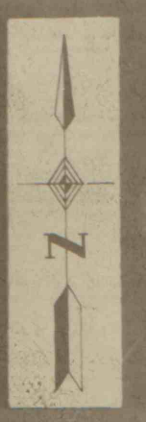

2



REVISED - 7-26-49
BY - 3-20-50
BY - 7-7-51

STRONG QUALITY COAL CO.
PLUMCREEK TOWNSHIP
ARMSTRONG CO. PENNA.
SURVEYED 7-26-49
BY HARRY W. MIKESSELL, R.P.S.

PDVMS

03046 330 29X 316631