



433-68

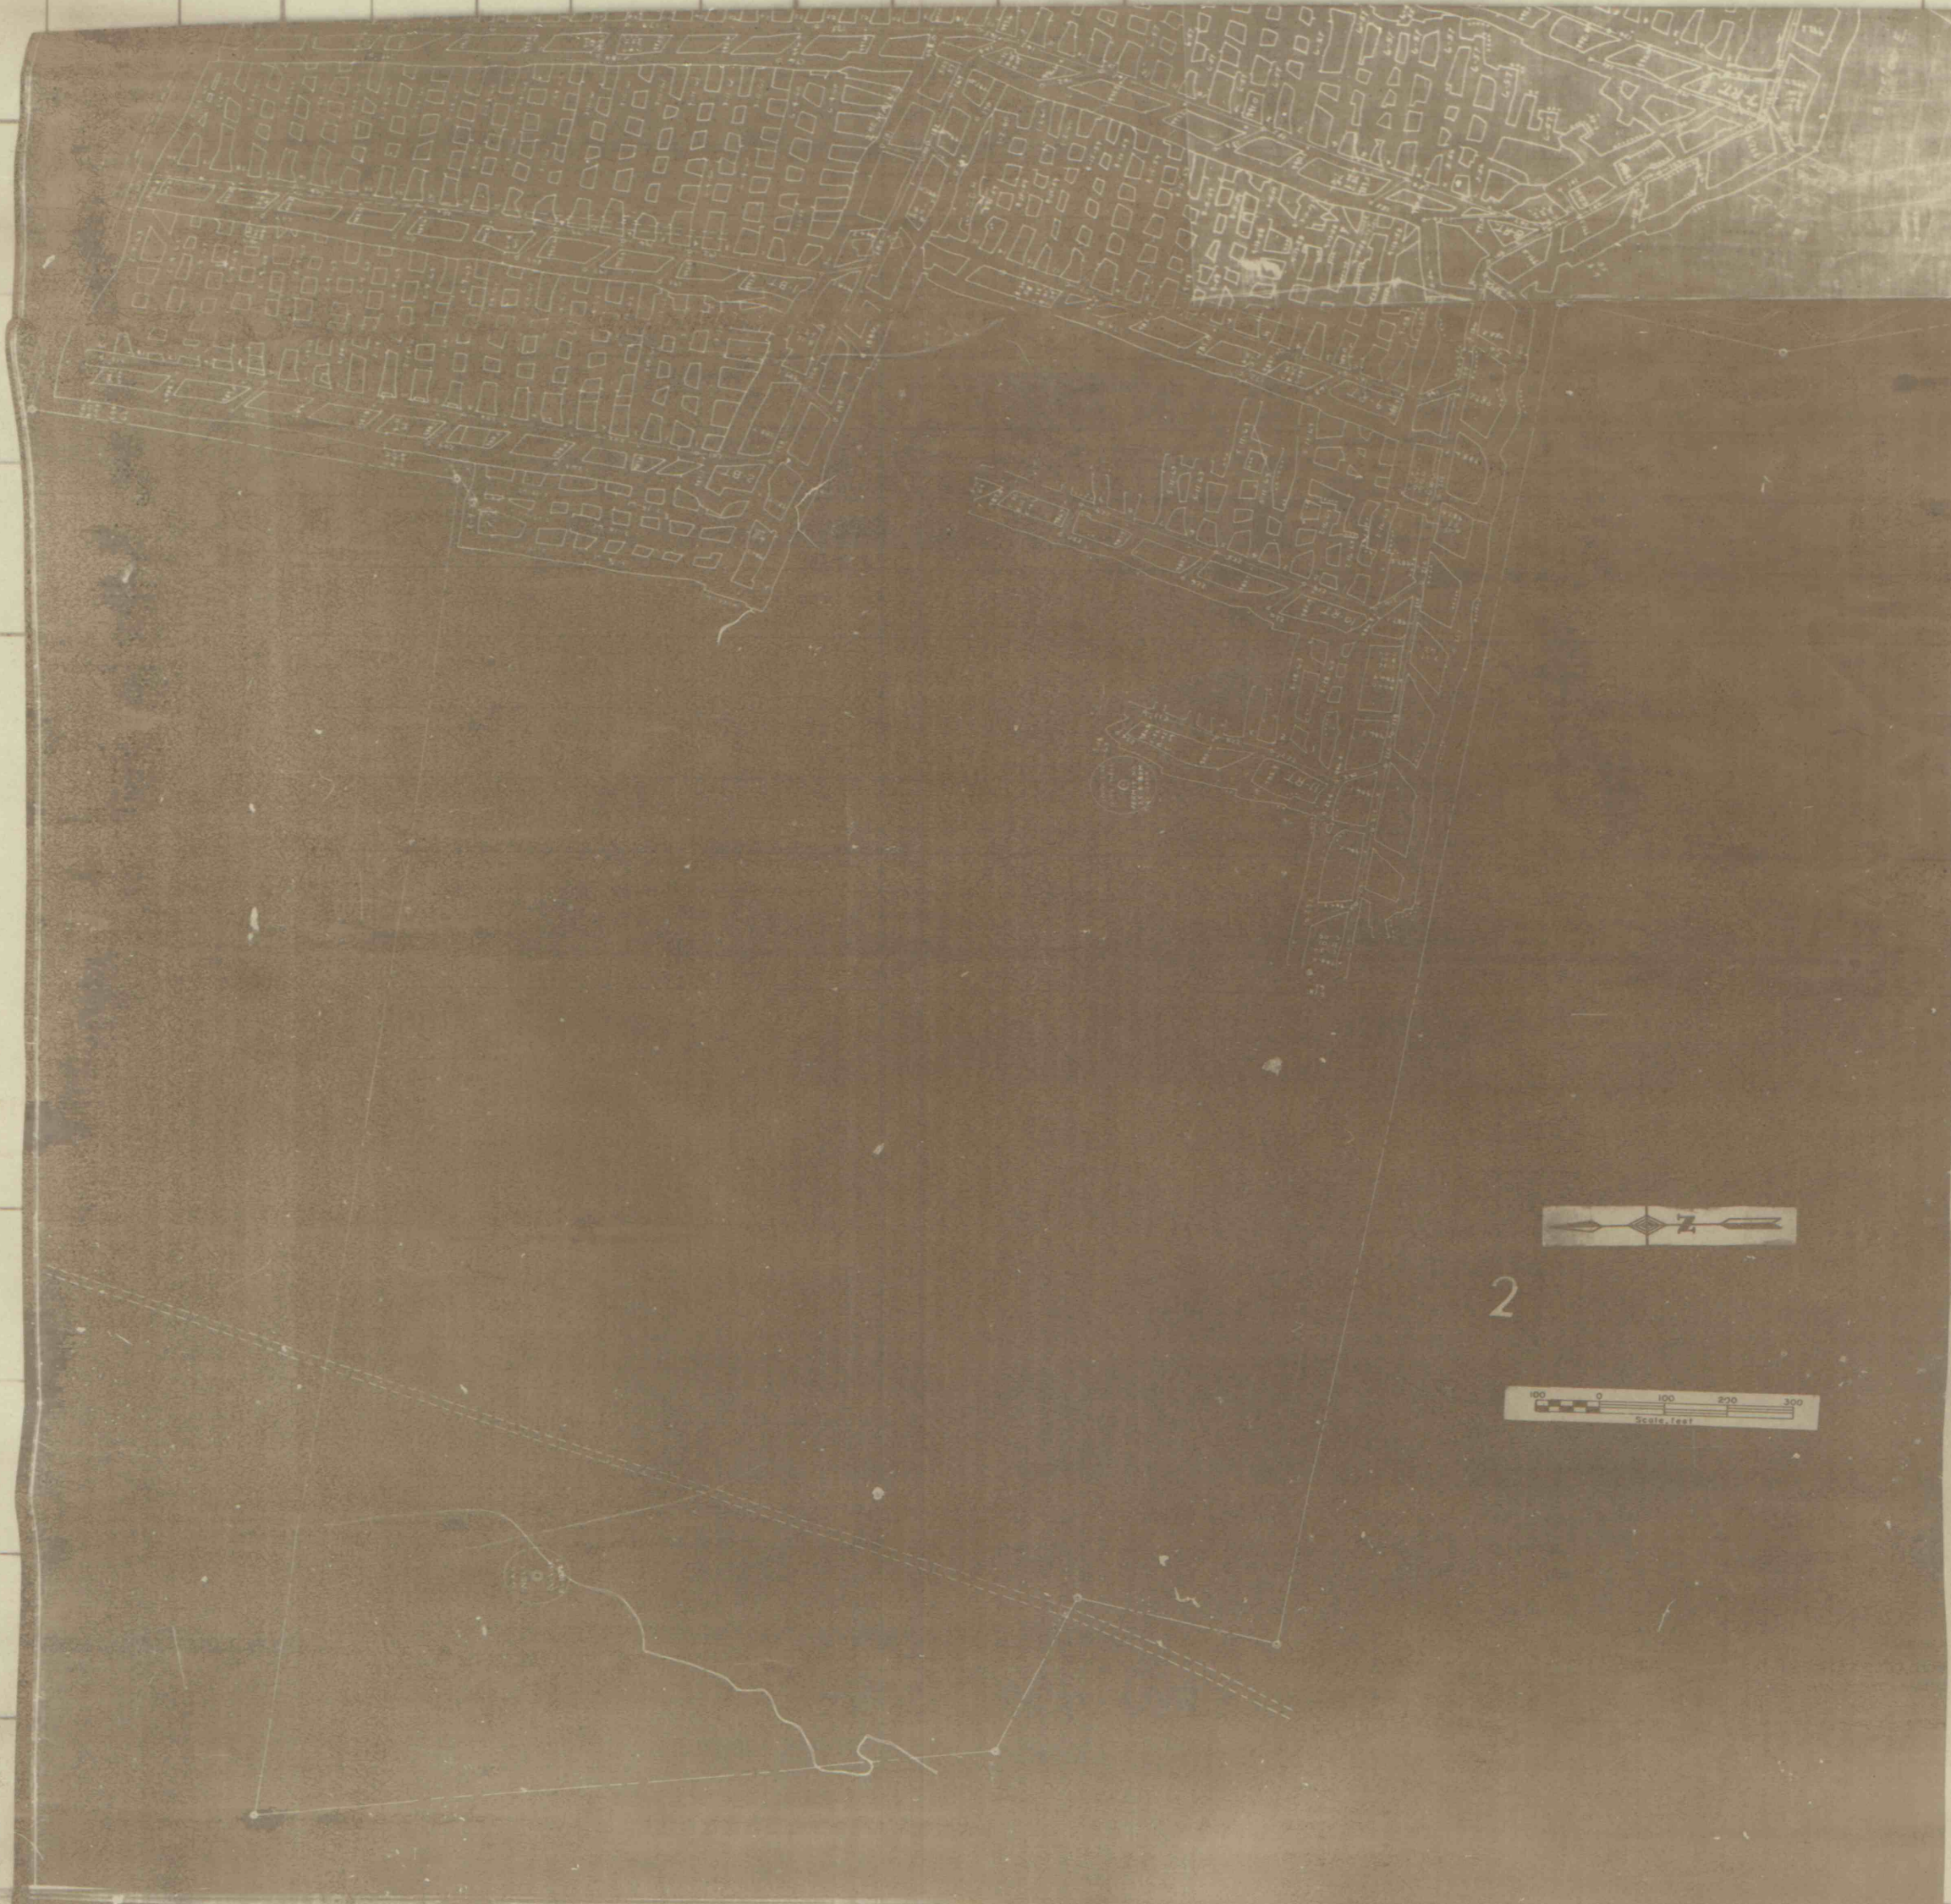

2

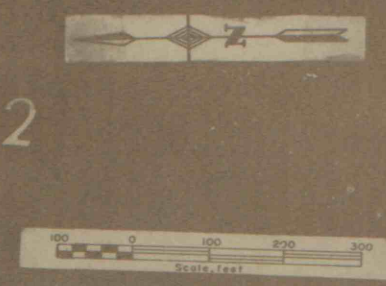

03156 383 36X 357824

28 26 24 22 20 18 16 14 12 10 8 8 10 12 14 16 18 20 22 24 26 28 30