
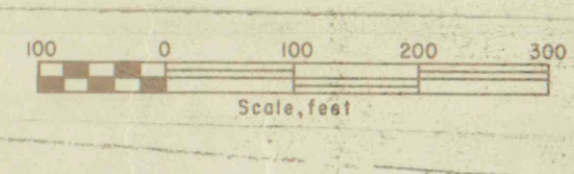


A/33-65

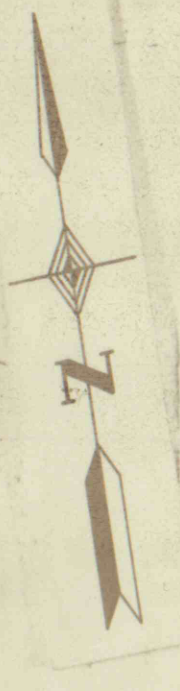

MAP OF  
VINE OPERATED BY  
LESTER WALKER  
5 ACRES IN  
Surveyed Jan. 30, 1954 By J.C. Brown  
Scale: 1" = 100'

|         |          |
|---------|----------|
| REVISED | 7-23-55  |
| "       | 5-12-56  |
| "       | 5-6-57   |
| "       | 5-20-58  |
| "       | 4-14-60  |
| "       | 5-13-61  |
| "       | 3-24-62  |
| "       | 3-10-63  |
| "       | 3-13-64  |
| "       | 10-30-65 |

PDVMS

03046 333 19X 316633