


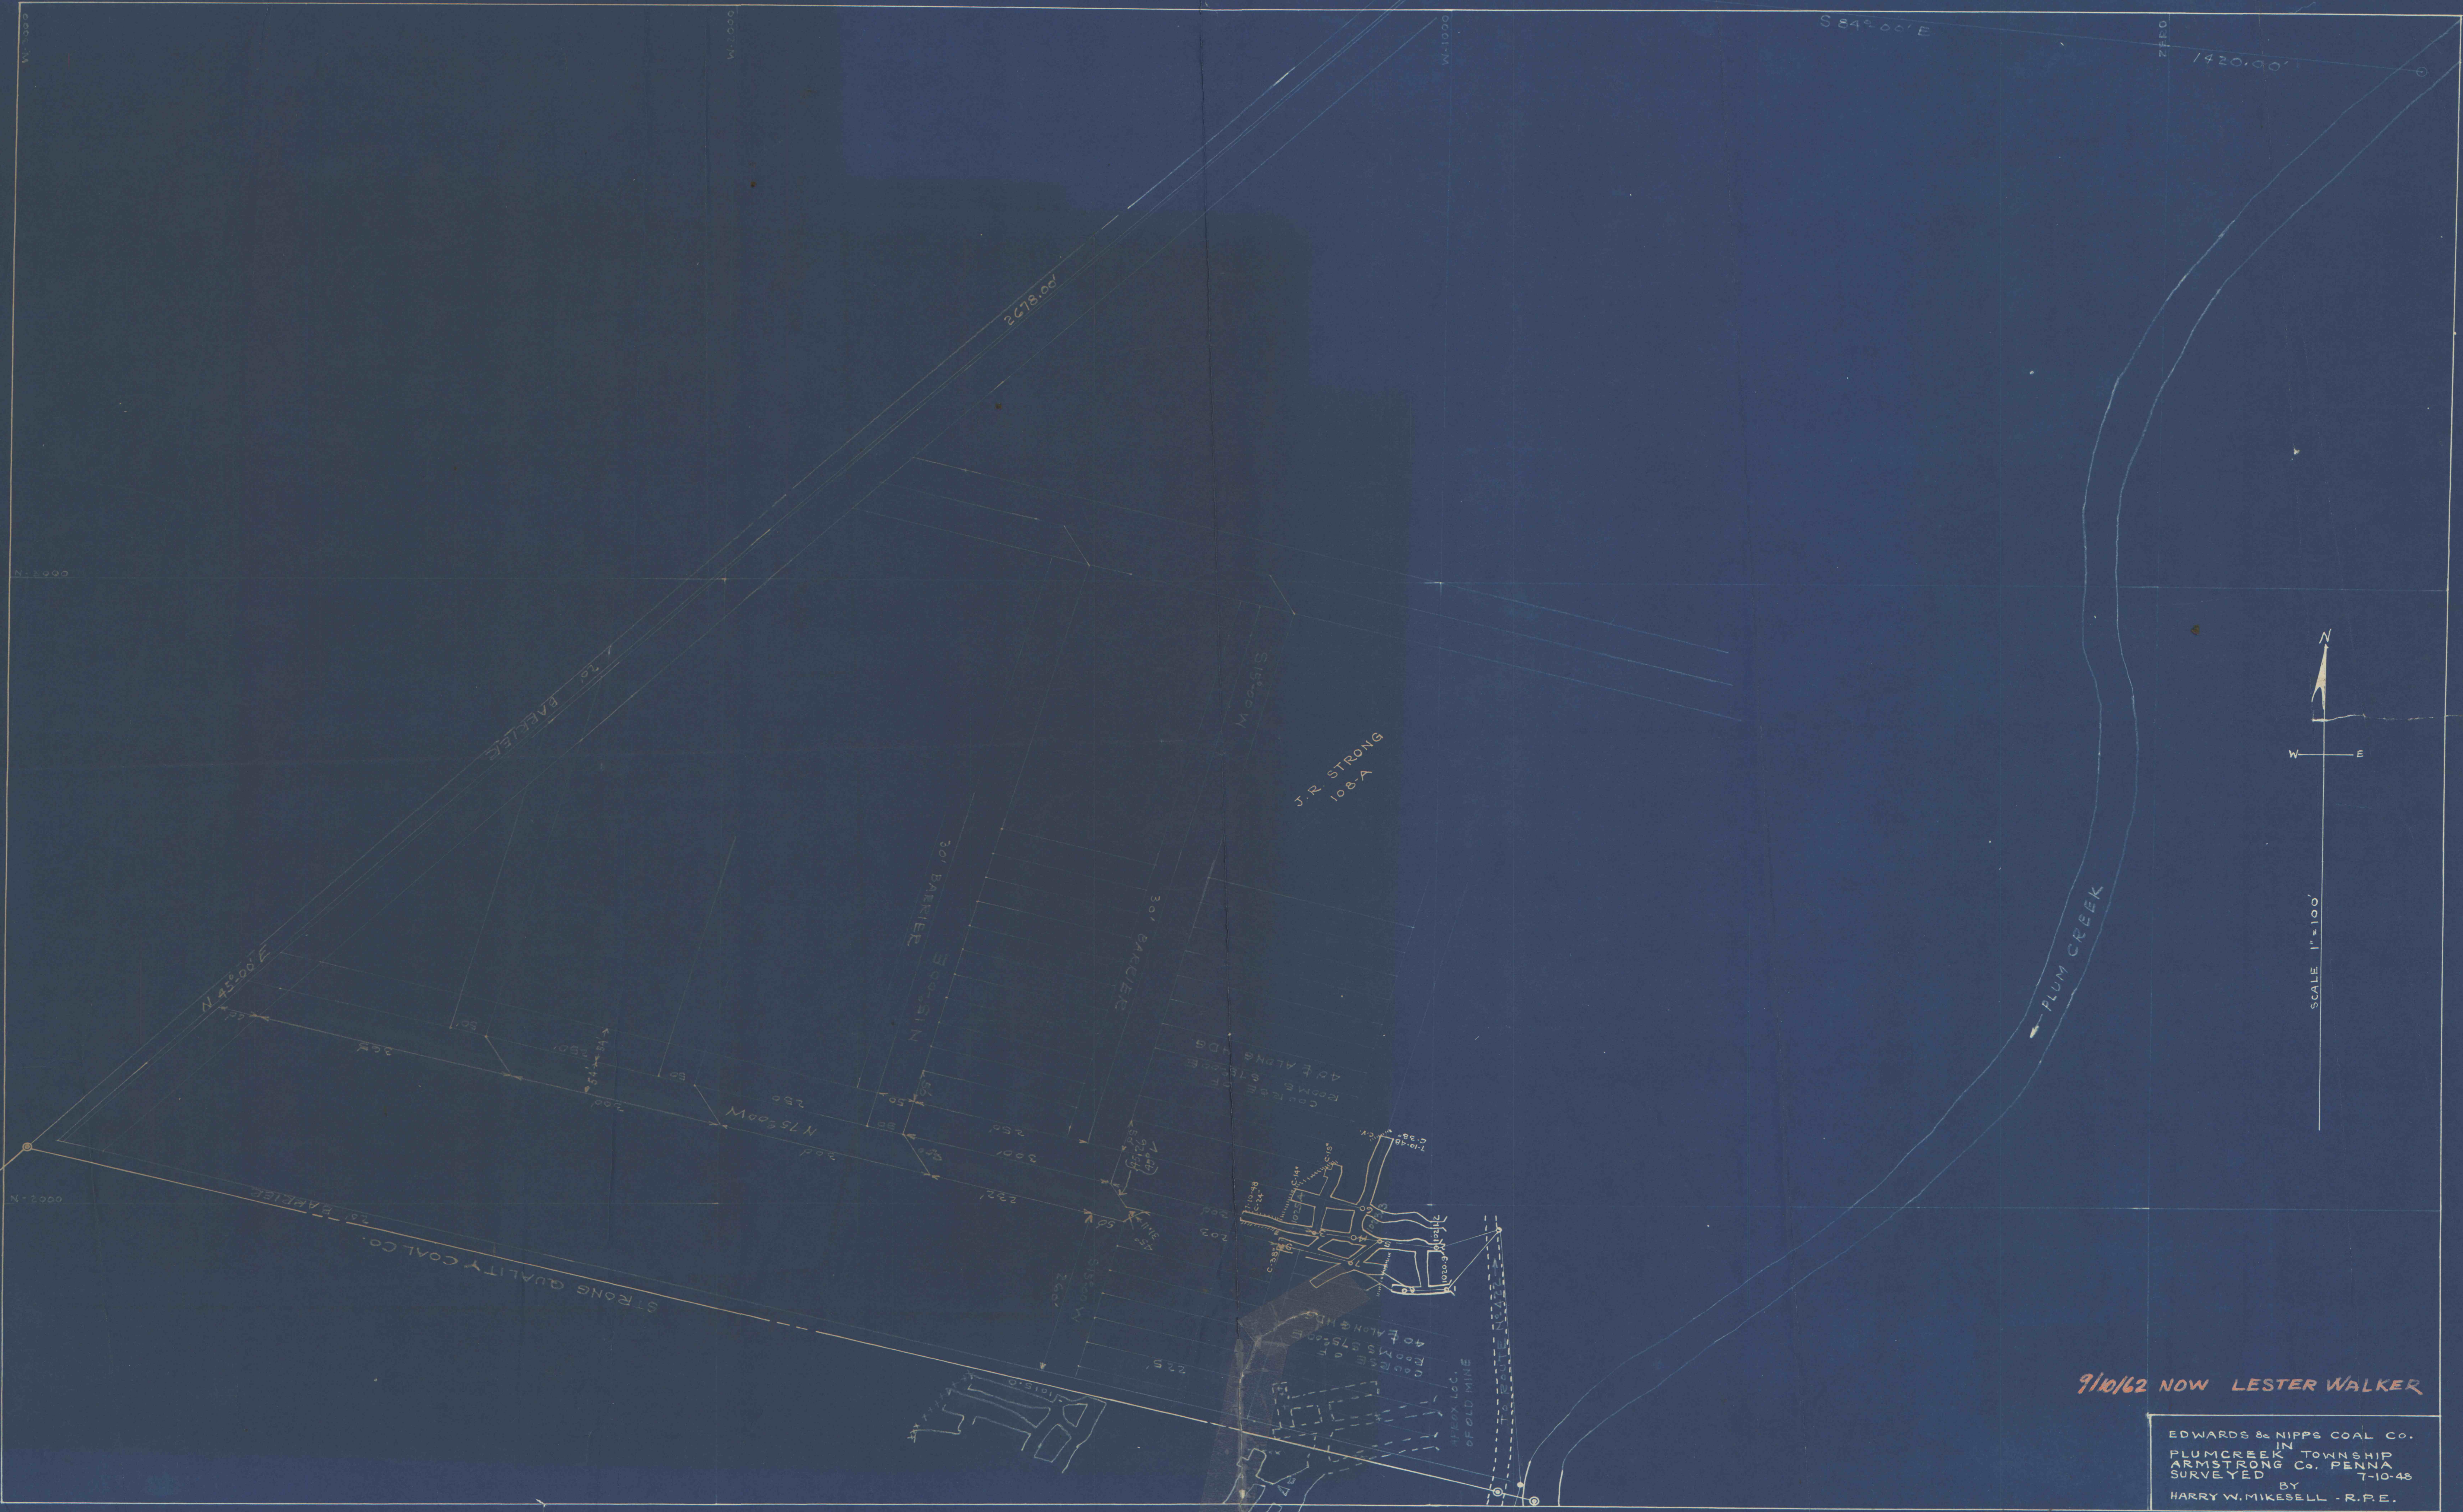

9/10/62 NOW LESTER WALKER

EDWARDS & NIPPS COAL CO.
IN
PLUMCREEK TOWNSHIP
ARMSTRONG CO. PENNA
SURVEYED 7-10-48
BY
HARRY W. MIKESELL - R.P.E.

4133-68