


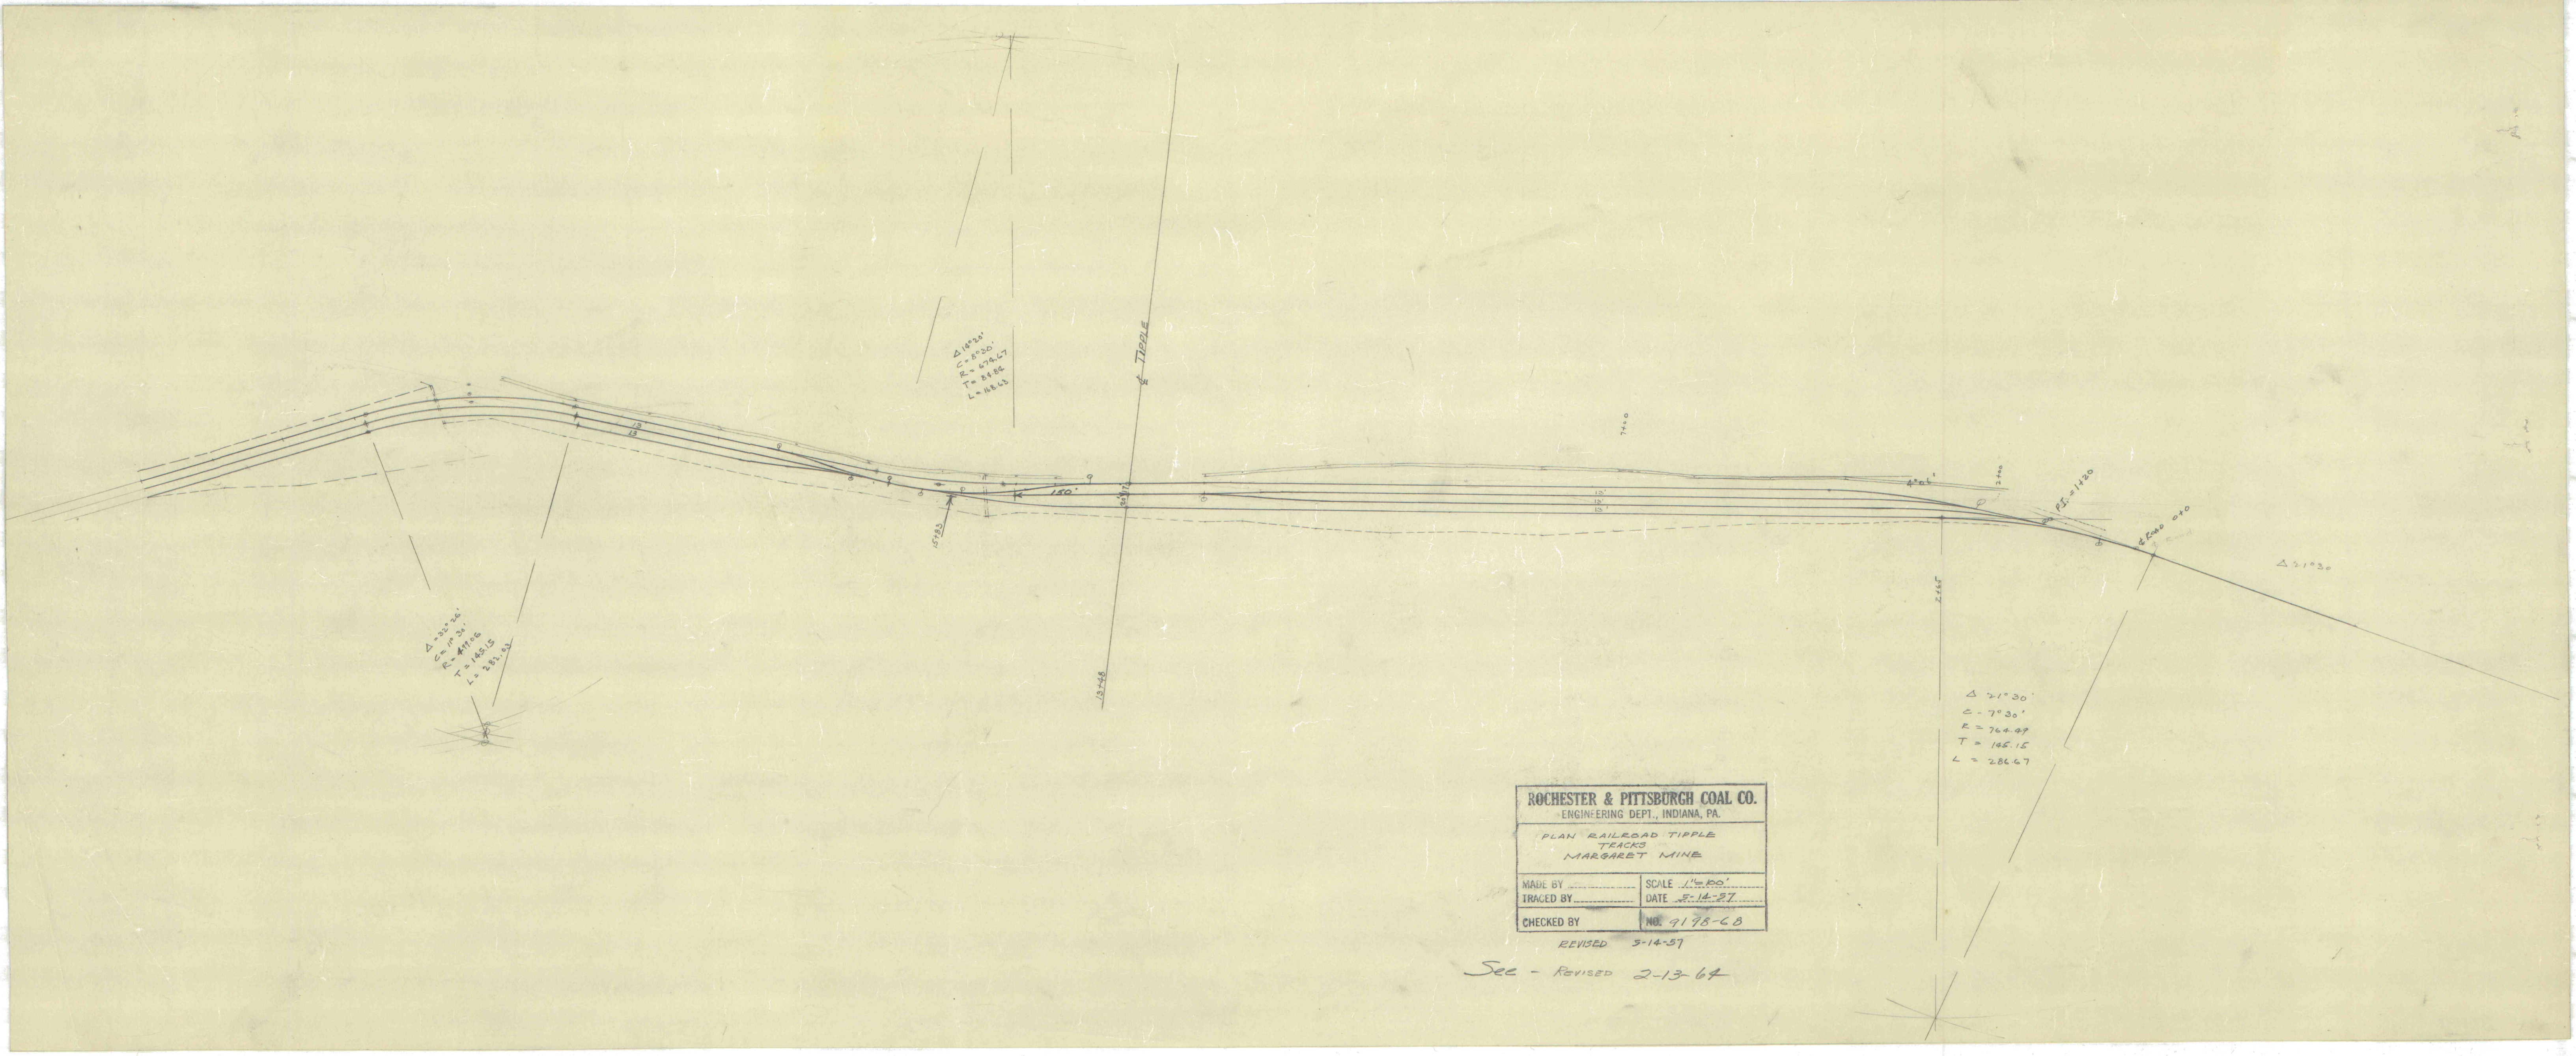

$\Delta 32^{\circ} 26'$
 $C = 110.31$
 $R = 471.08$
 $T = 145.15$
 $L = 281.83$

$\Delta 14^{\circ} 20'$
 $C = 80.20$
 $R = 670.67$
 $T = 84.88$
 $L = 148.65$

$\Delta 21^{\circ} 30'$
 $C = 70.30$
 $R = 764.49$
 $T = 145.15$
 $L = 286.67$

ROCHESTER & PITTSBURGH COAL CO.	
ENGINEERING DEPT., INDIANA, PA.	
PLAN RAILROAD TIPPLE	
TRACKS	
MARGARET MINE	
MADE BY	SCALE 1"=100'
TRACED BY	DATE 5-14-57
CHECKED BY	NO. 9198-68

REVISED 5-14-57
Sec - REVISED 2-13-64