


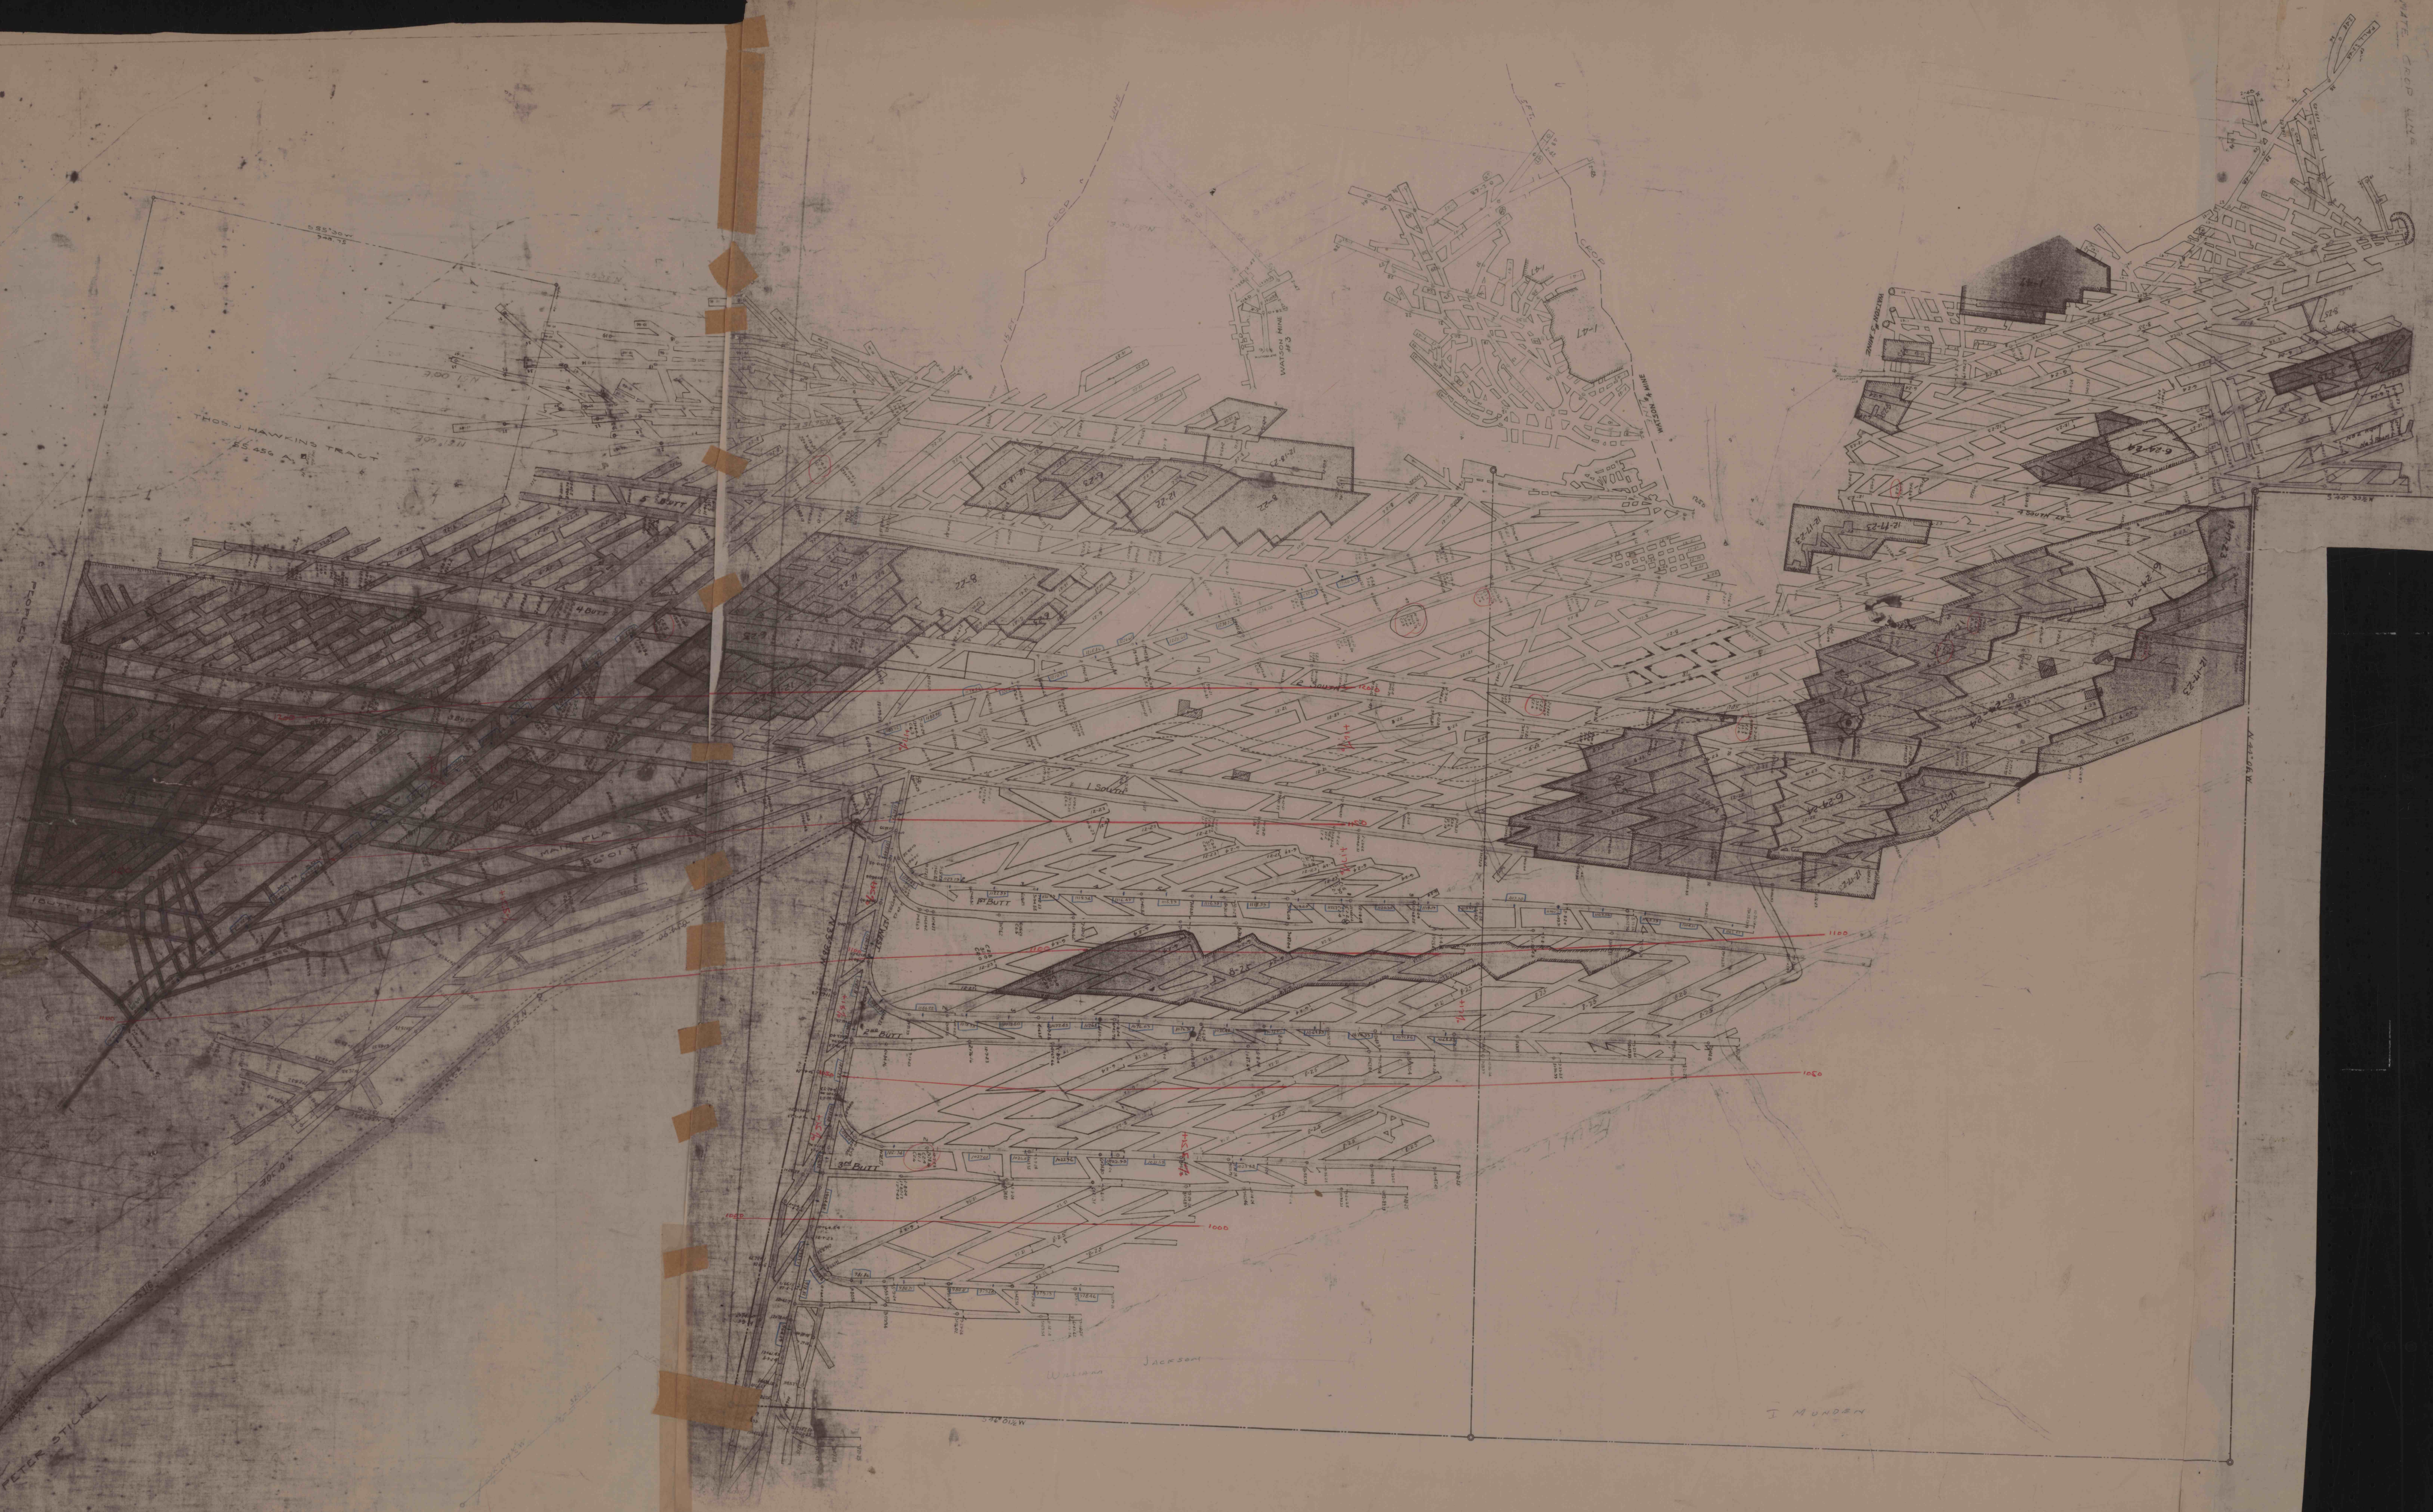

RIOGE COAL COMPANY

Recd from Geo. Lee - 1920