


87 9643-7

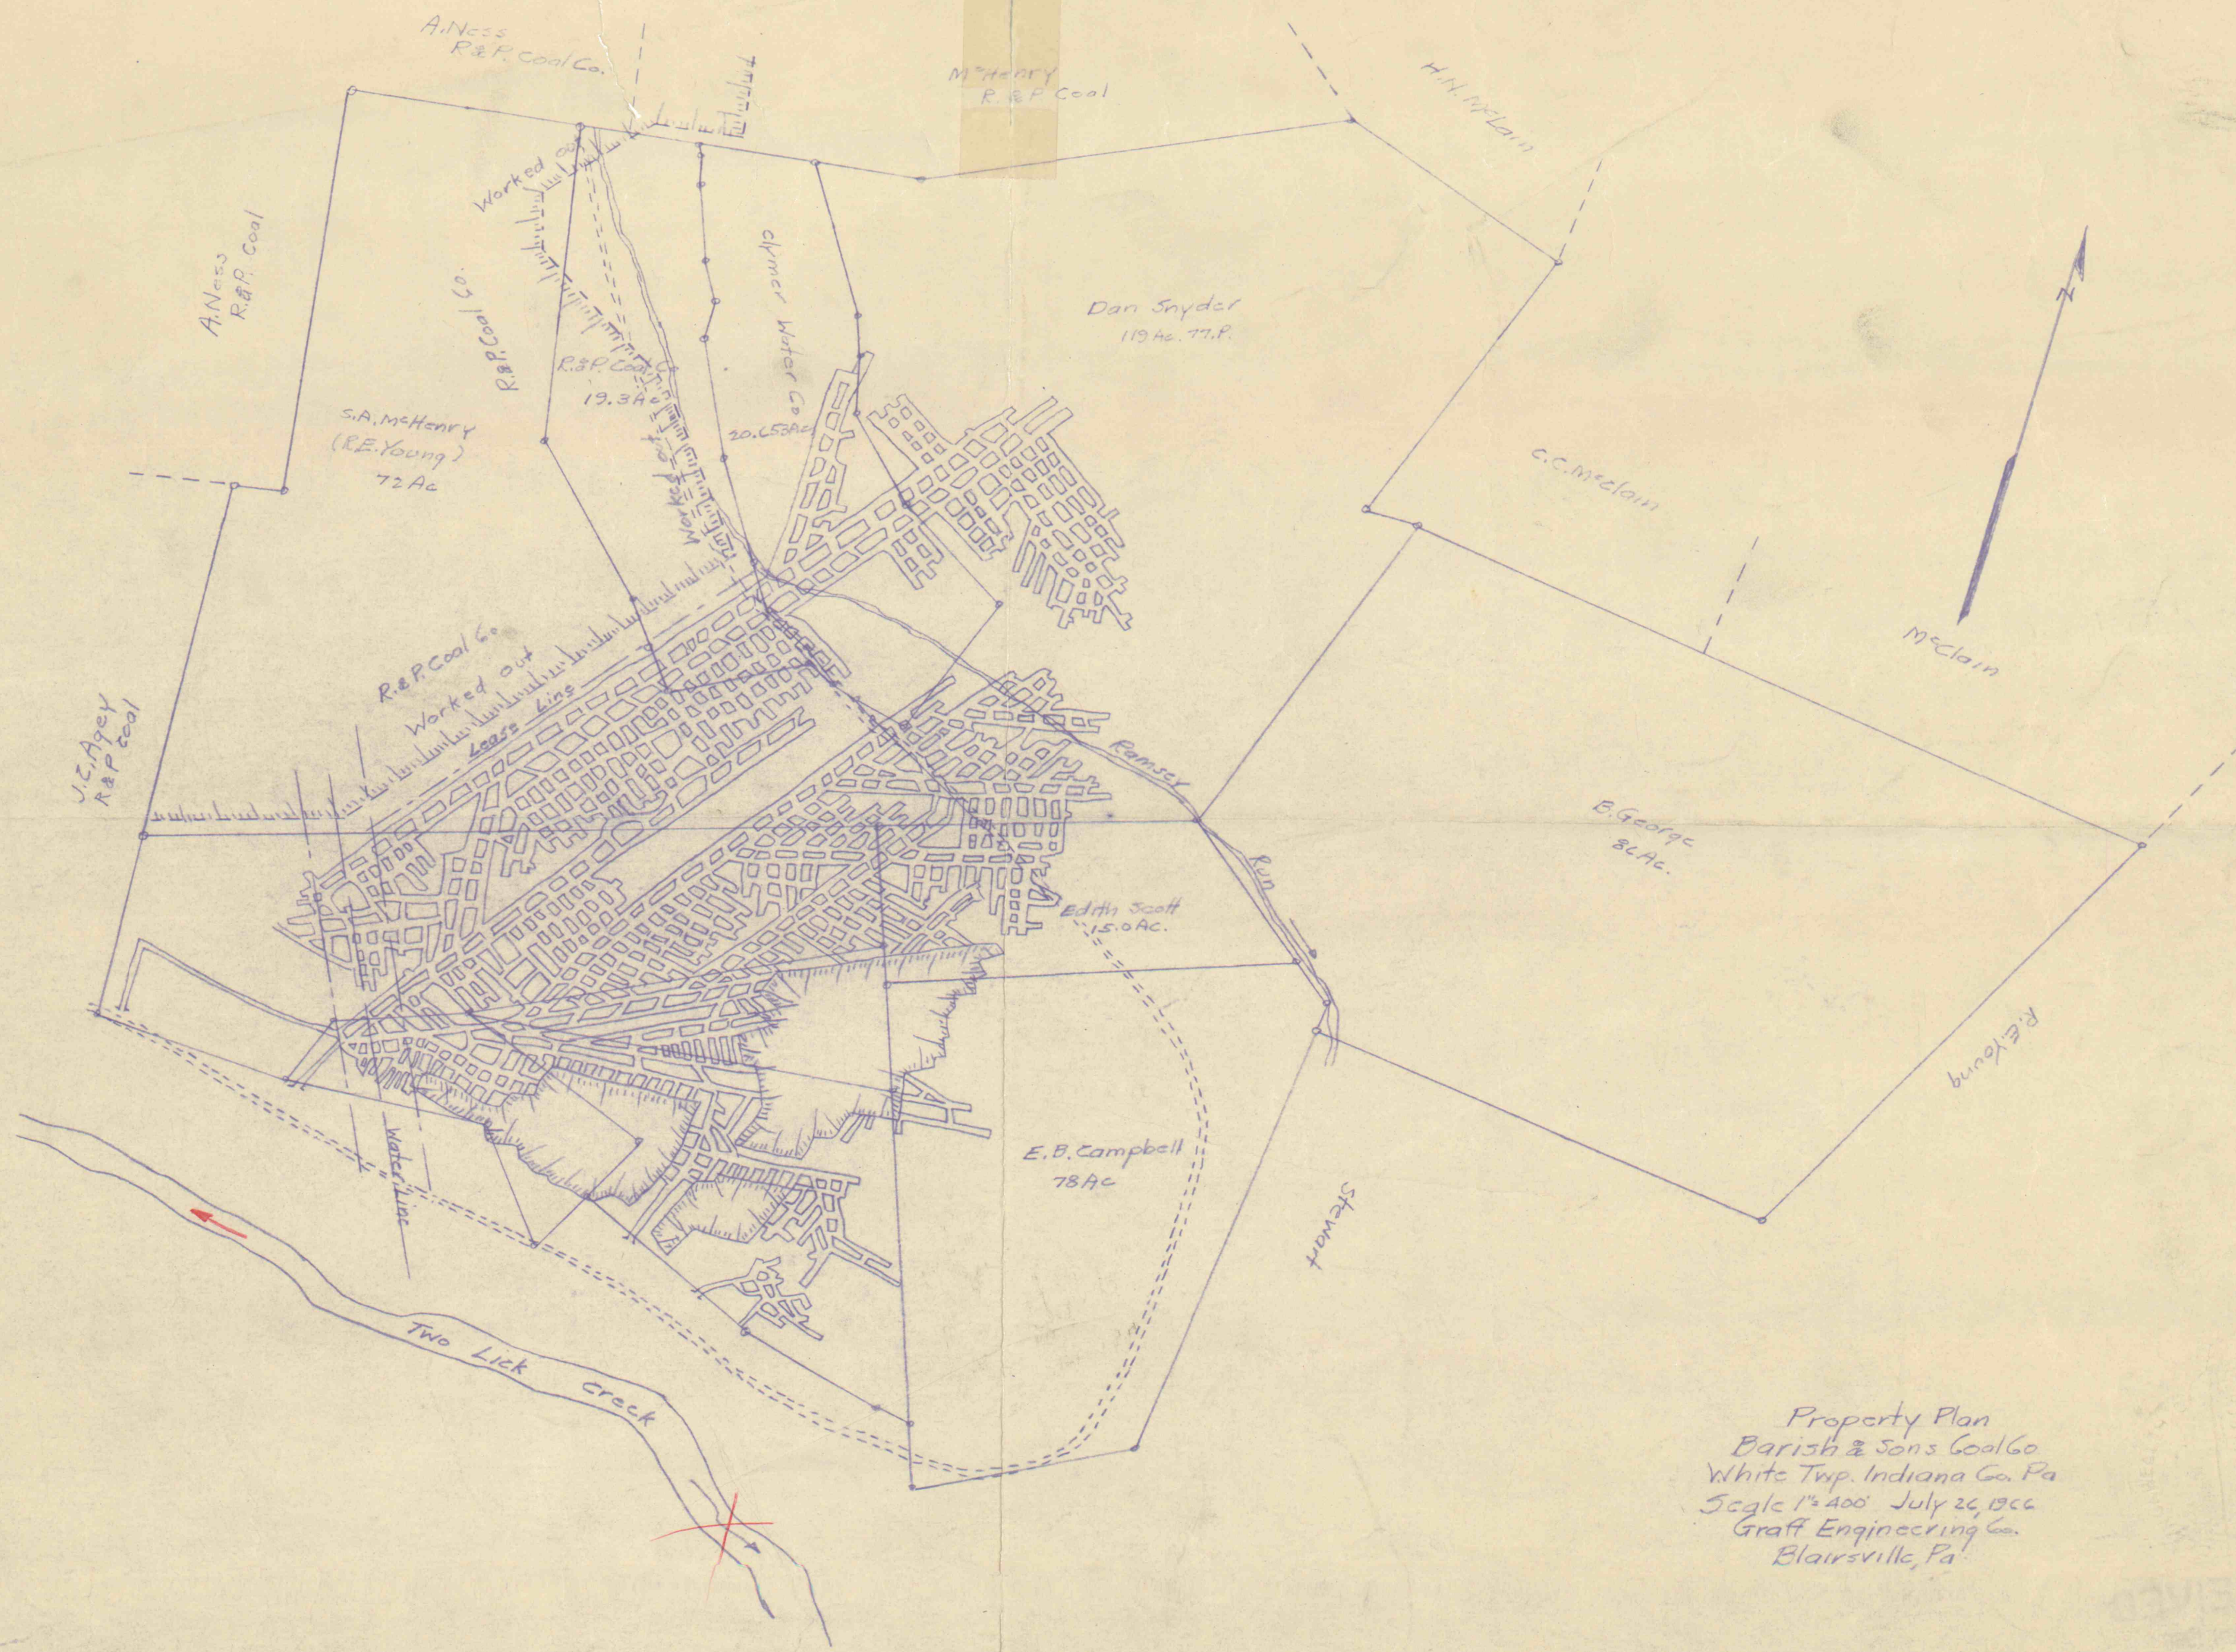

Property Plan
Barish & Sons Coal Co.
White Twp. Indiana Co. Pa.
Scale 1" = 400' July 26, 1906
Graft Engineering Co.
Blairsville, Pa.

9643-7 68